


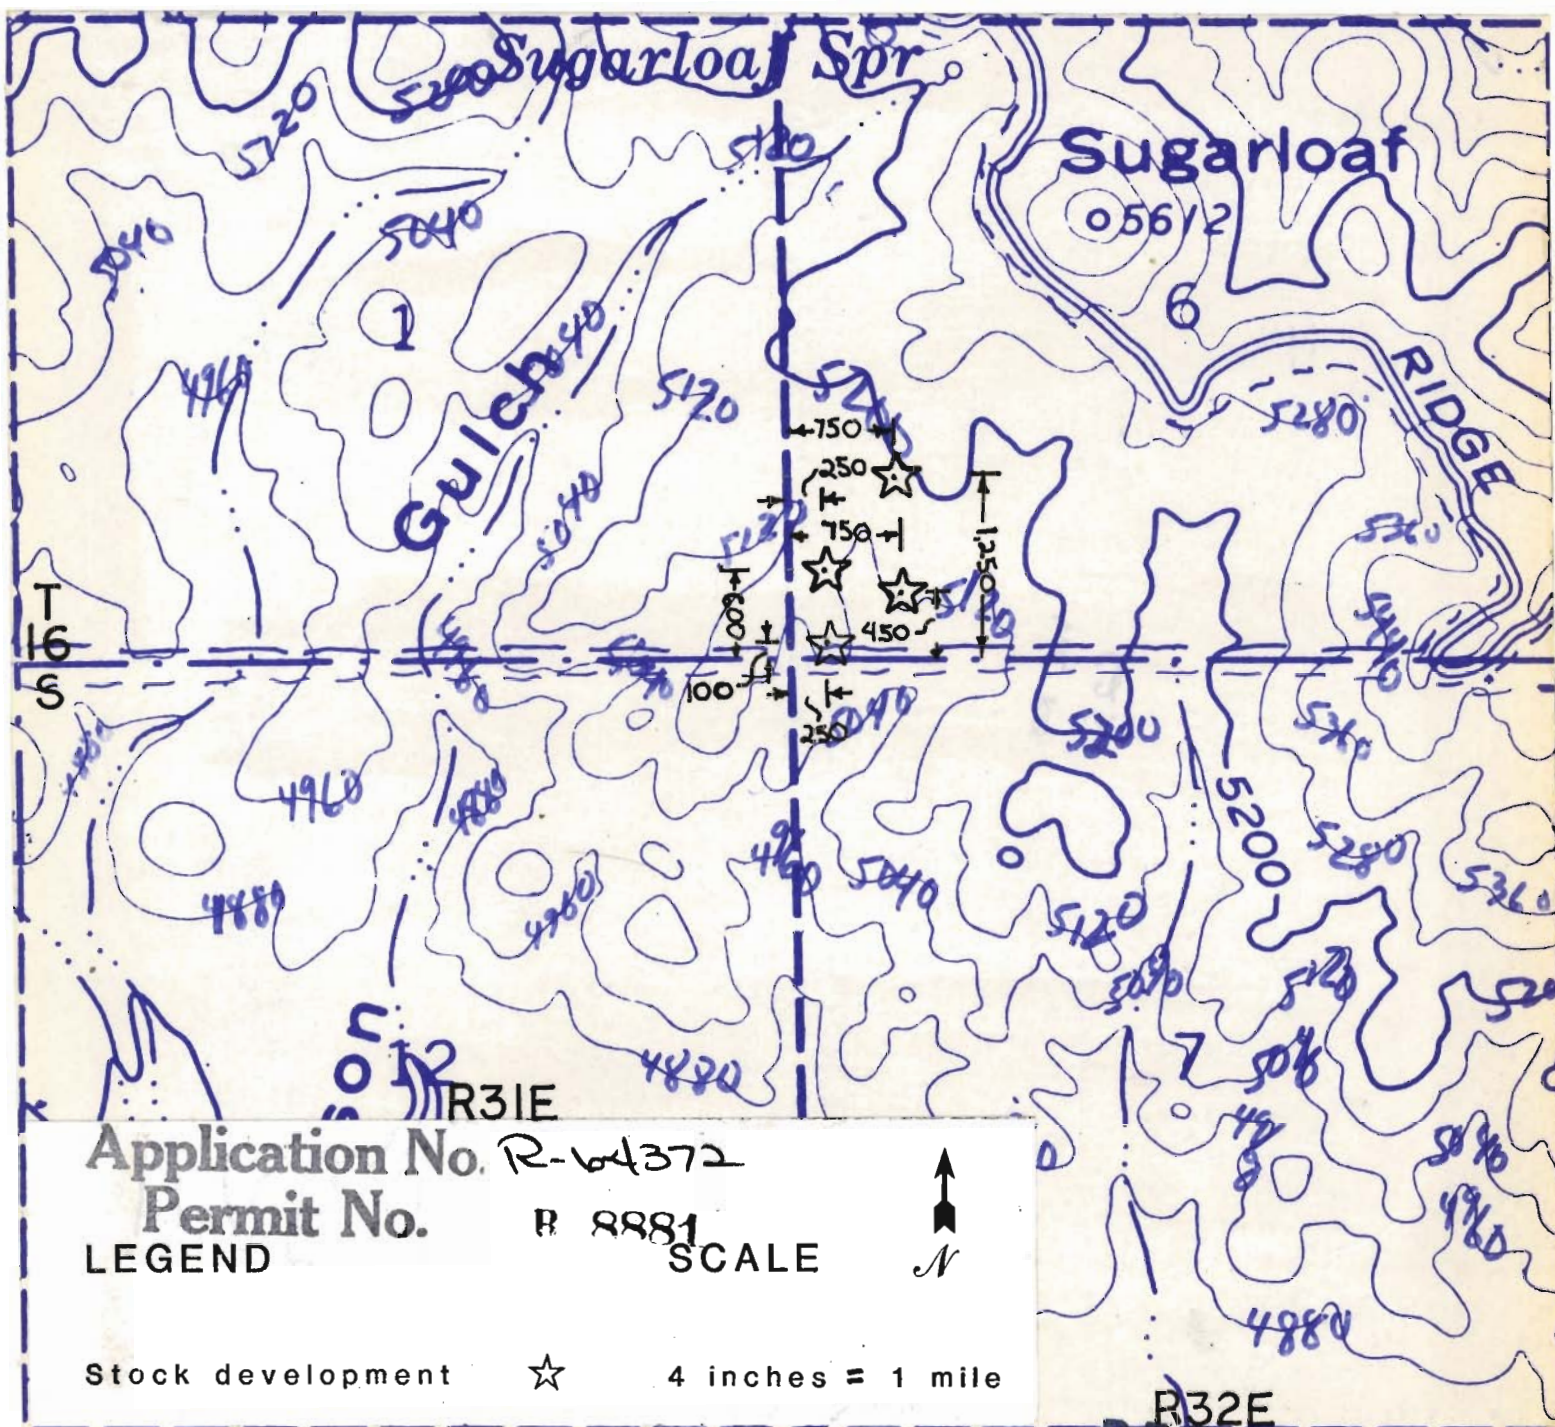

Application No. R-64372

Permit No. R 8881

LEGEND

SCALE



Stock development



4 inches = 1 mile

R32E
RECEIVED

OCT 4 1982

WATER RESOURCES DEPT.
SALEM, OREGON