


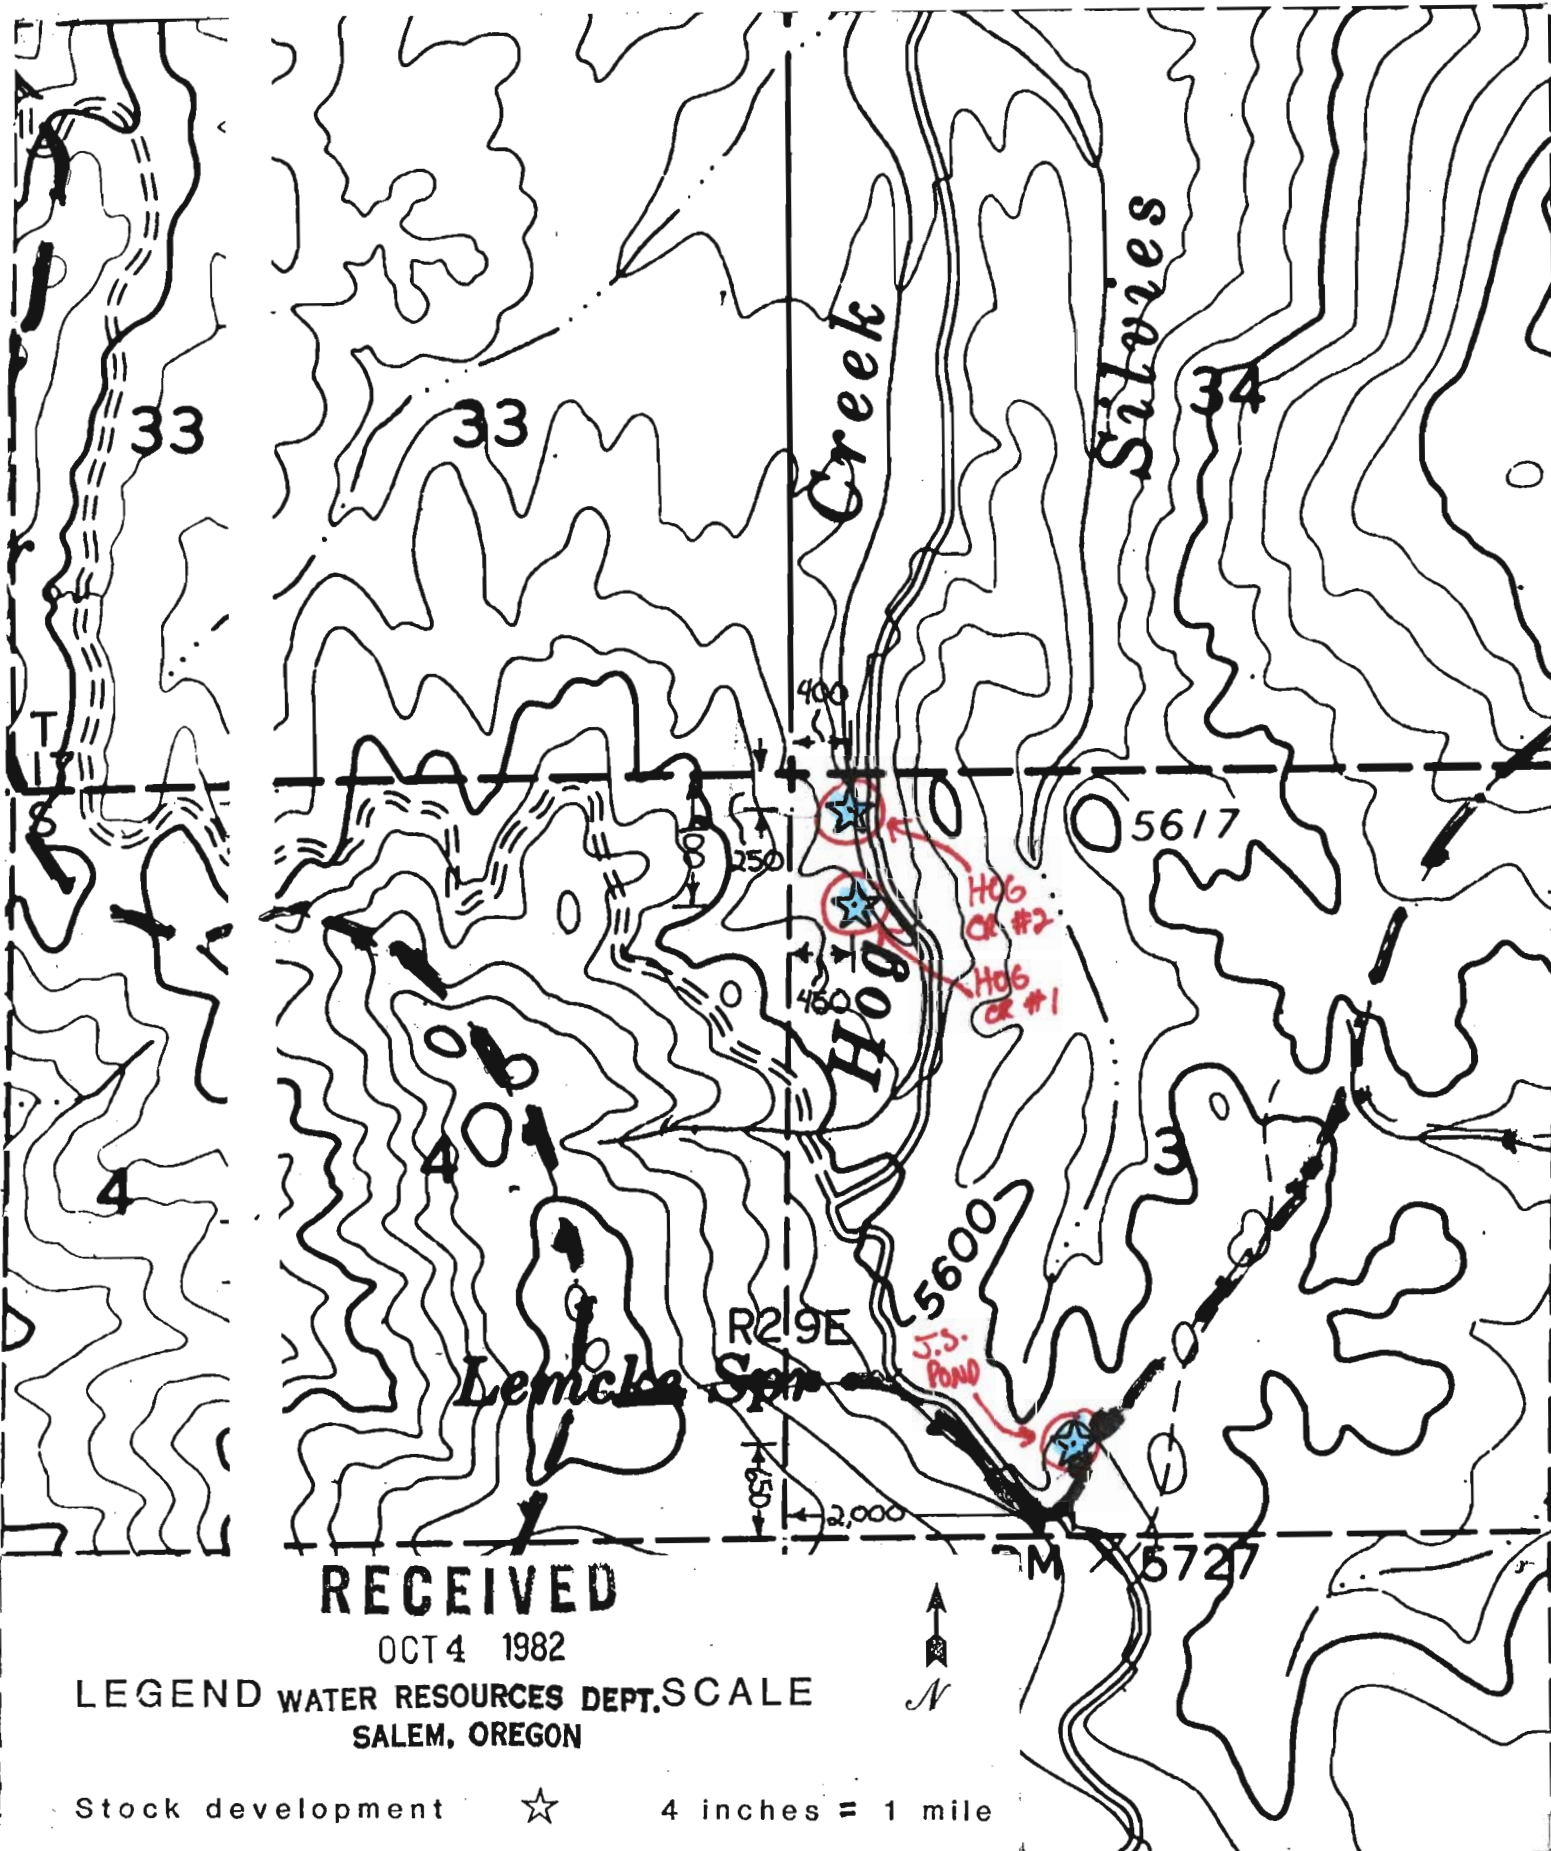

Application No. R-64373
Permit No. R 8882