


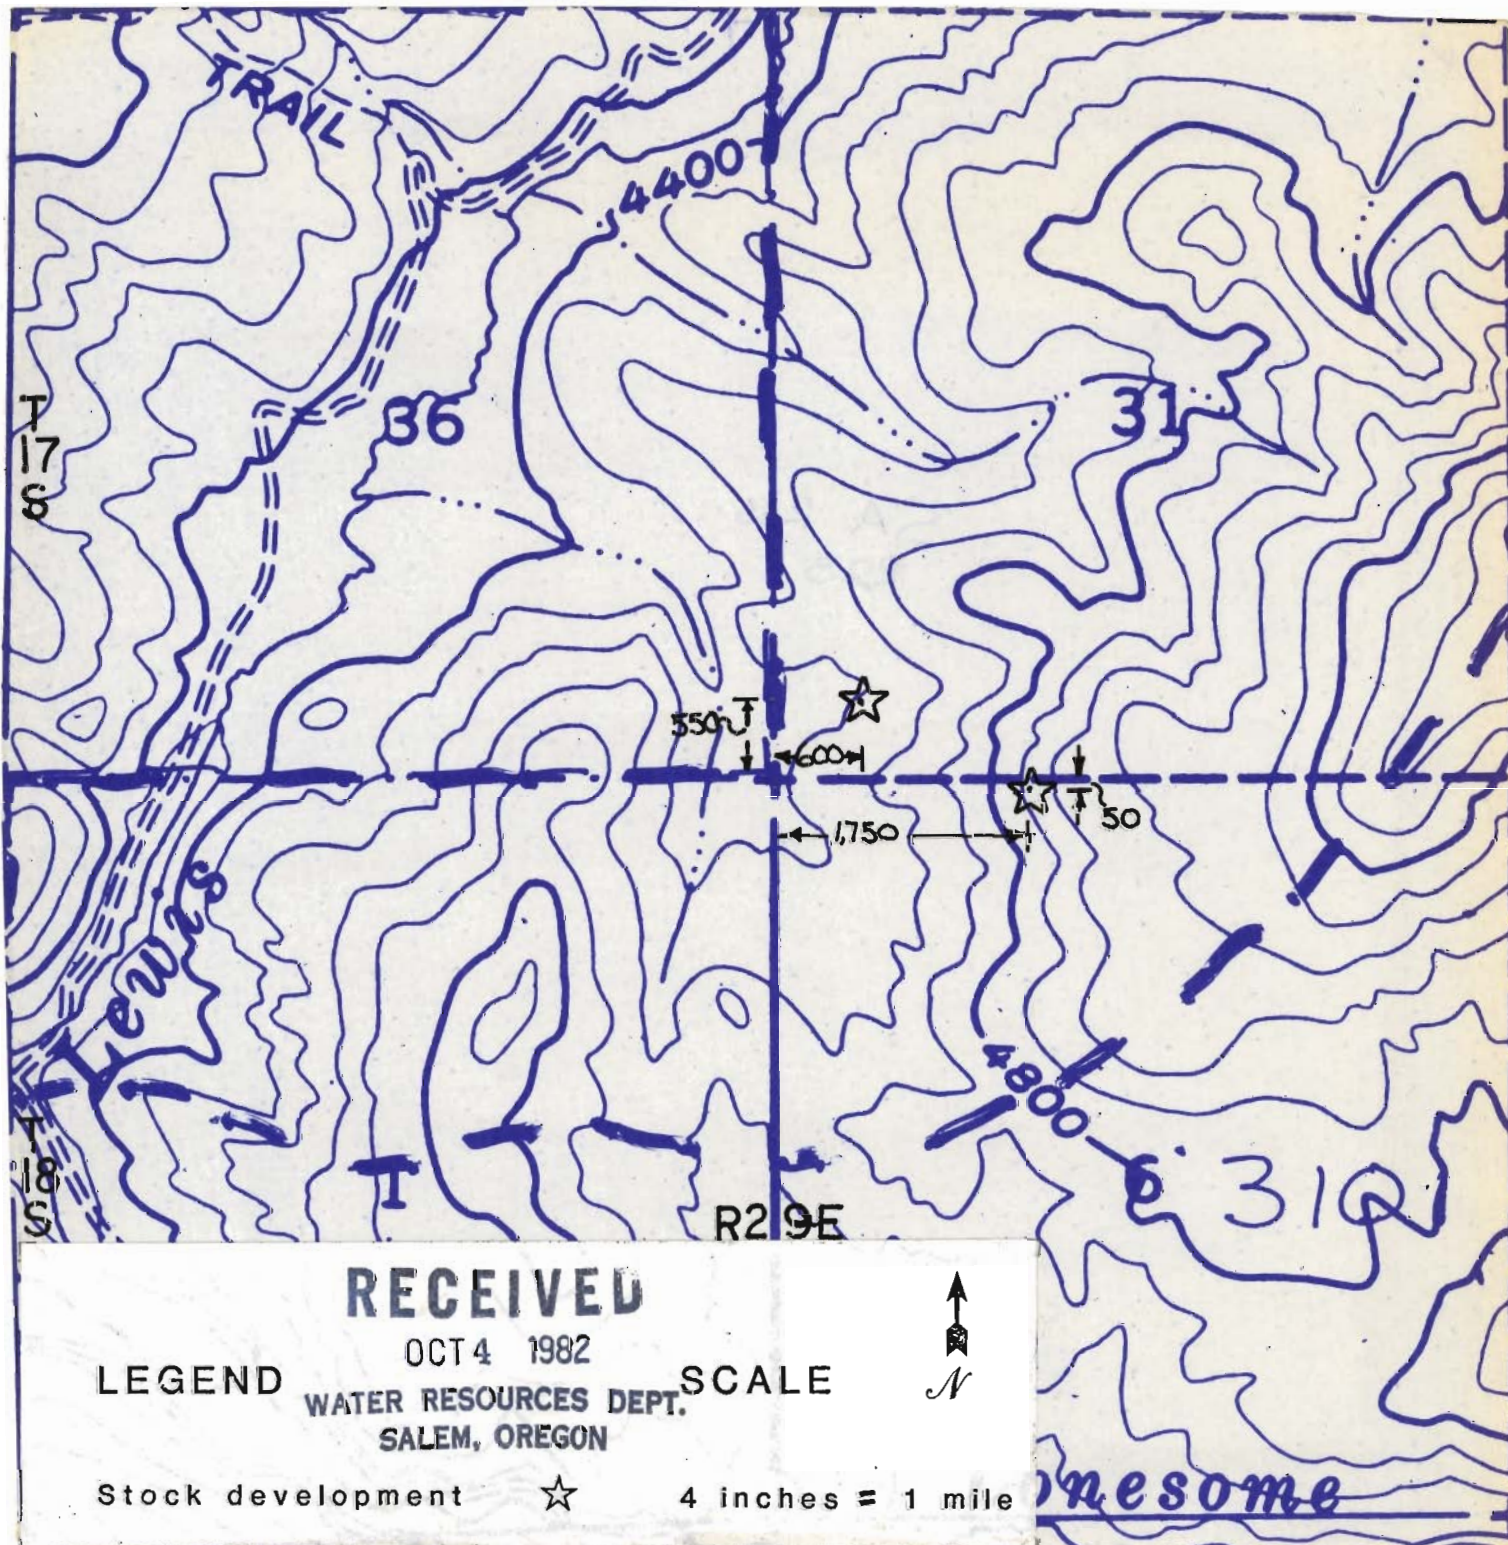

Application No. R-64375
Permit No. R 8884