


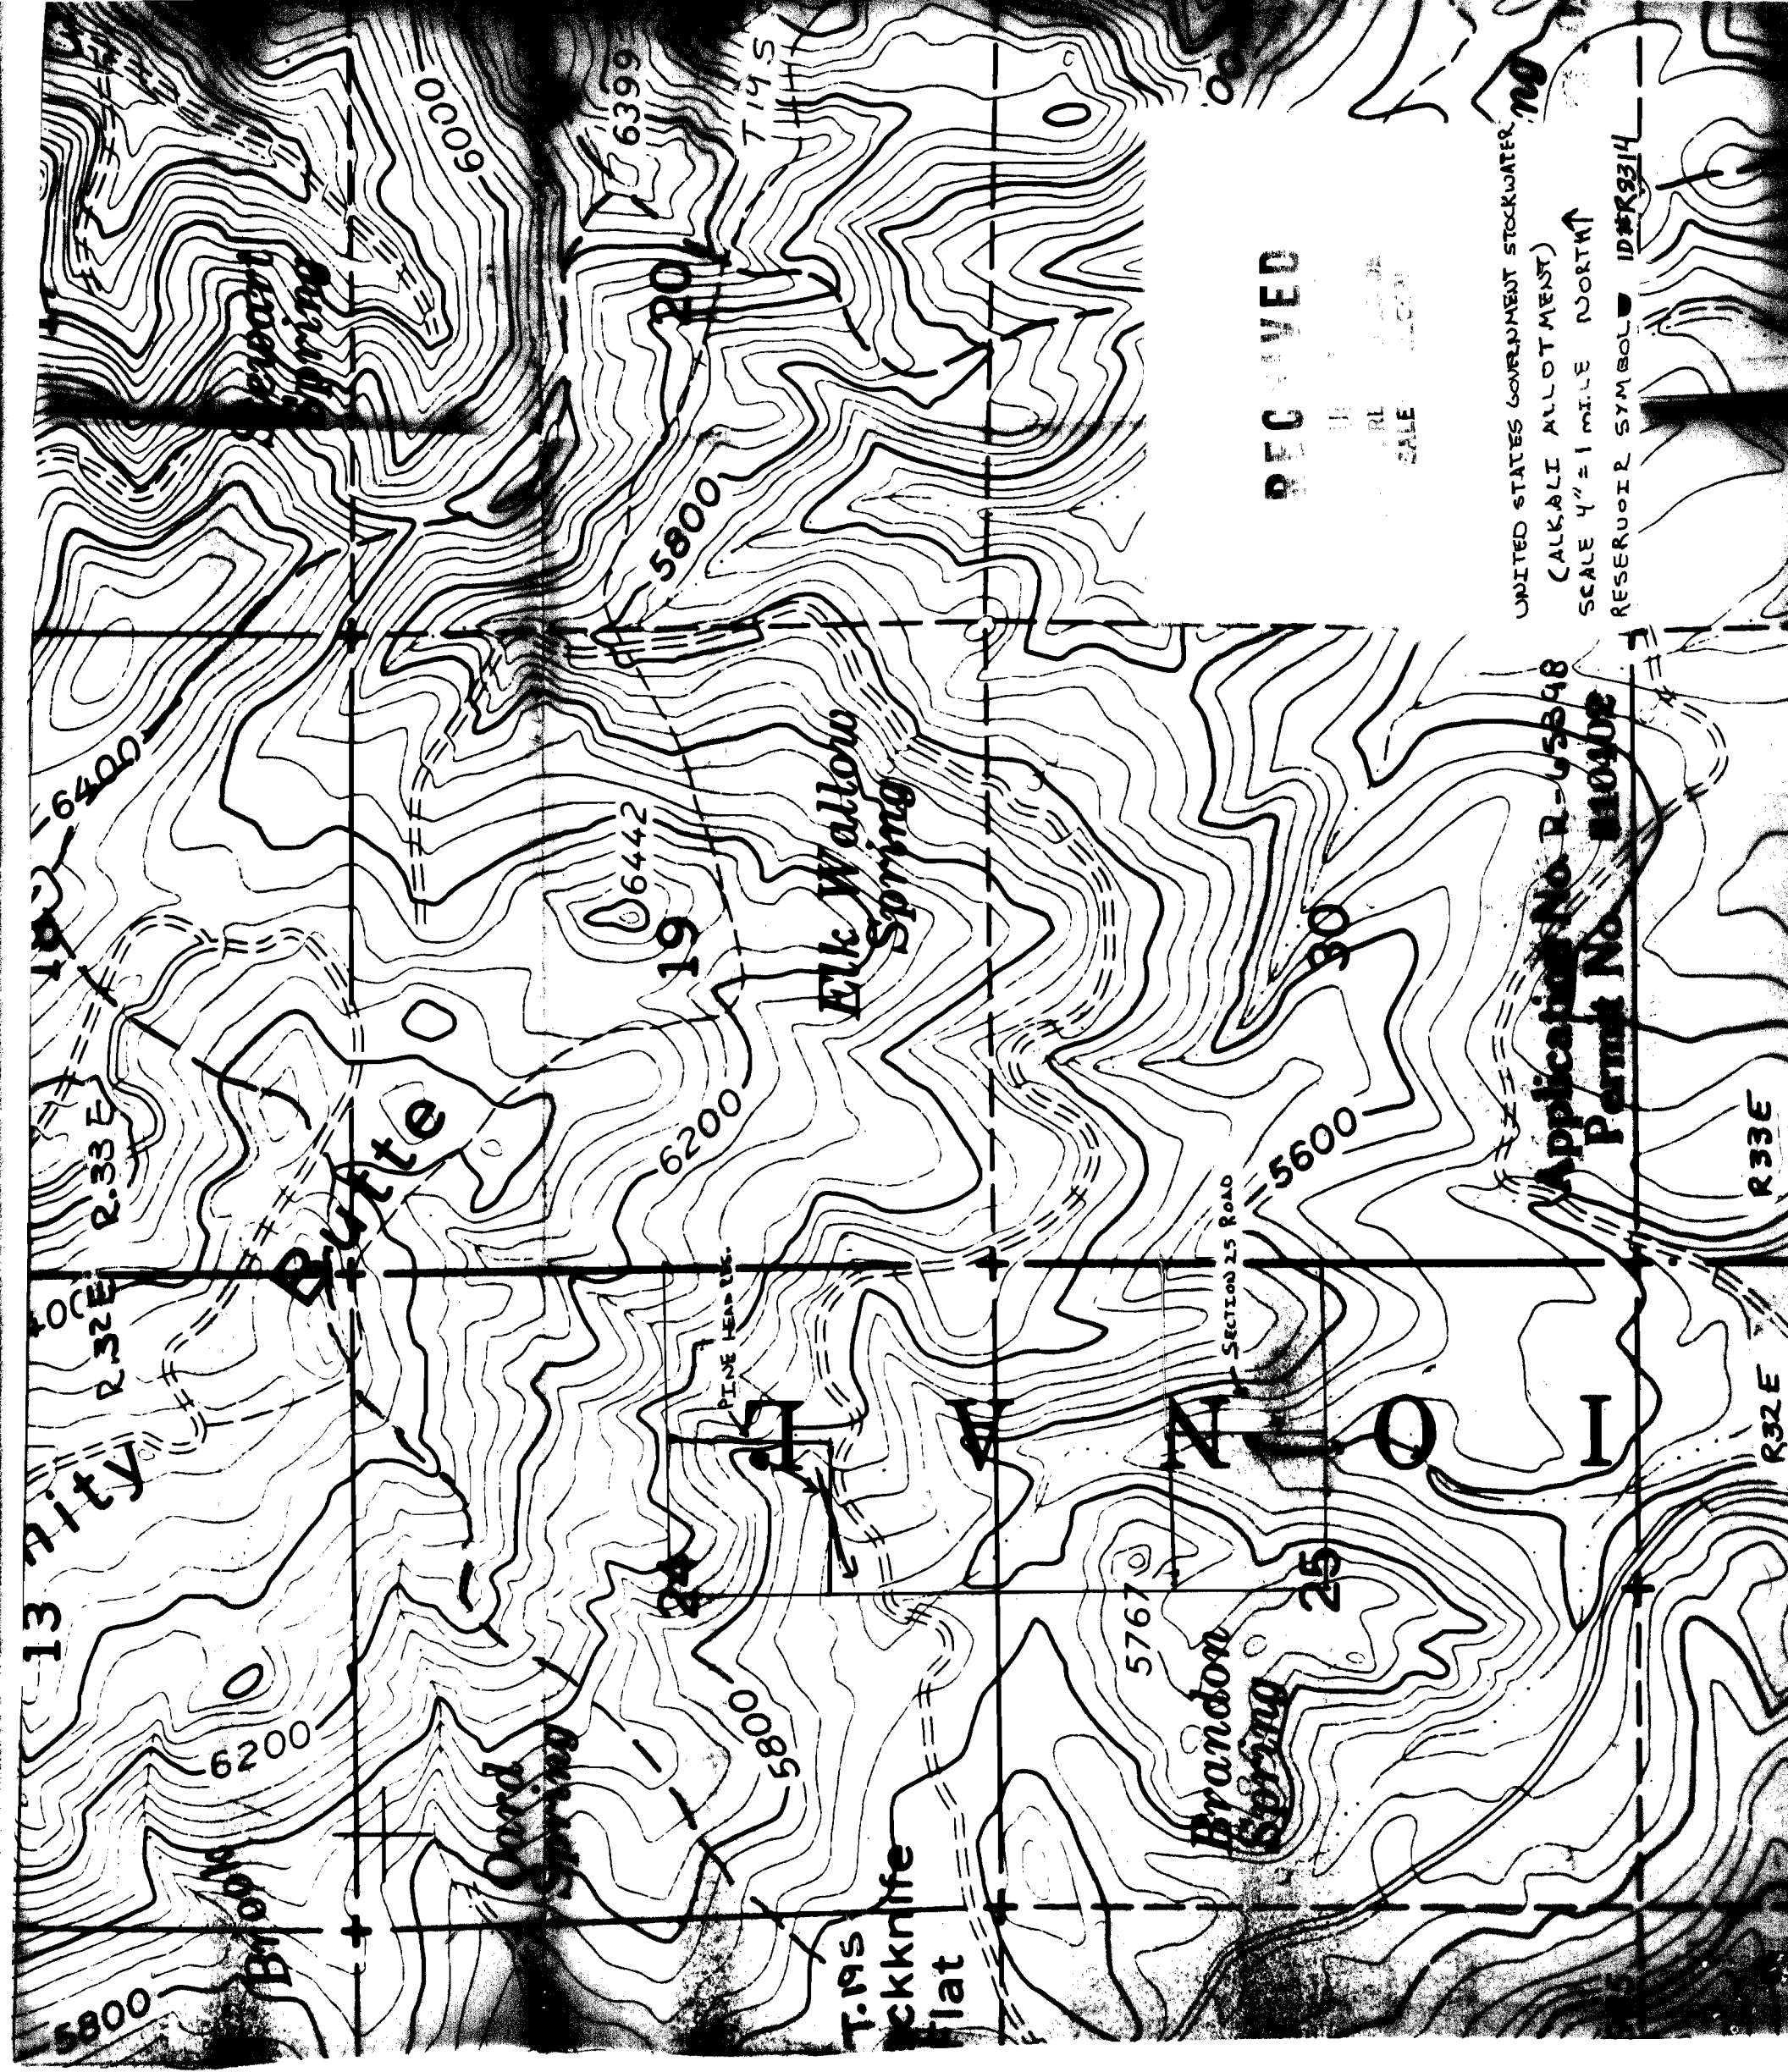

RECEIVED

RL
CALE

UNITED STATES GOVERNMENT STOCKWATER
(CALKALI ALLOTMENT)
SCALE 4"=1 MILE NORTH
RESERVOIR SYMBOL ID#K9314

Application No. R-65348
Permit No. 810402

R.32E
R.33E