


RECEIVED

JUL 27 1983

WATER RESOURCES DIVISION  
SALEM, OREGON

UNITED STATES GOVERNMENT STOCKS  
(BIG SAGEHEN ALLOTMENT)  
SCALE 4" = 1 MILE NORTH  
RESERVOIR SYMBOL TO R 2320

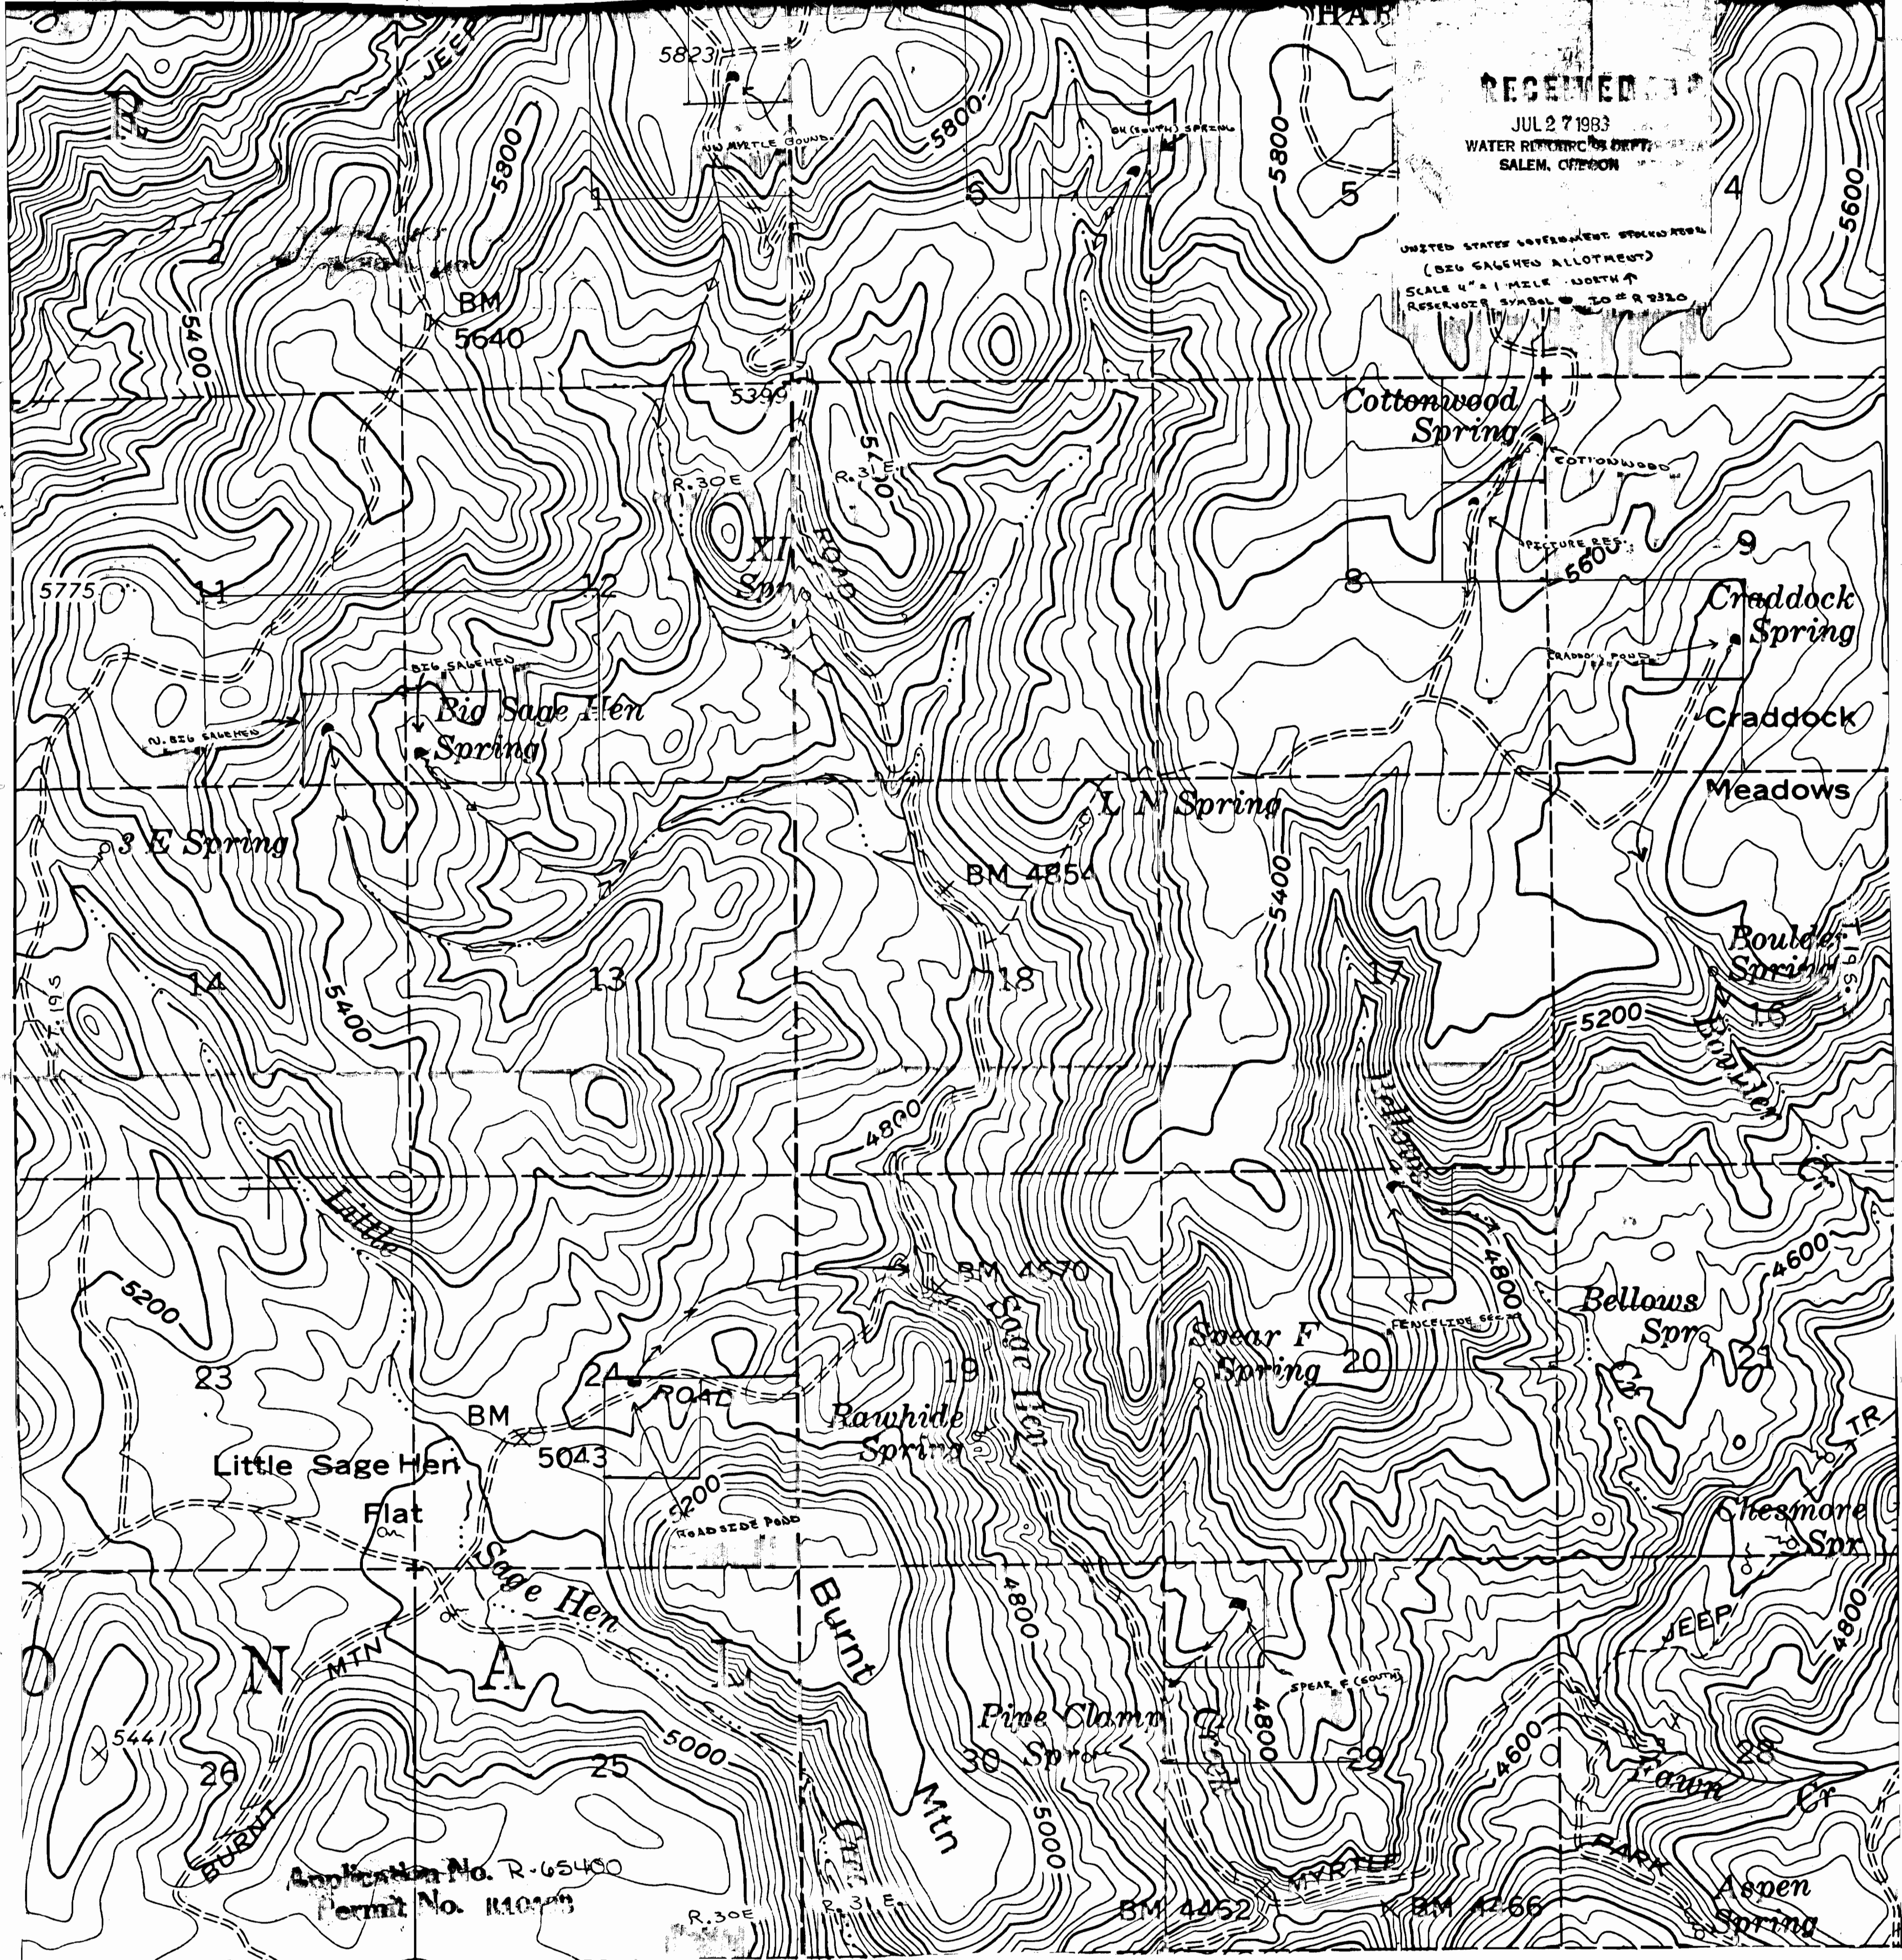

Application No. R-65460  
Permit No. 114079

R. 30E R. 31E

BM 4452

BM 4266

Aspen Spring