

MALHEUR NATIONAL FOREST

STOCK WATER (R8334)


DEVINE allotment

SCALE 4 IN. : 1 MILE

T. 20 S. R. 31 E. North ↑

application no. R-68412

permit no. R10410

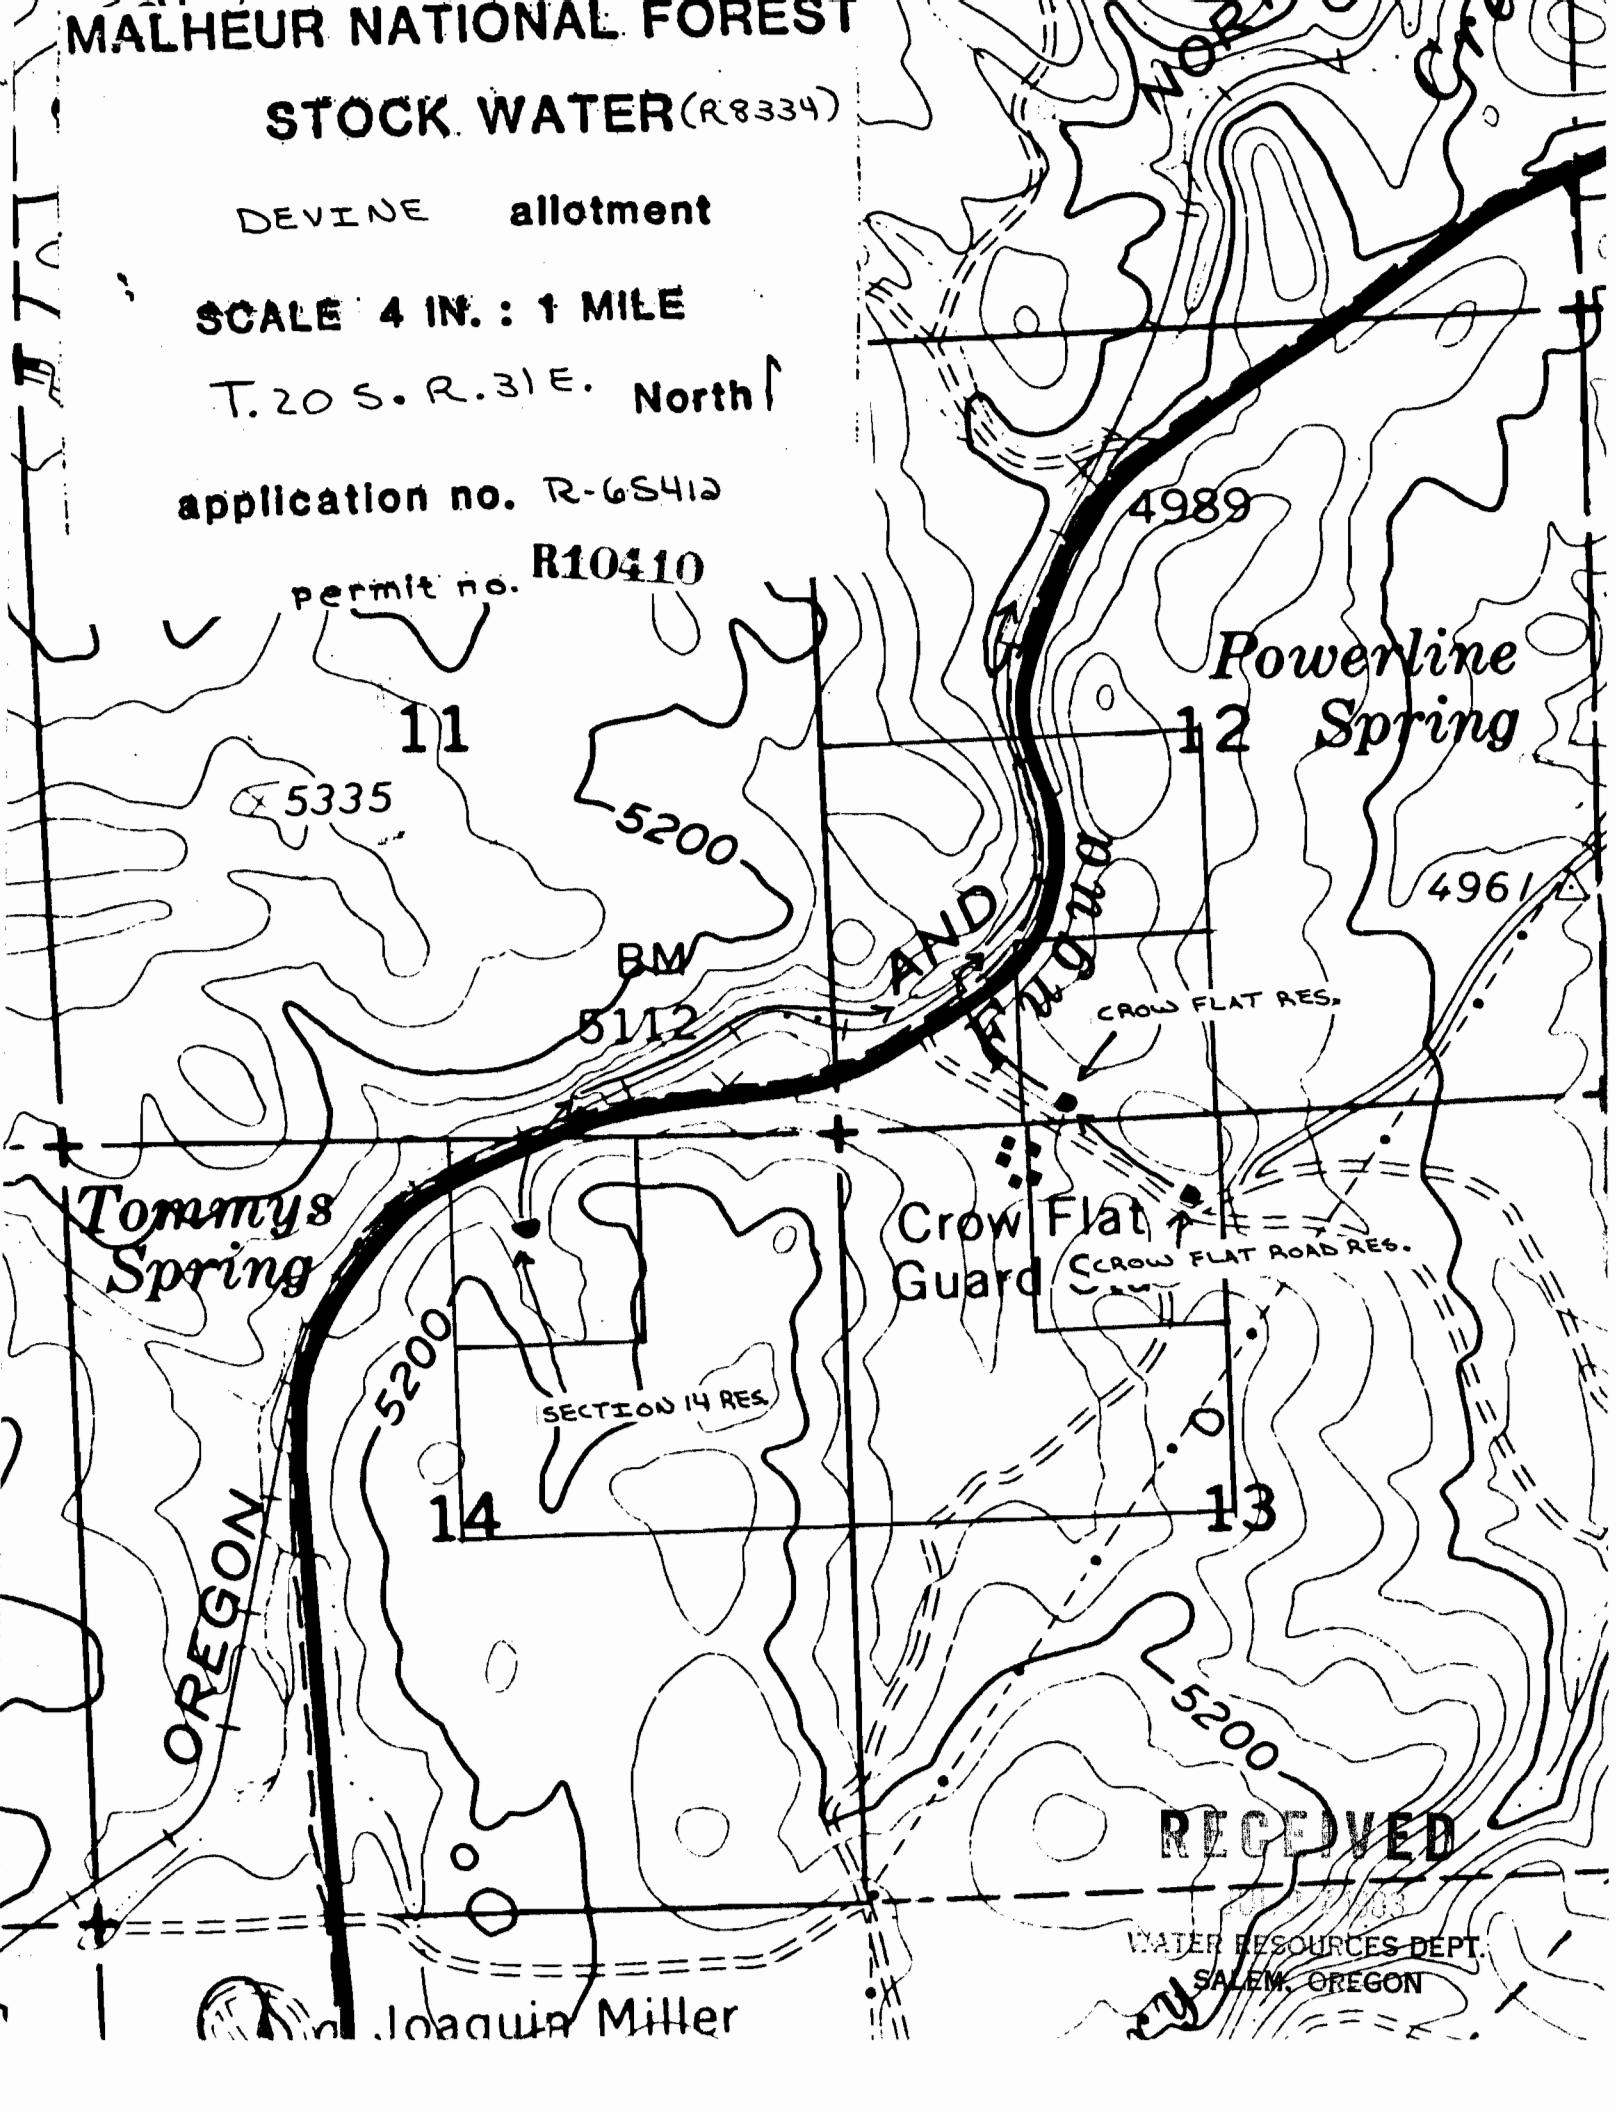

RECEIVED

WATER RESOURCES DEPT.
SALEM, OREGON

Joachim Miller