


RECEIVED

JUL 27 1983

WATER RESOURCES DEPT.
SALEM, OREGON

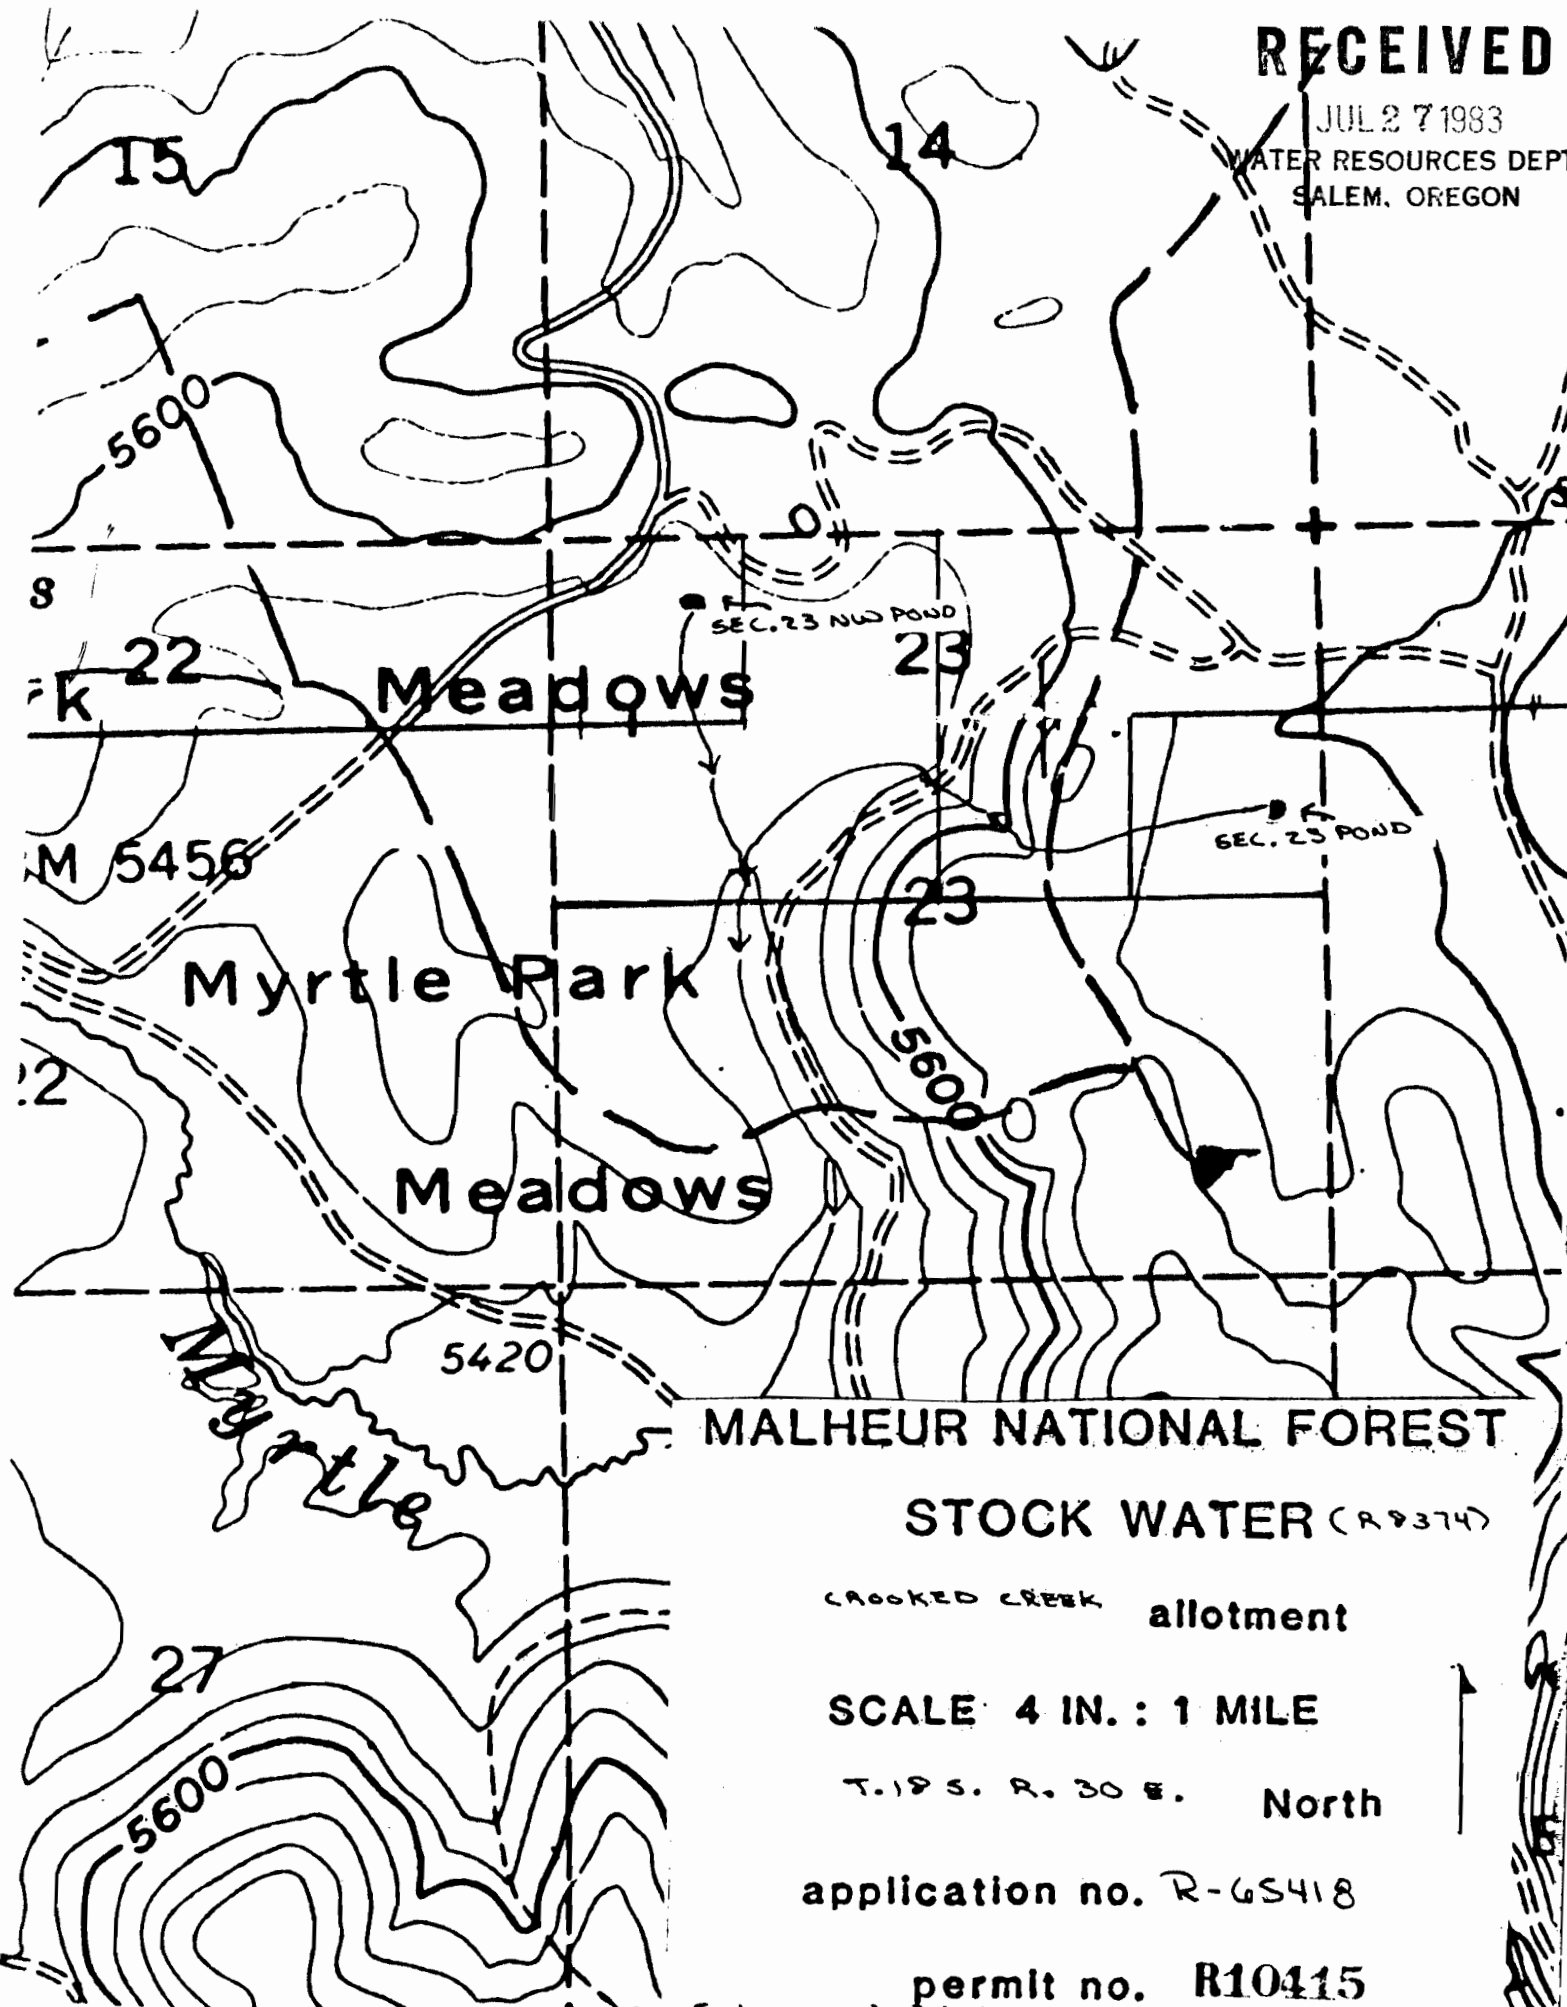

MALHEUR NATIONAL FOREST

STOCK WATER (R9374)

CROOKED CREEK allotment

SCALE 4 IN. : 1 MILE

T. 18 S. R. 30 E. North

application no. R-65418

permt no. R10415