


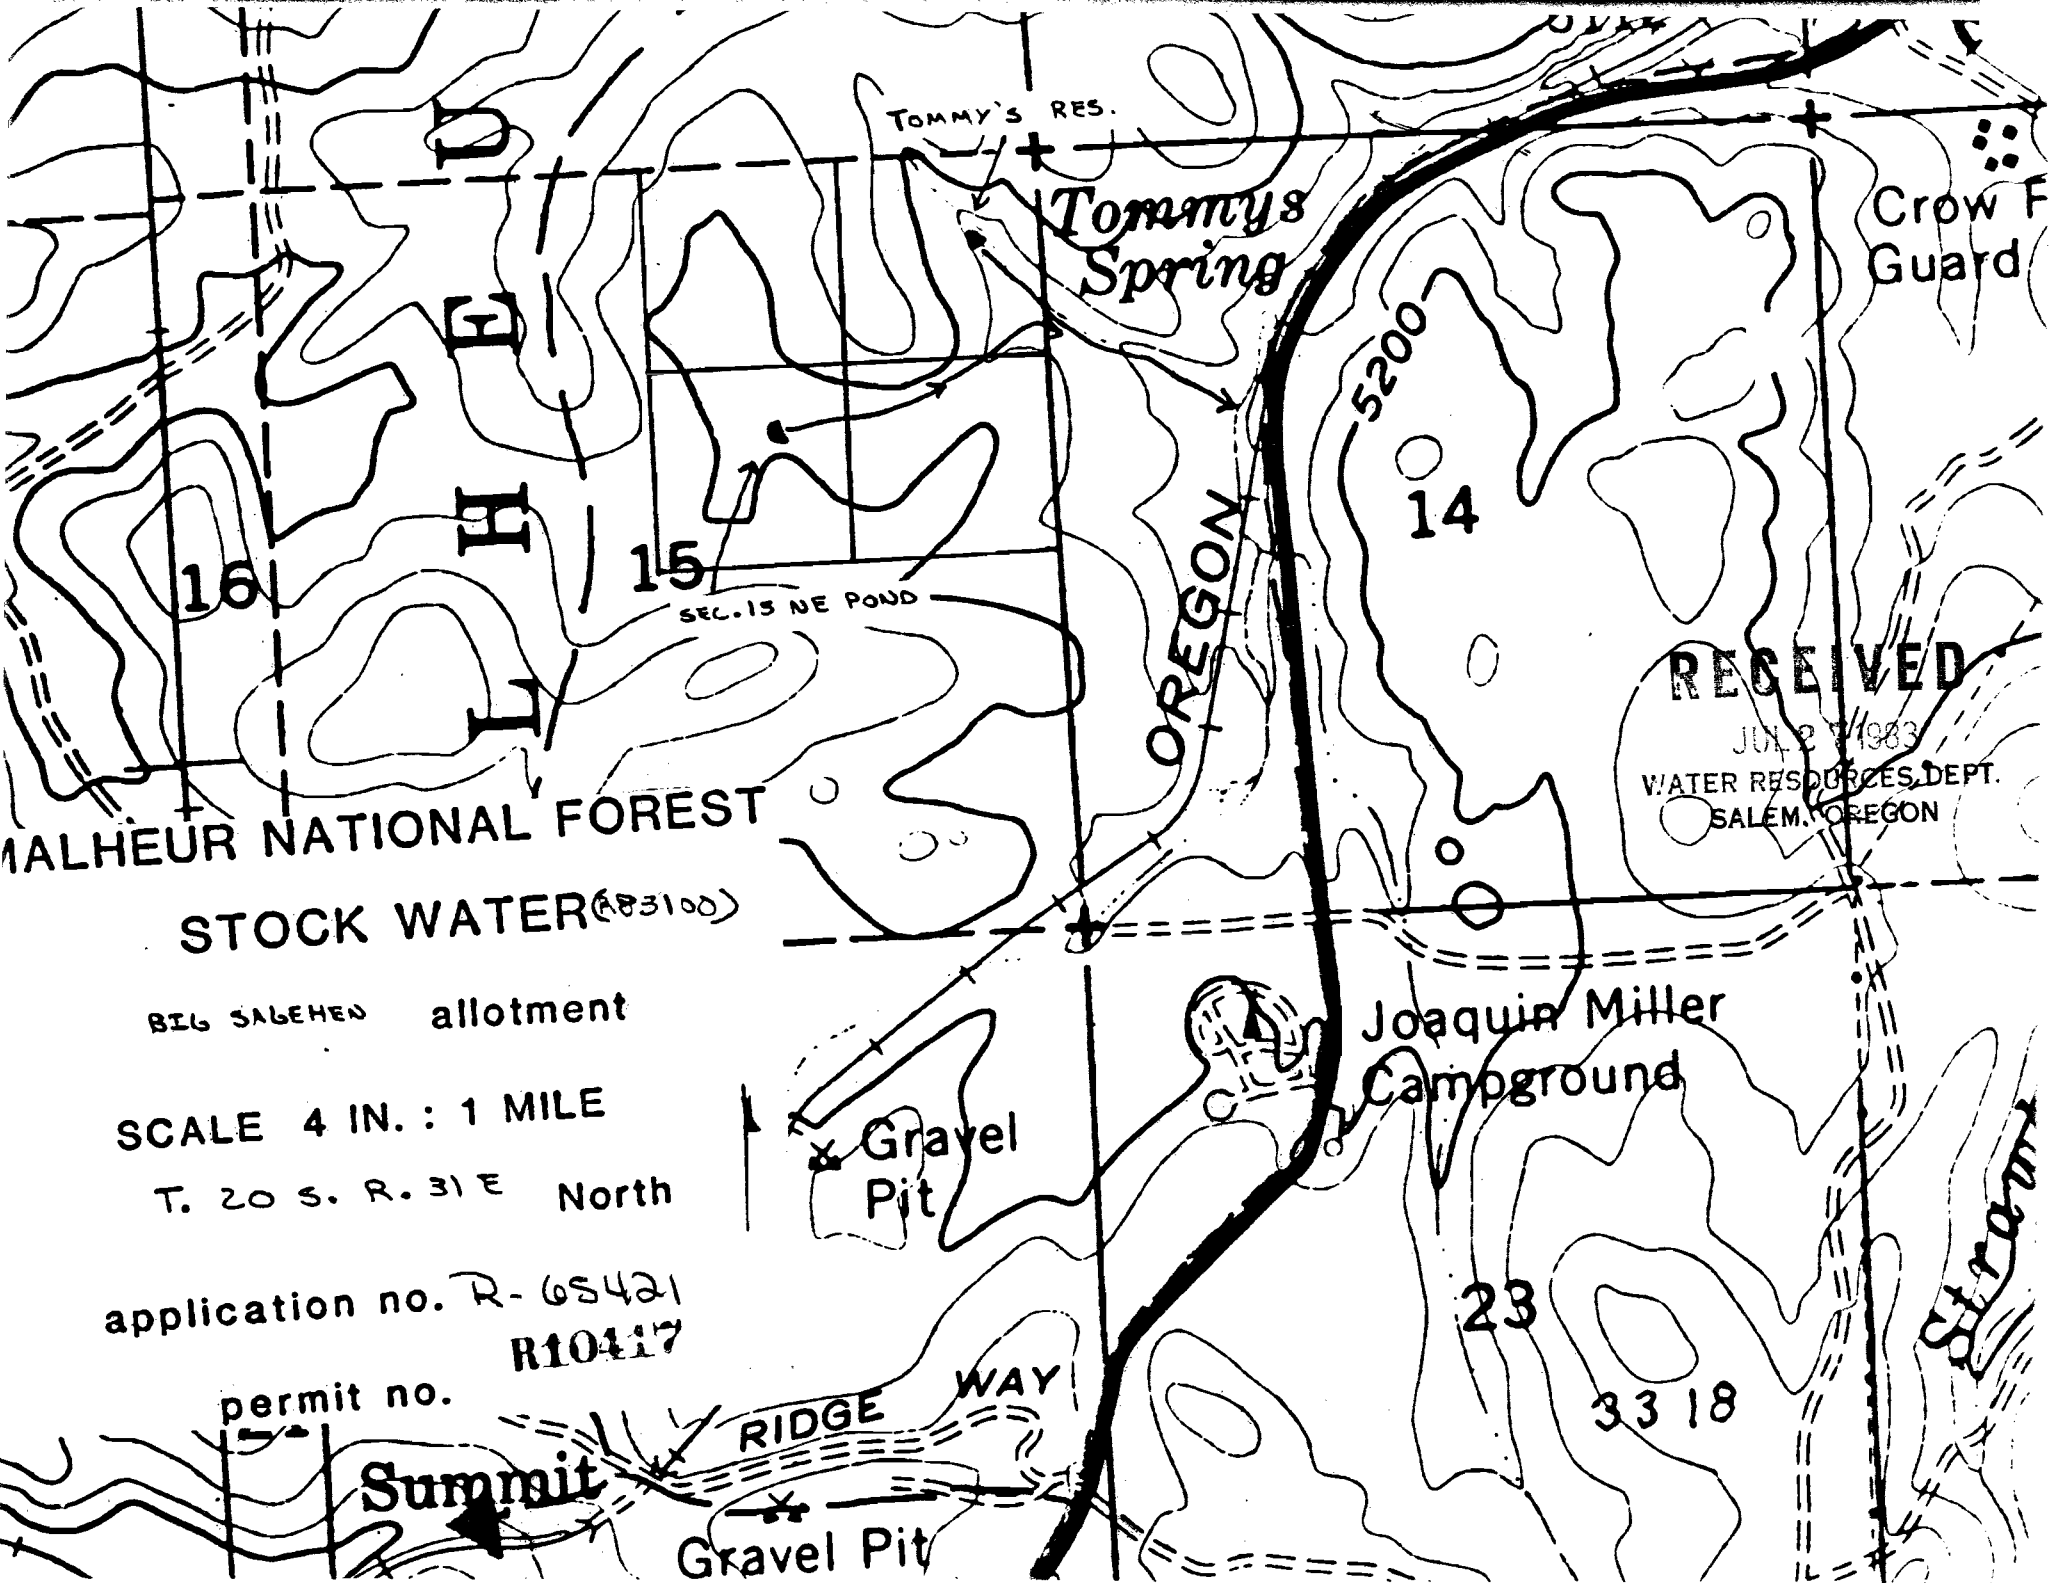

TOMMY'S RES.

Tommy's Spring

Crow F Guard

RECEIVED

JUL 27 1983

WATER RESOURCES DEPT.  
SALEM, OREGON

MALHEUR NATIONAL FOREST

STOCK WATER (83100)

BIG SAGEHEN allotment

SCALE 4 IN. : 1 MILE

T. 20 S. R. 31 E North

application no. R-65421

R10417

permit no.

Summit

RIDGE WAY  
Gravel Pit

Joaquin Miller  
Campground

Stream