


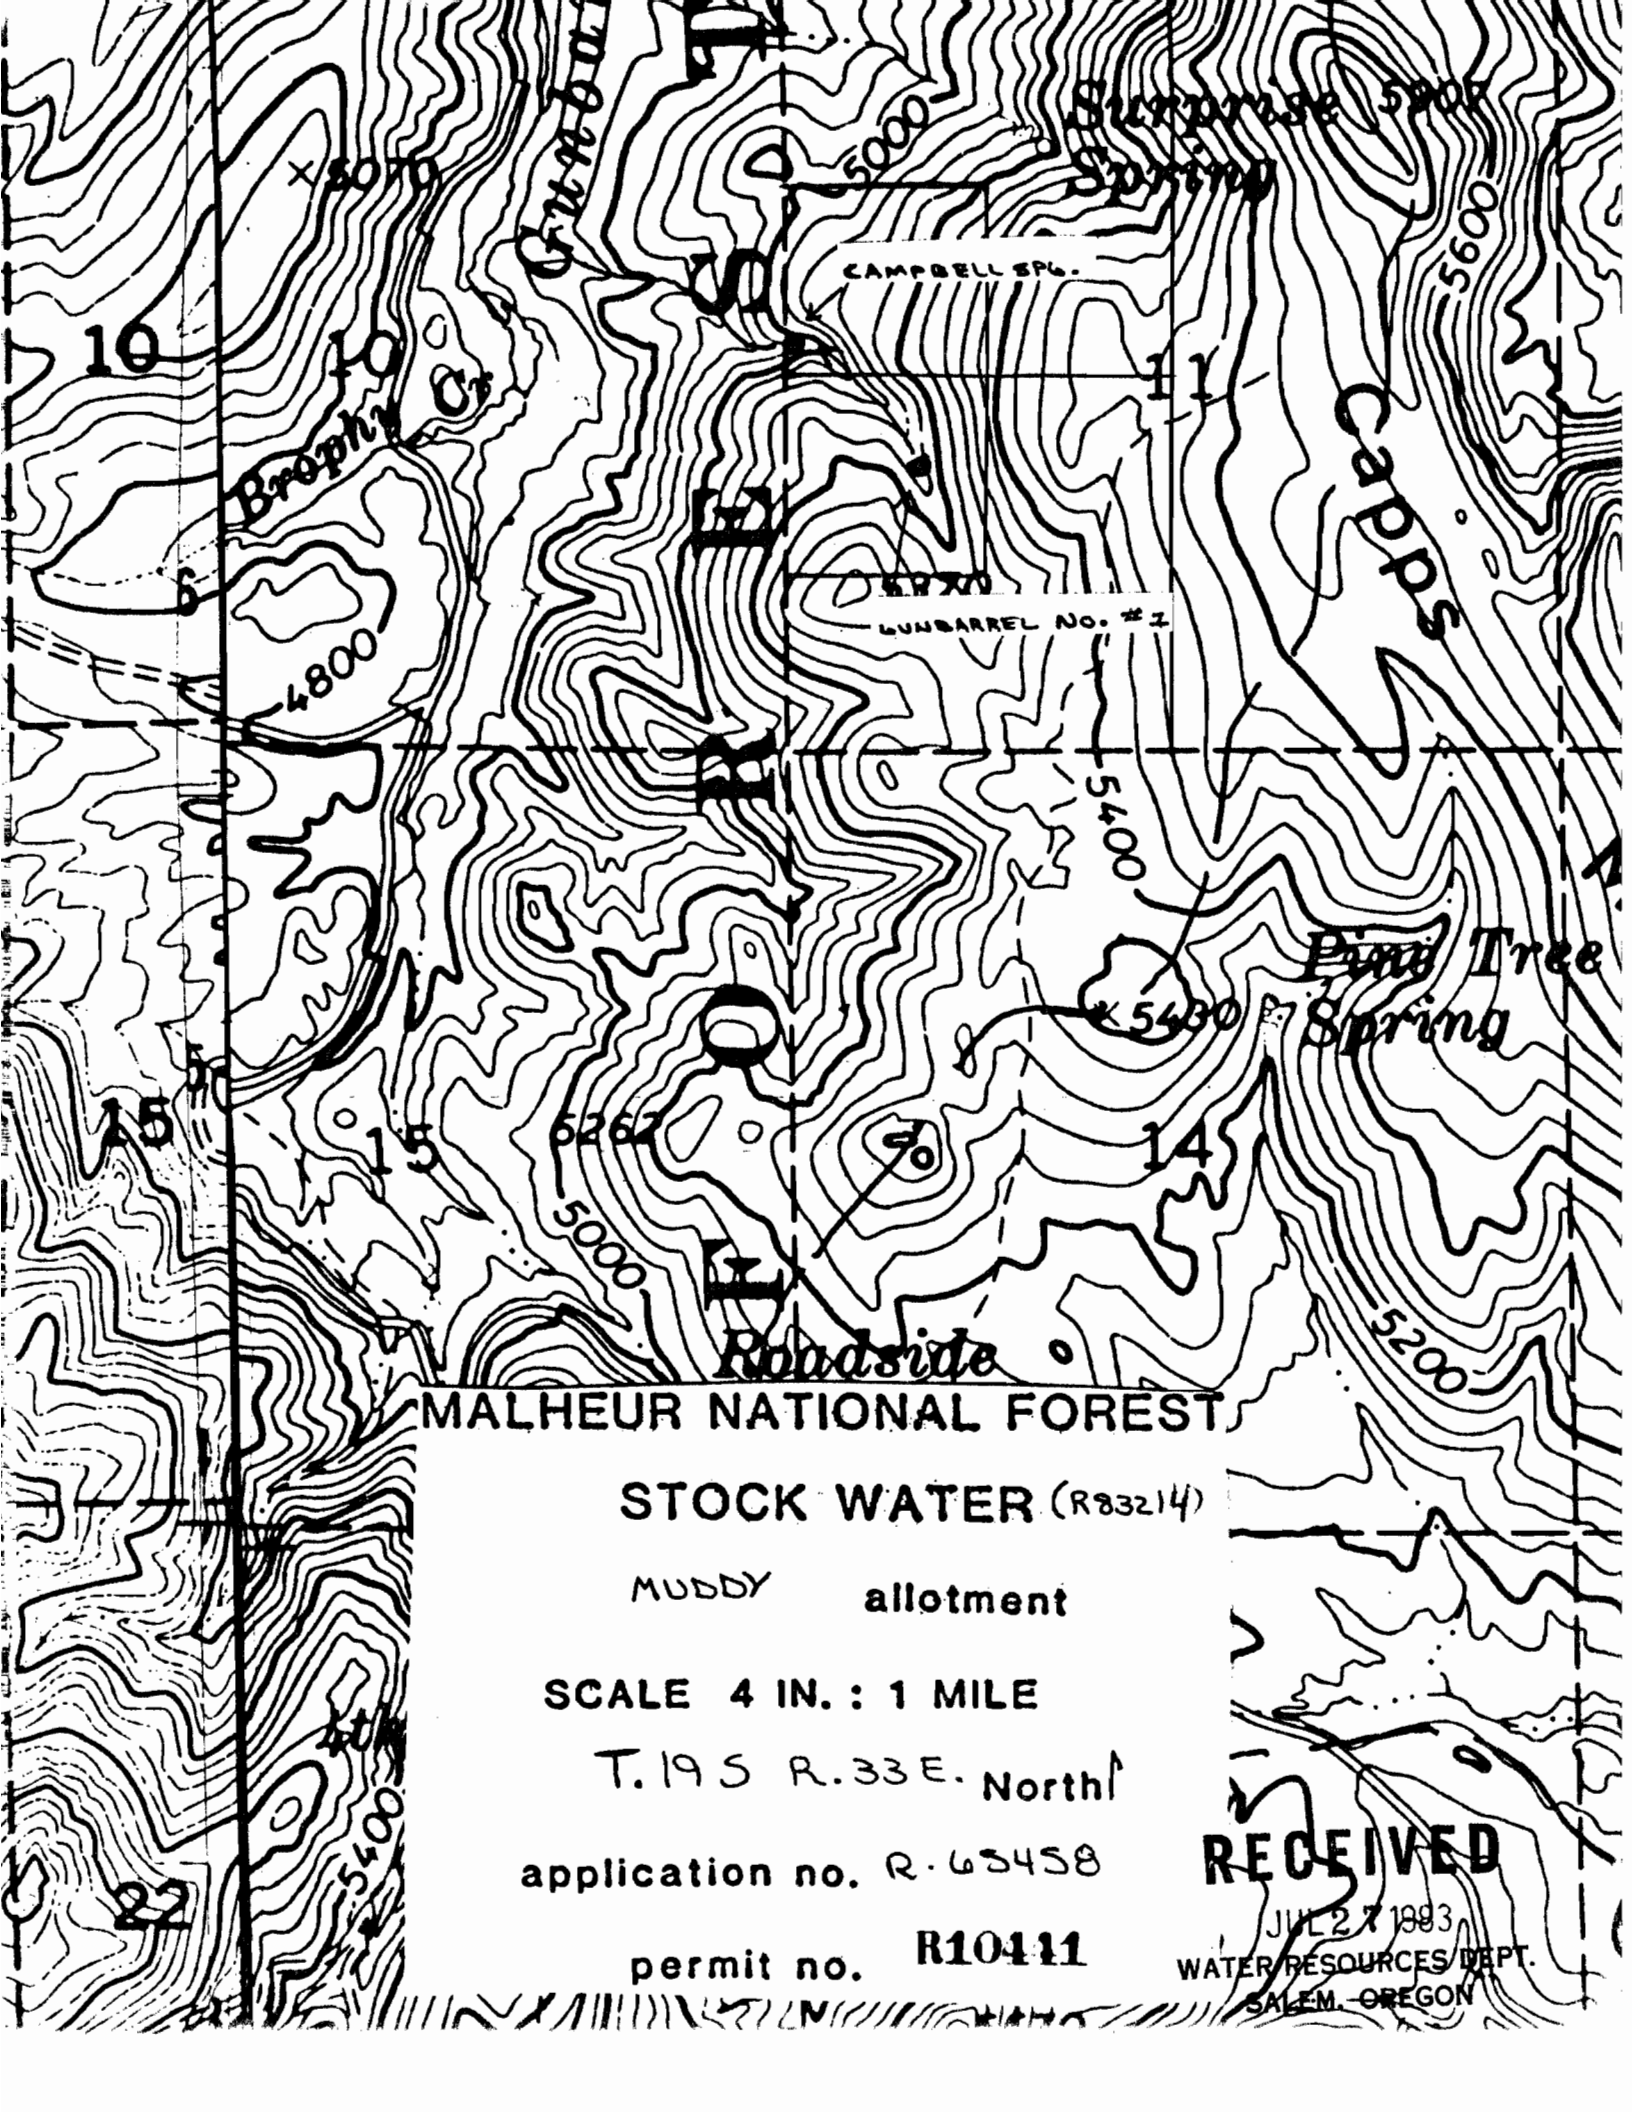

CAMPBELL SPG.

LUNBARREL No. #2

Pine Tree Spring

Roadside

MALHEUR NATIONAL FOREST

STOCK WATER (R83214)

MUDDY allotment

SCALE 4 IN. : 1 MILE

T. 19 S R. 33 E. North

application no. R. 63458

permit no. R10411

RECEIVED

JUL 27 1993
WATER RESOURCES DEPT.
SALEM, OREGON