


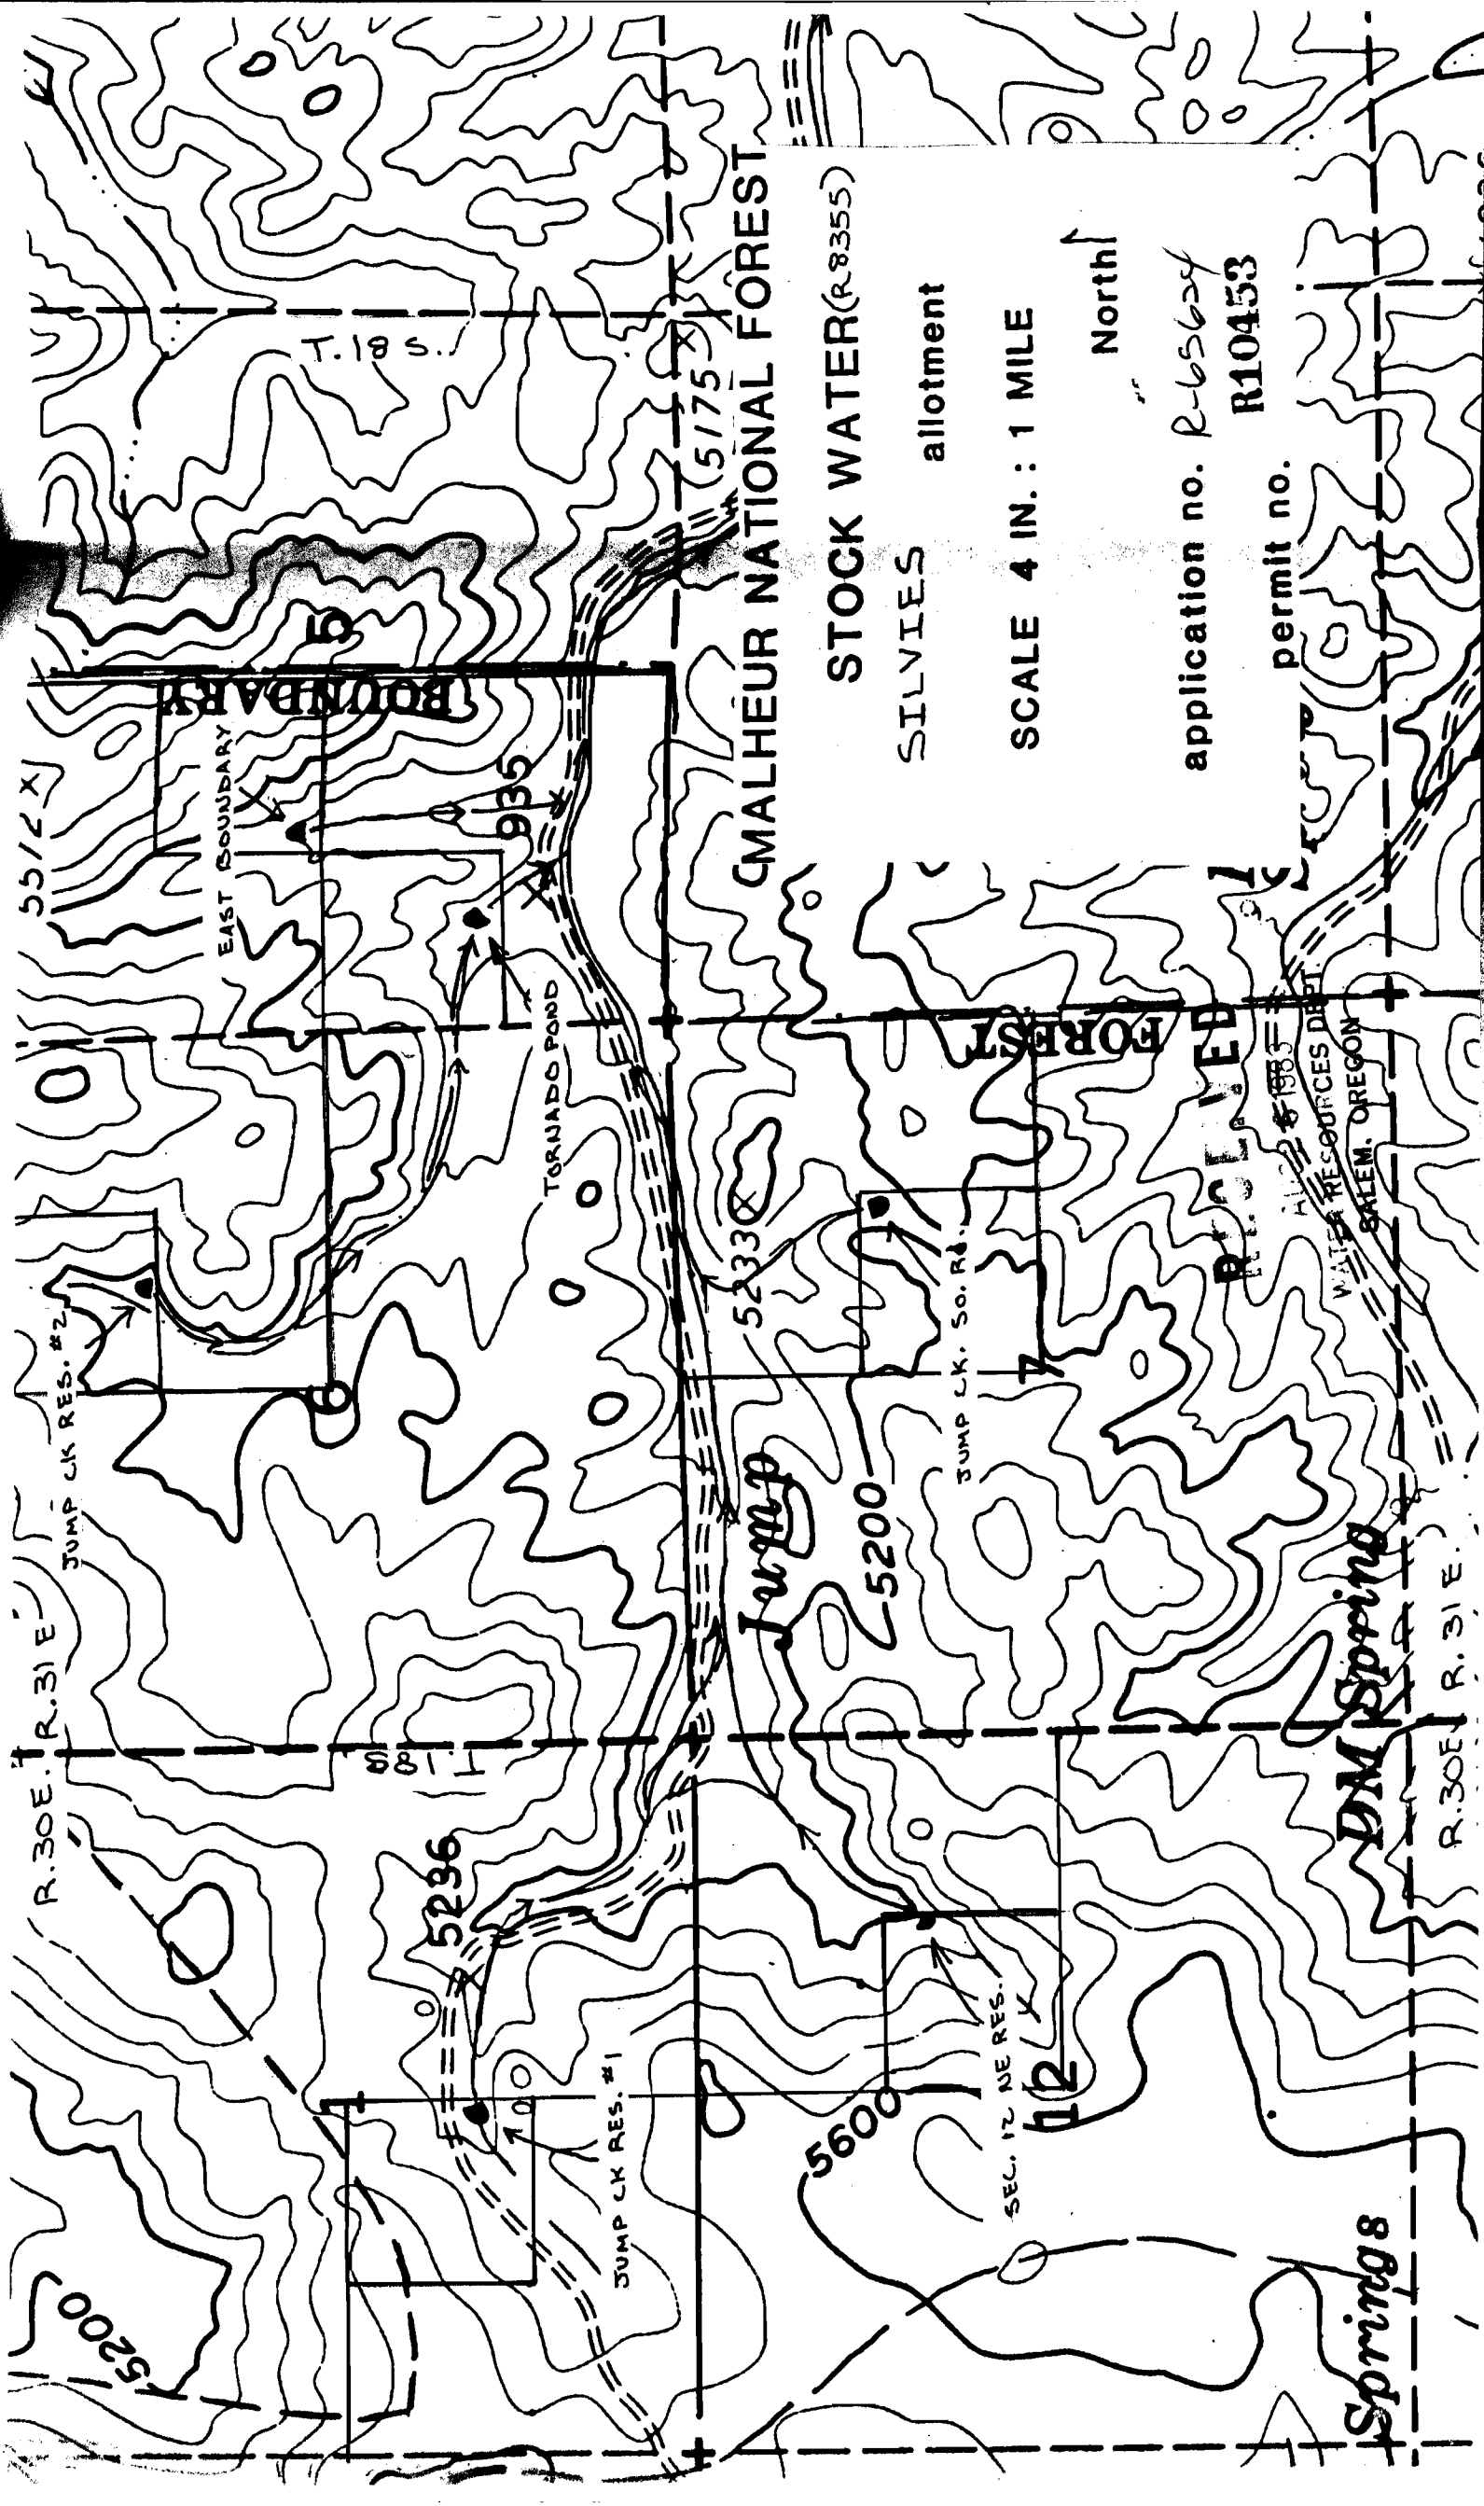

BOUNDARY

EAST BOUNDARY


Jump

5233

5200

JUMP CK. SO. R.

FOREST

RECEIVED

AUG 28 1983

WATER RESOURCES DEPT.
SALEM, OREGON

DM Spring

Spring

MALHEUR NATIONAL FOREST

STOCK WATER(R8355)

SILVIES allotment

SCALE 4 IN. : 1 MILE

North

application no. R-65624

R10453

permit no.

R. 30 E. R. 31 E.

T. 18 S.

5512 X

JUMP CK RES. #2

R. 30 E. R. 31 E.

JUMP CK RES. #1

SEC. 12 NE RES.

12

(5175 X)