


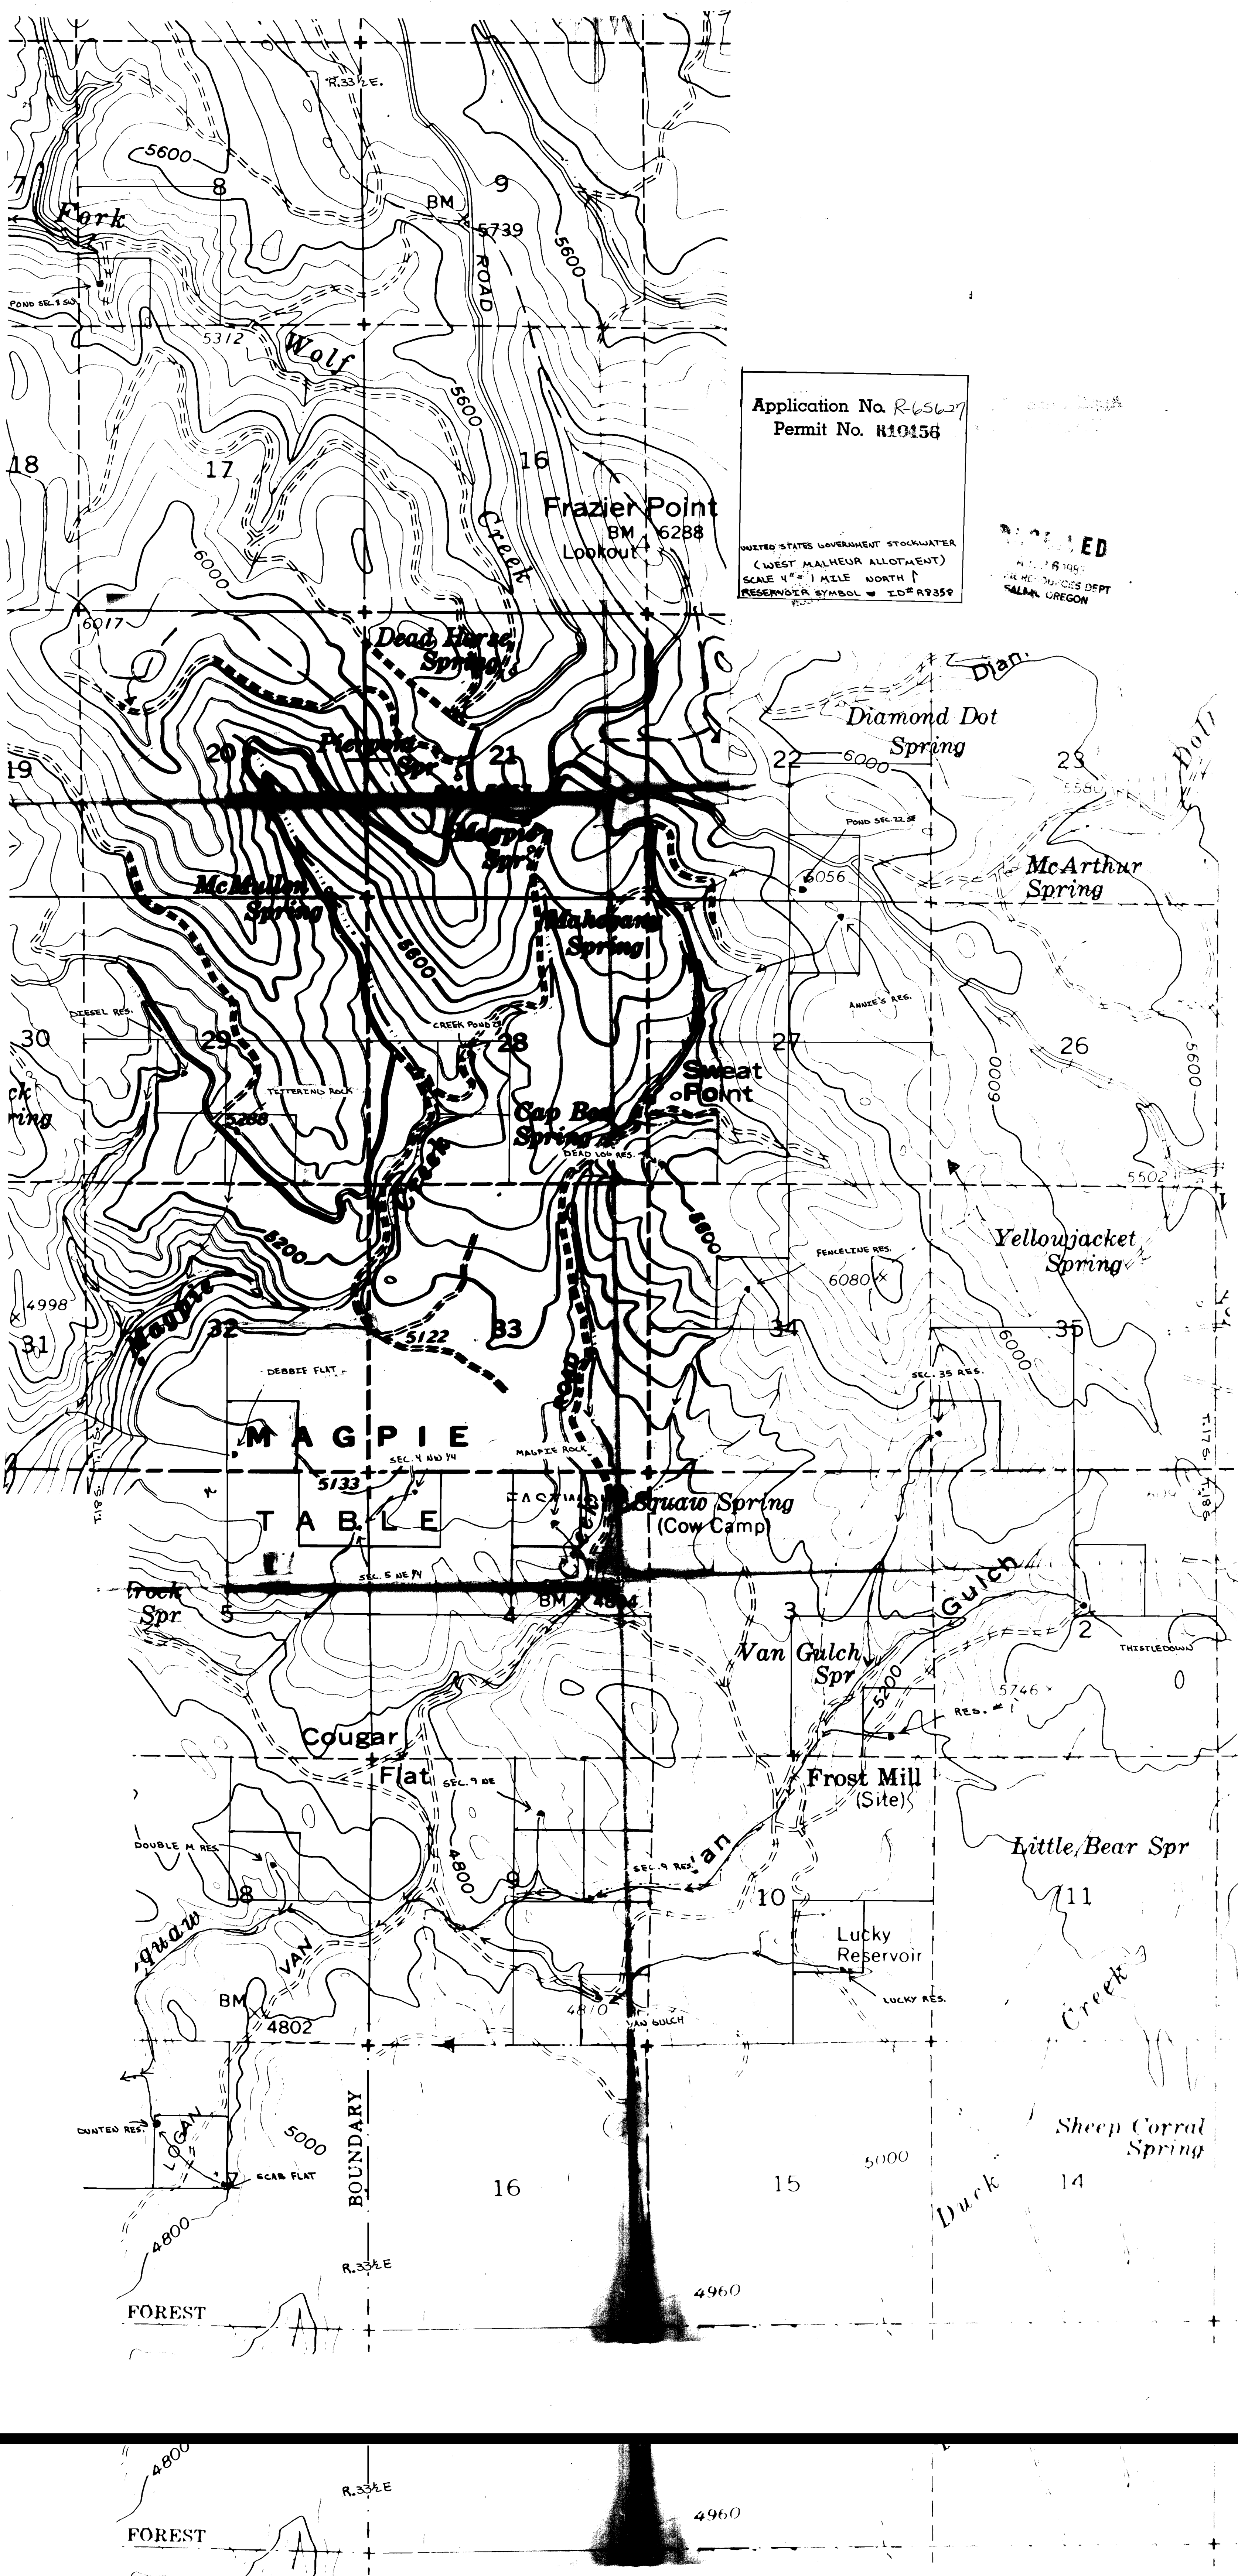

Application No. R-65627
Permit No. R10456

UNITED STATES GOVERNMENT STOCKWATER
(WEST MALHEUR ALLOTMENT)
SCALE 4" = 1 MILE NORTH

ED

MAGPIE
TABLE

FOREST

4960