


Copy

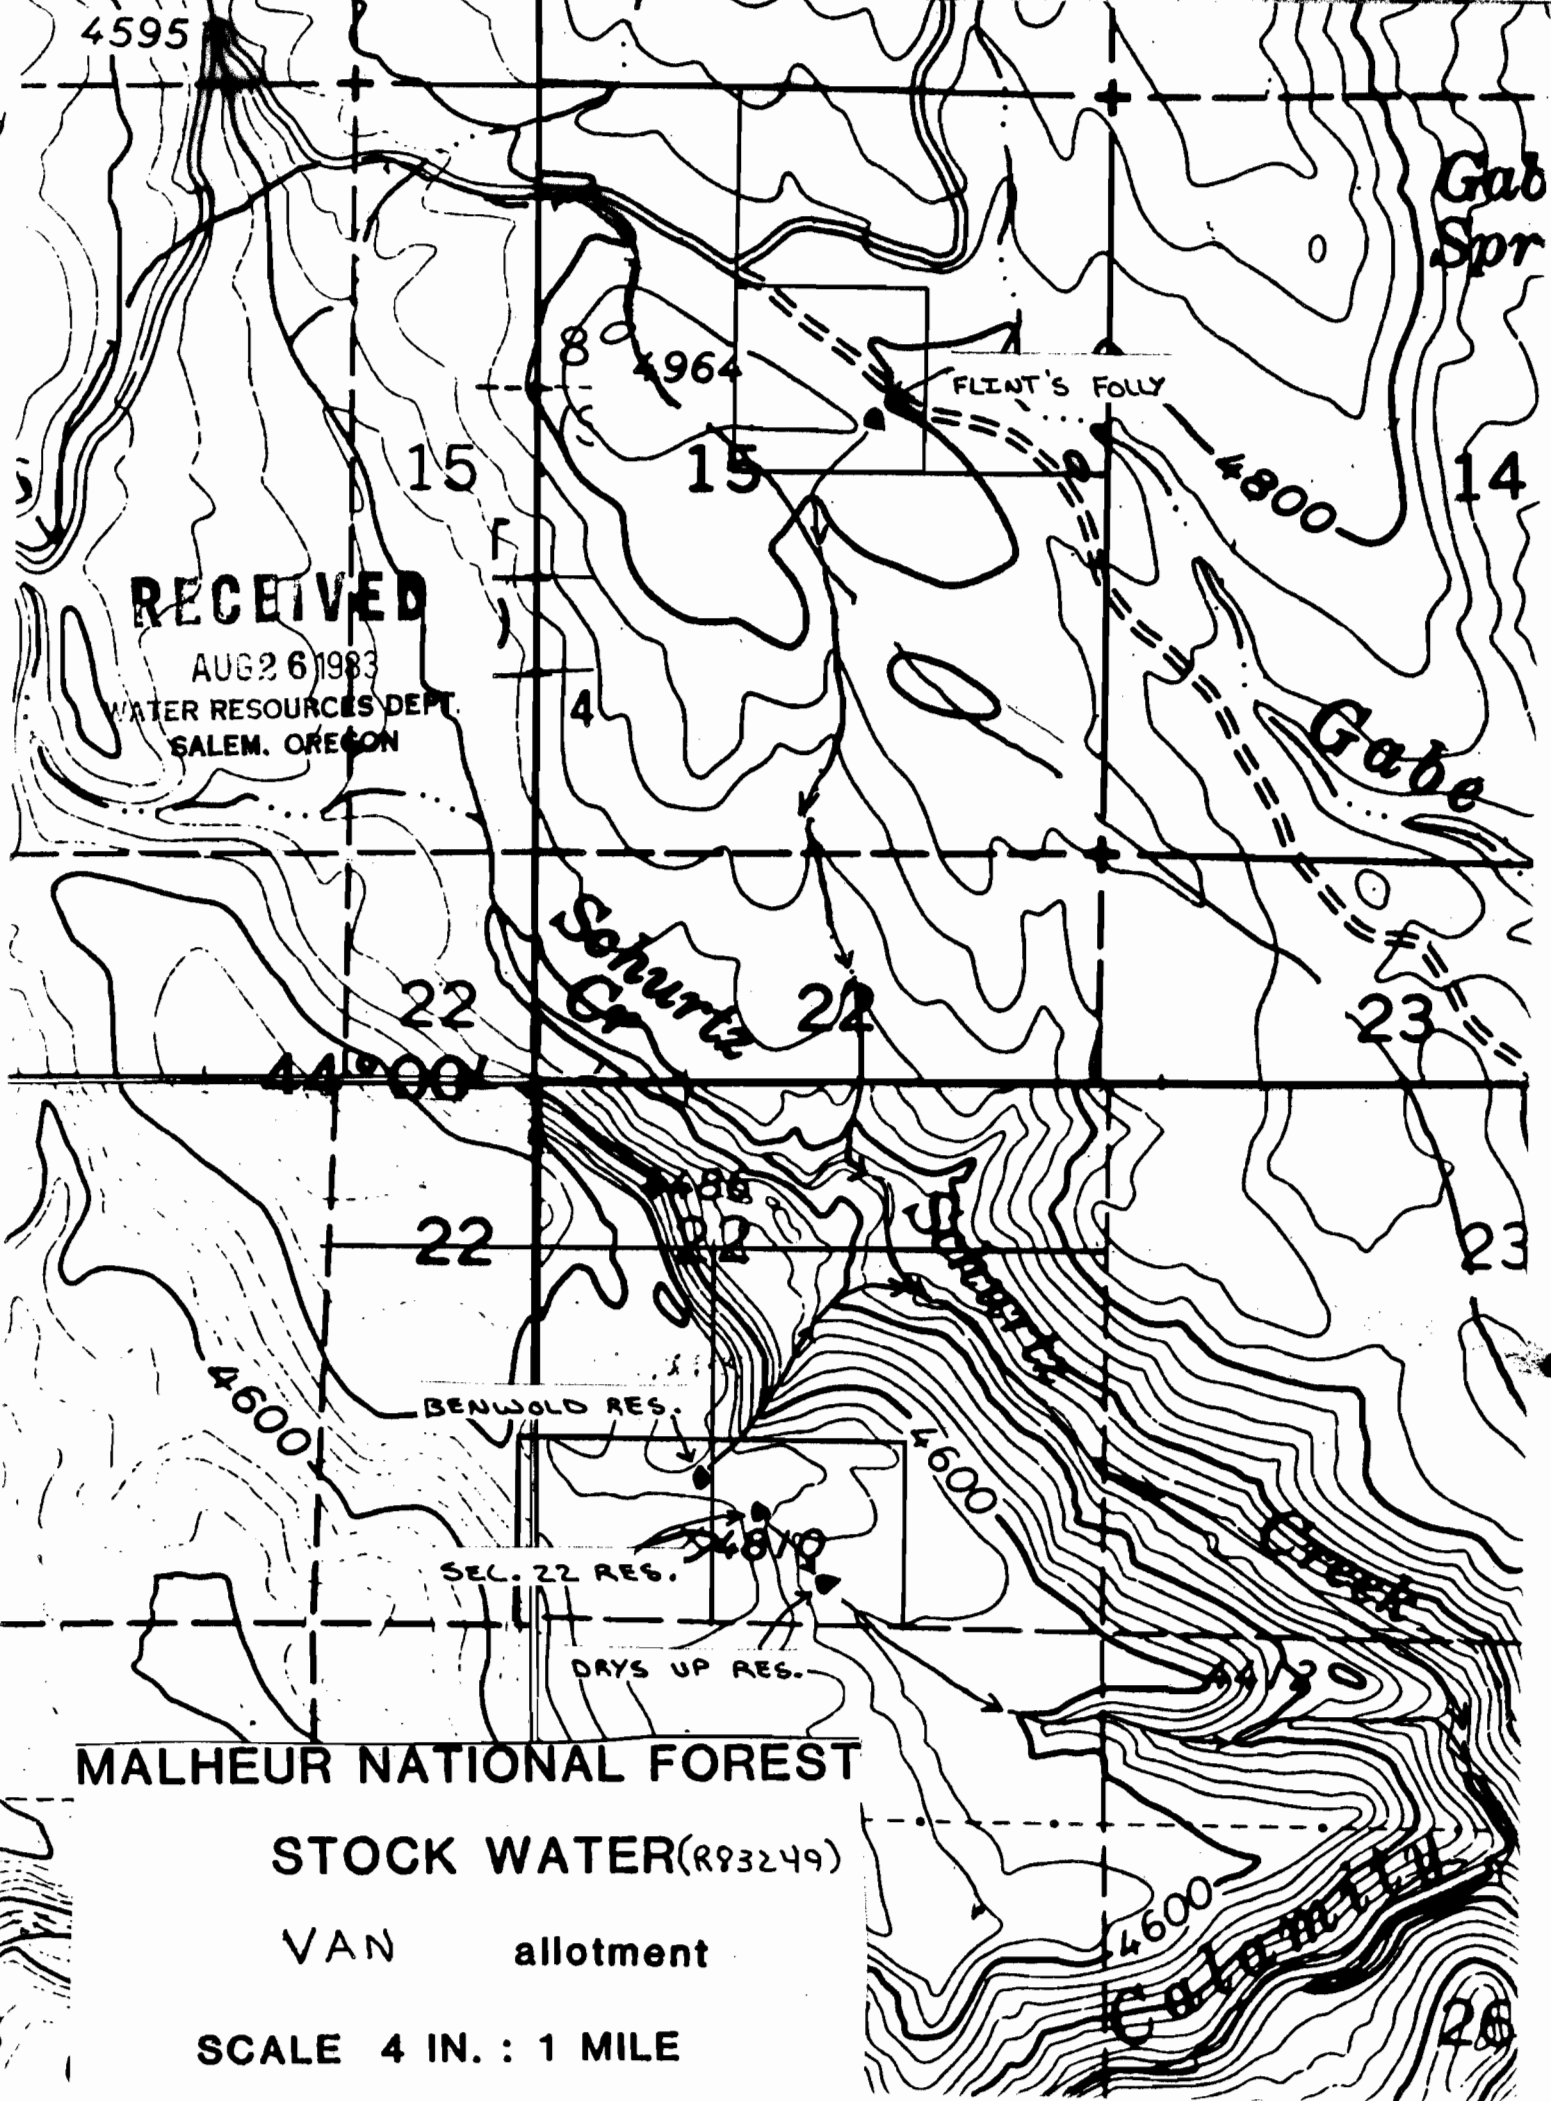

RECEIVED

AUG 26 1983

WATER RESOURCES DEPT.
SALEM, OREGON

FLINT'S FOLLY

Gab
Spr

Gabe

Schurte

BENWOLD RES.

SEC. 22 RES.

DRYS UP RES.

MALHEUR NATIONAL FOREST

STOCK WATER(R93249)

VAN allotment

SCALE 4 IN. : 1 MILE