


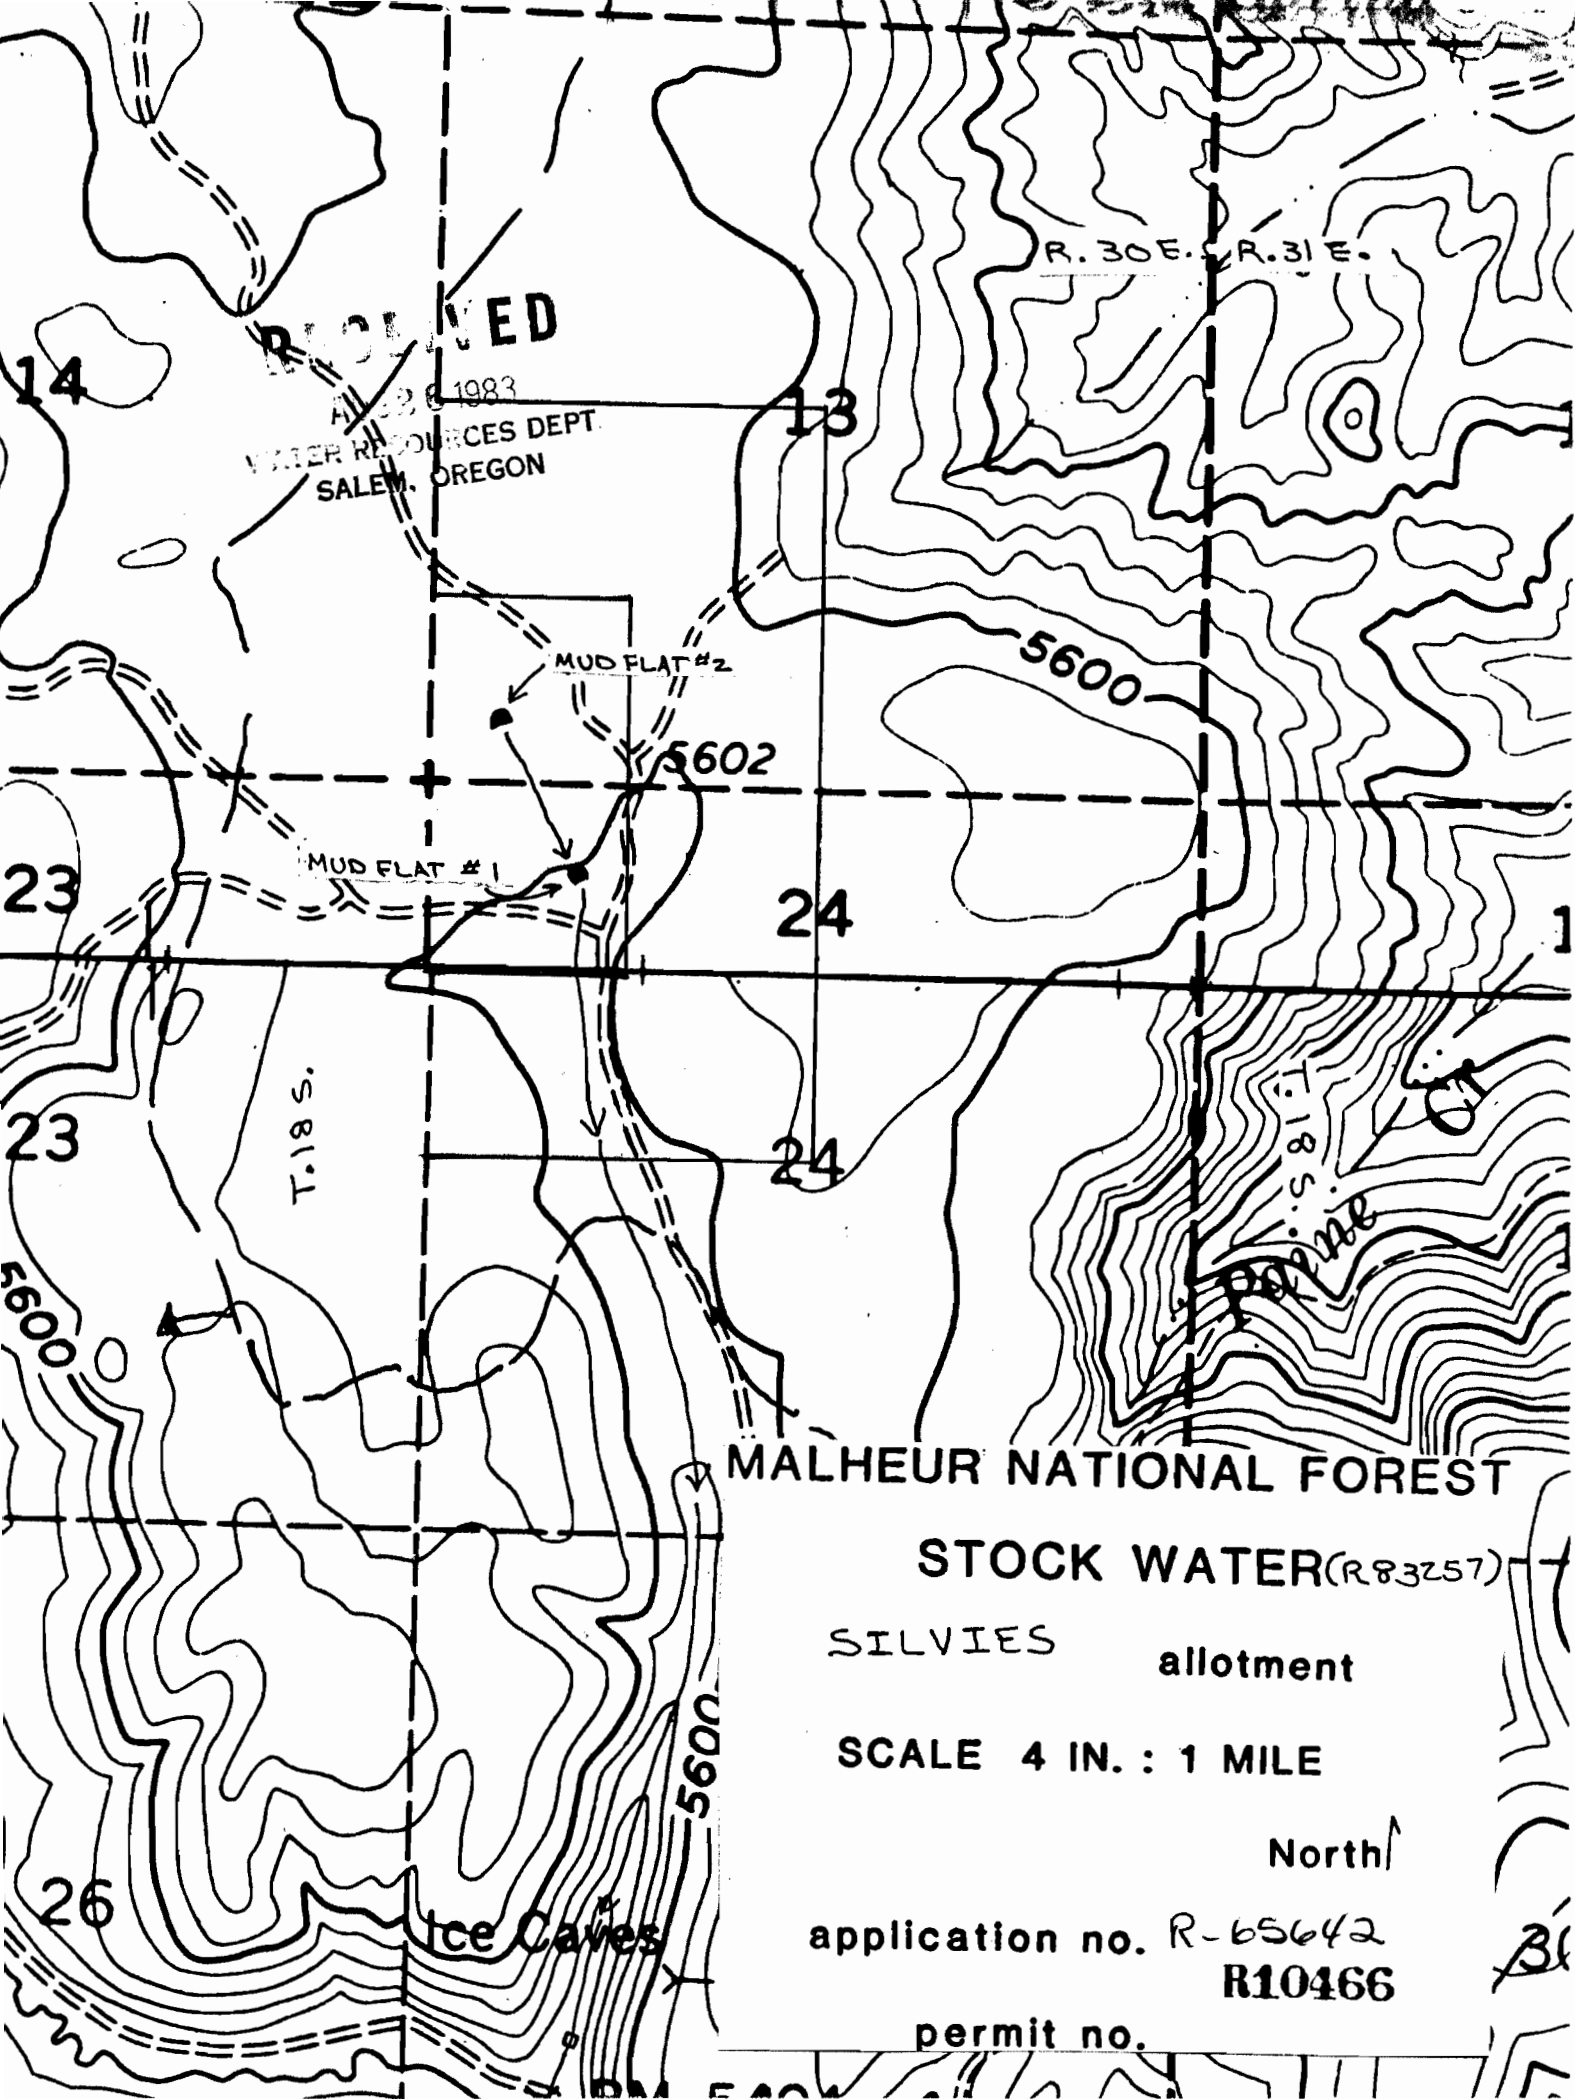

RECEIVED
APR 22 1983
WATER RESOURCES DEPT.
SALEM, OREGON

R. 30 E. R. 31 E.

MUD FLAT #2

MUD FLAT #1

MALHEUR NATIONAL FOREST

STOCK WATER(R83257)

SILVIES allotment

SCALE 4 IN. : 1 MILE

North ↑

application no. R-65642
R10466

permit no.

Ice Caves

B