


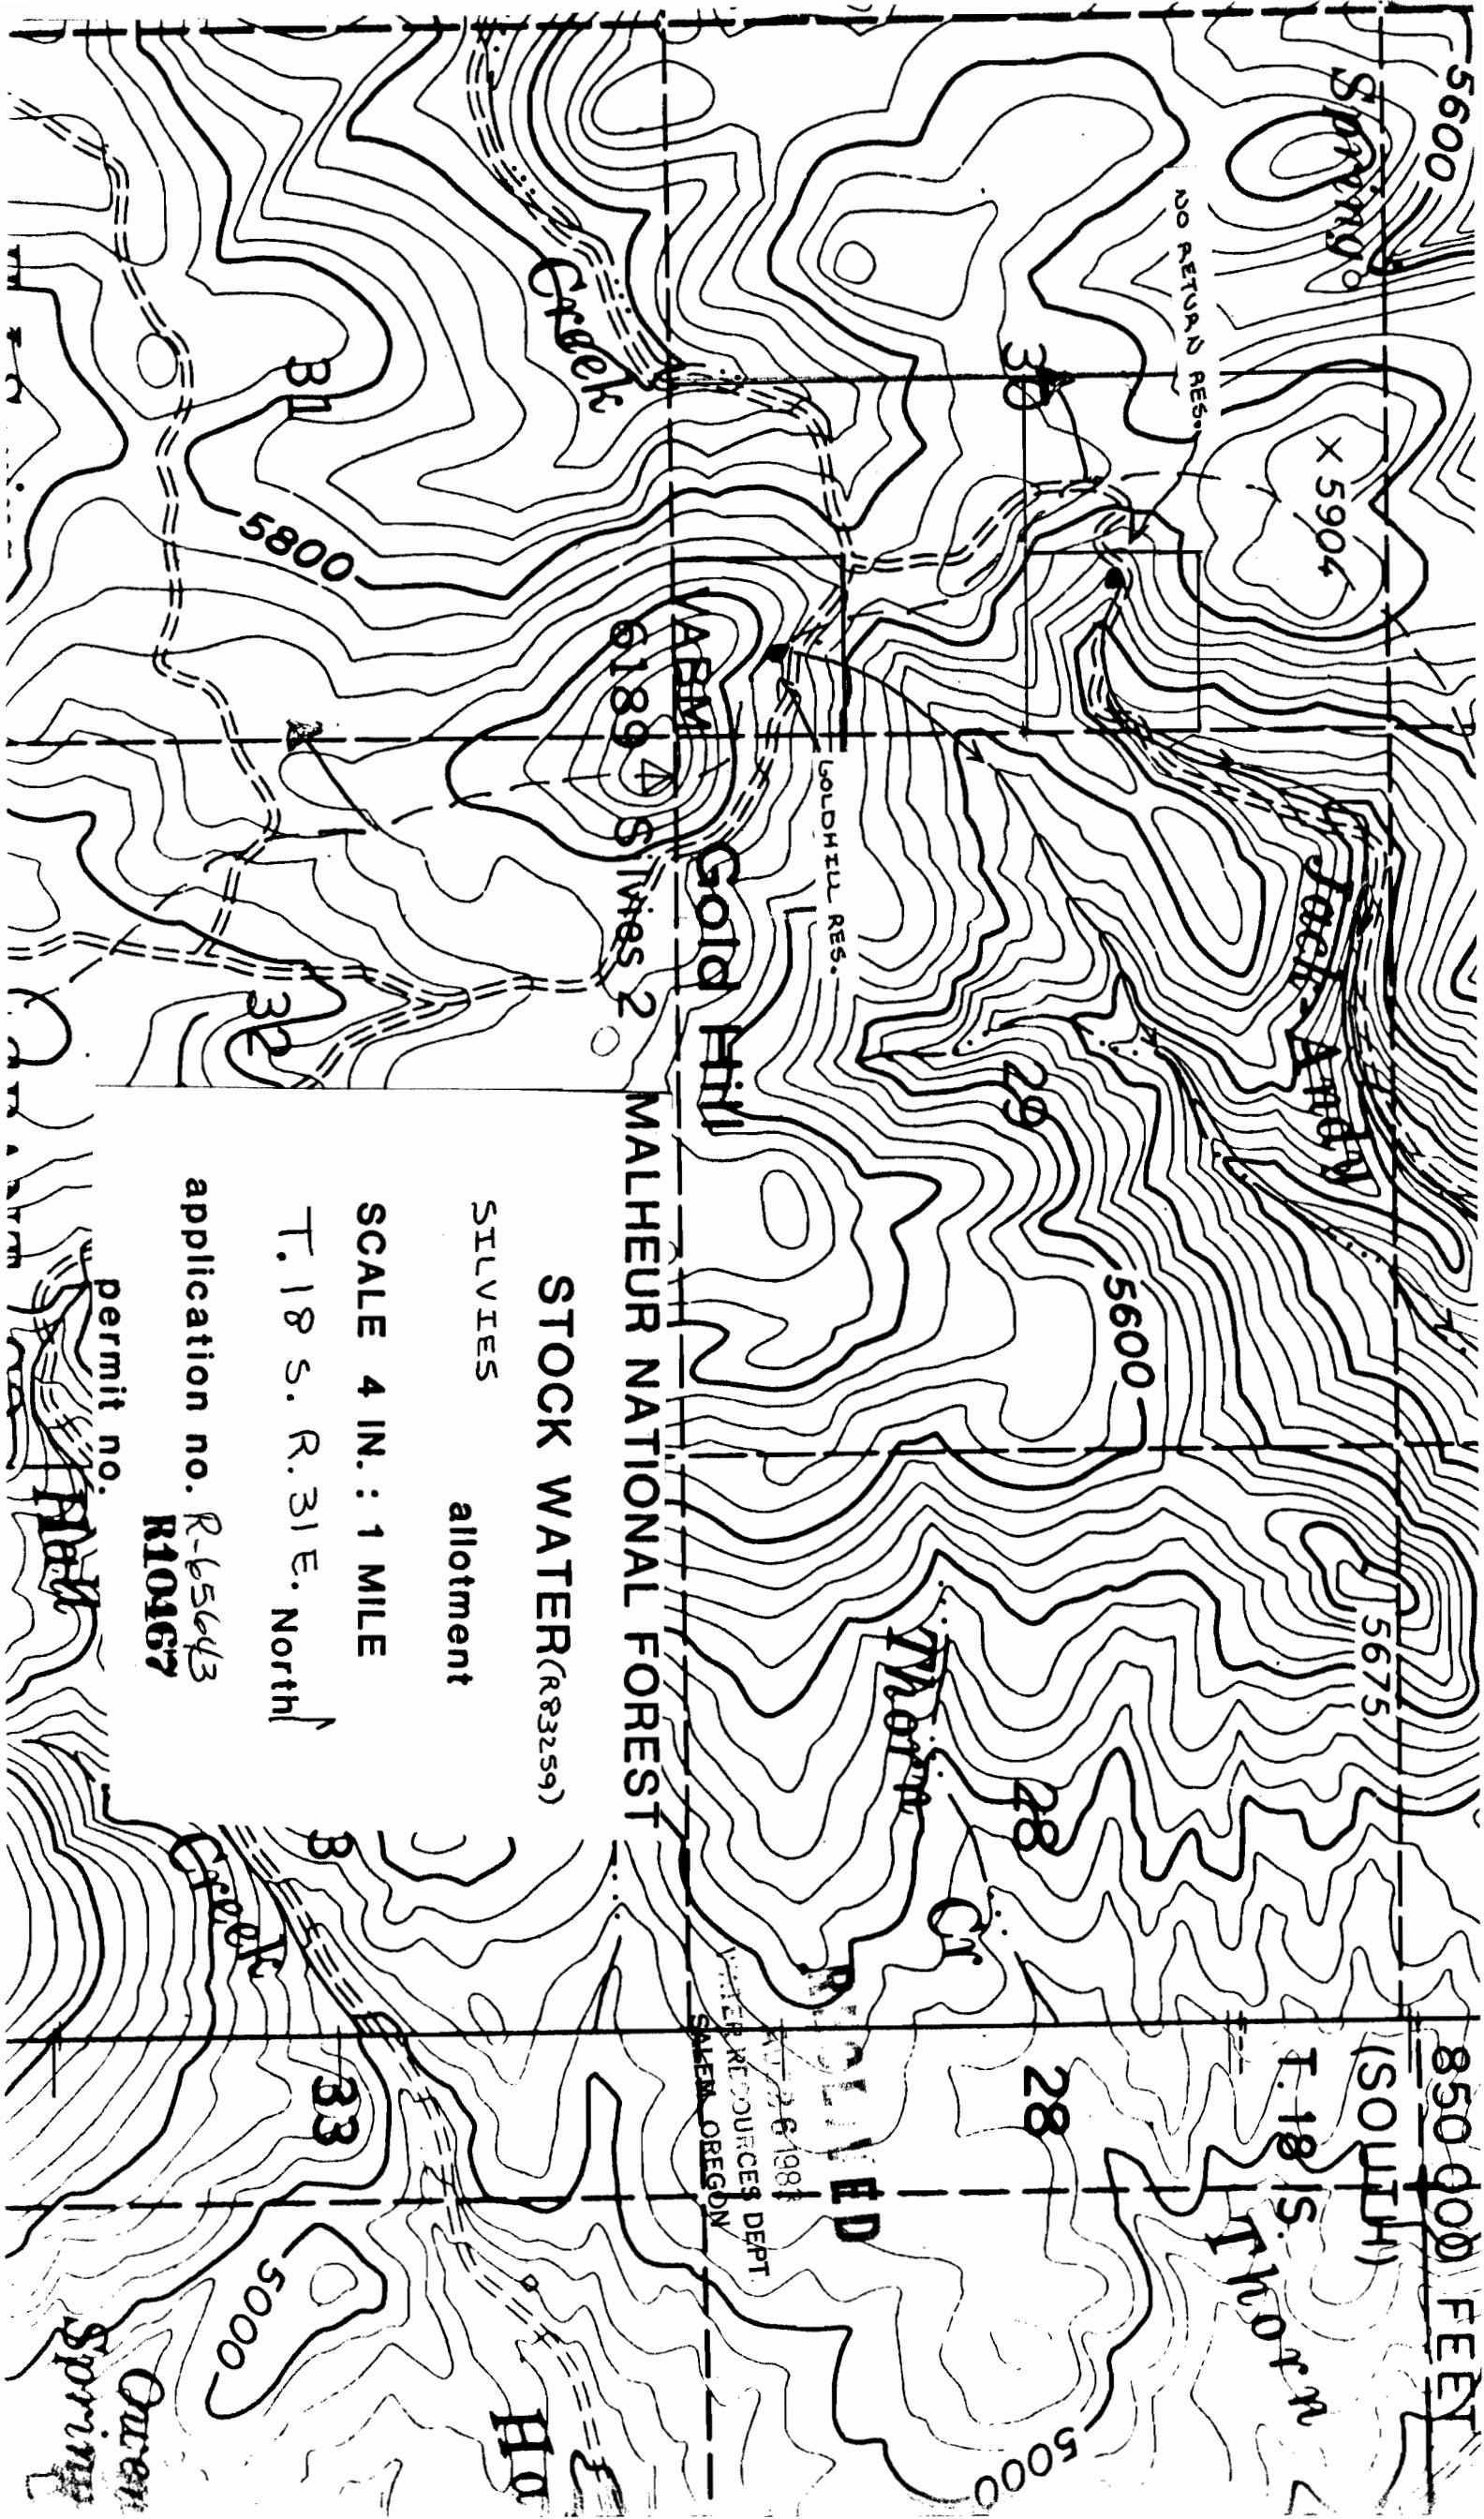

5600

Spring

X 5904

NO RETURN RES.

30

GOLD HILL RES.

6189

Silvies 2

Gold Hill

MALHEUR NATIONAL FOREST

STOCK WATER (R83259)

SILVIES

allotment

SCALE 4 IN. : 1 MILE

T. 18 S. R. 31 E. North

application no. R-65643

R10467

permit no.

PHD

5675

(SOUTH)


28

28

North

Cr

PHD

26 1981

WATER RESOURCES DEPT.

HO

33

Creek

5000

Queen Spring