


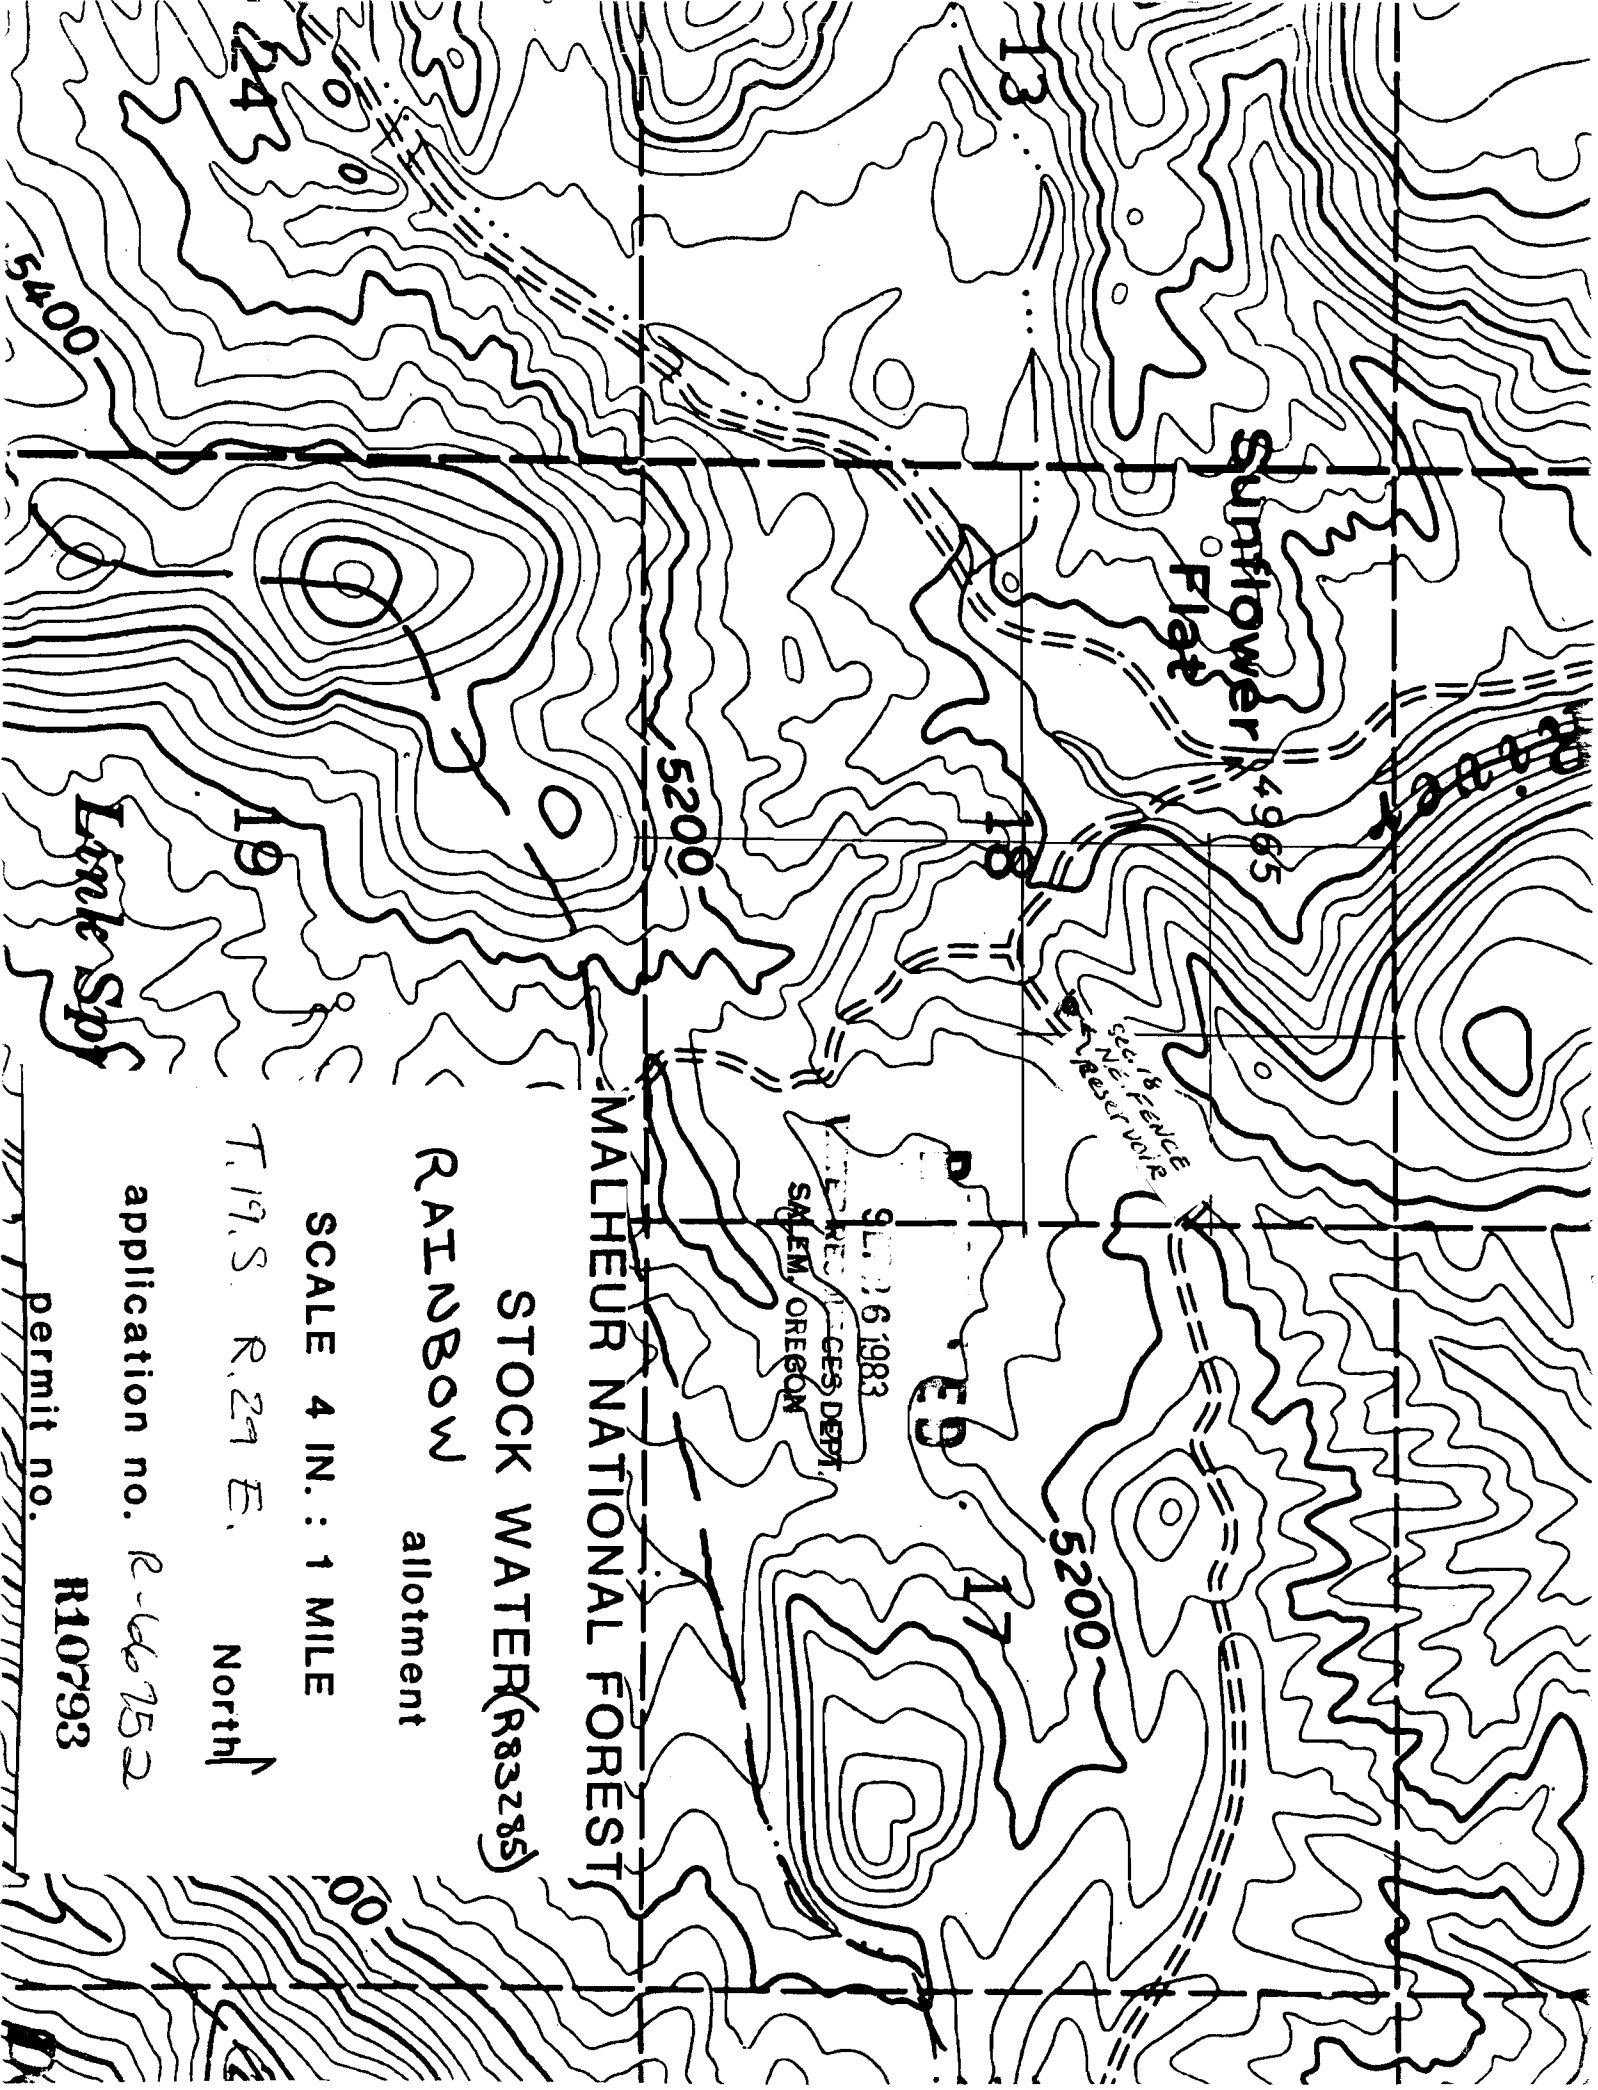

Sunflower Flat 4965


MALHEUR NATIONAL FOREST

STOCK WATER(R83285)

RAINBOW allotment

SCALE 4 IN. : 1 MILE

T. 19. S. R. 29 E. North

application no. R-66752

Leuk Sp

permit no.

R10793