


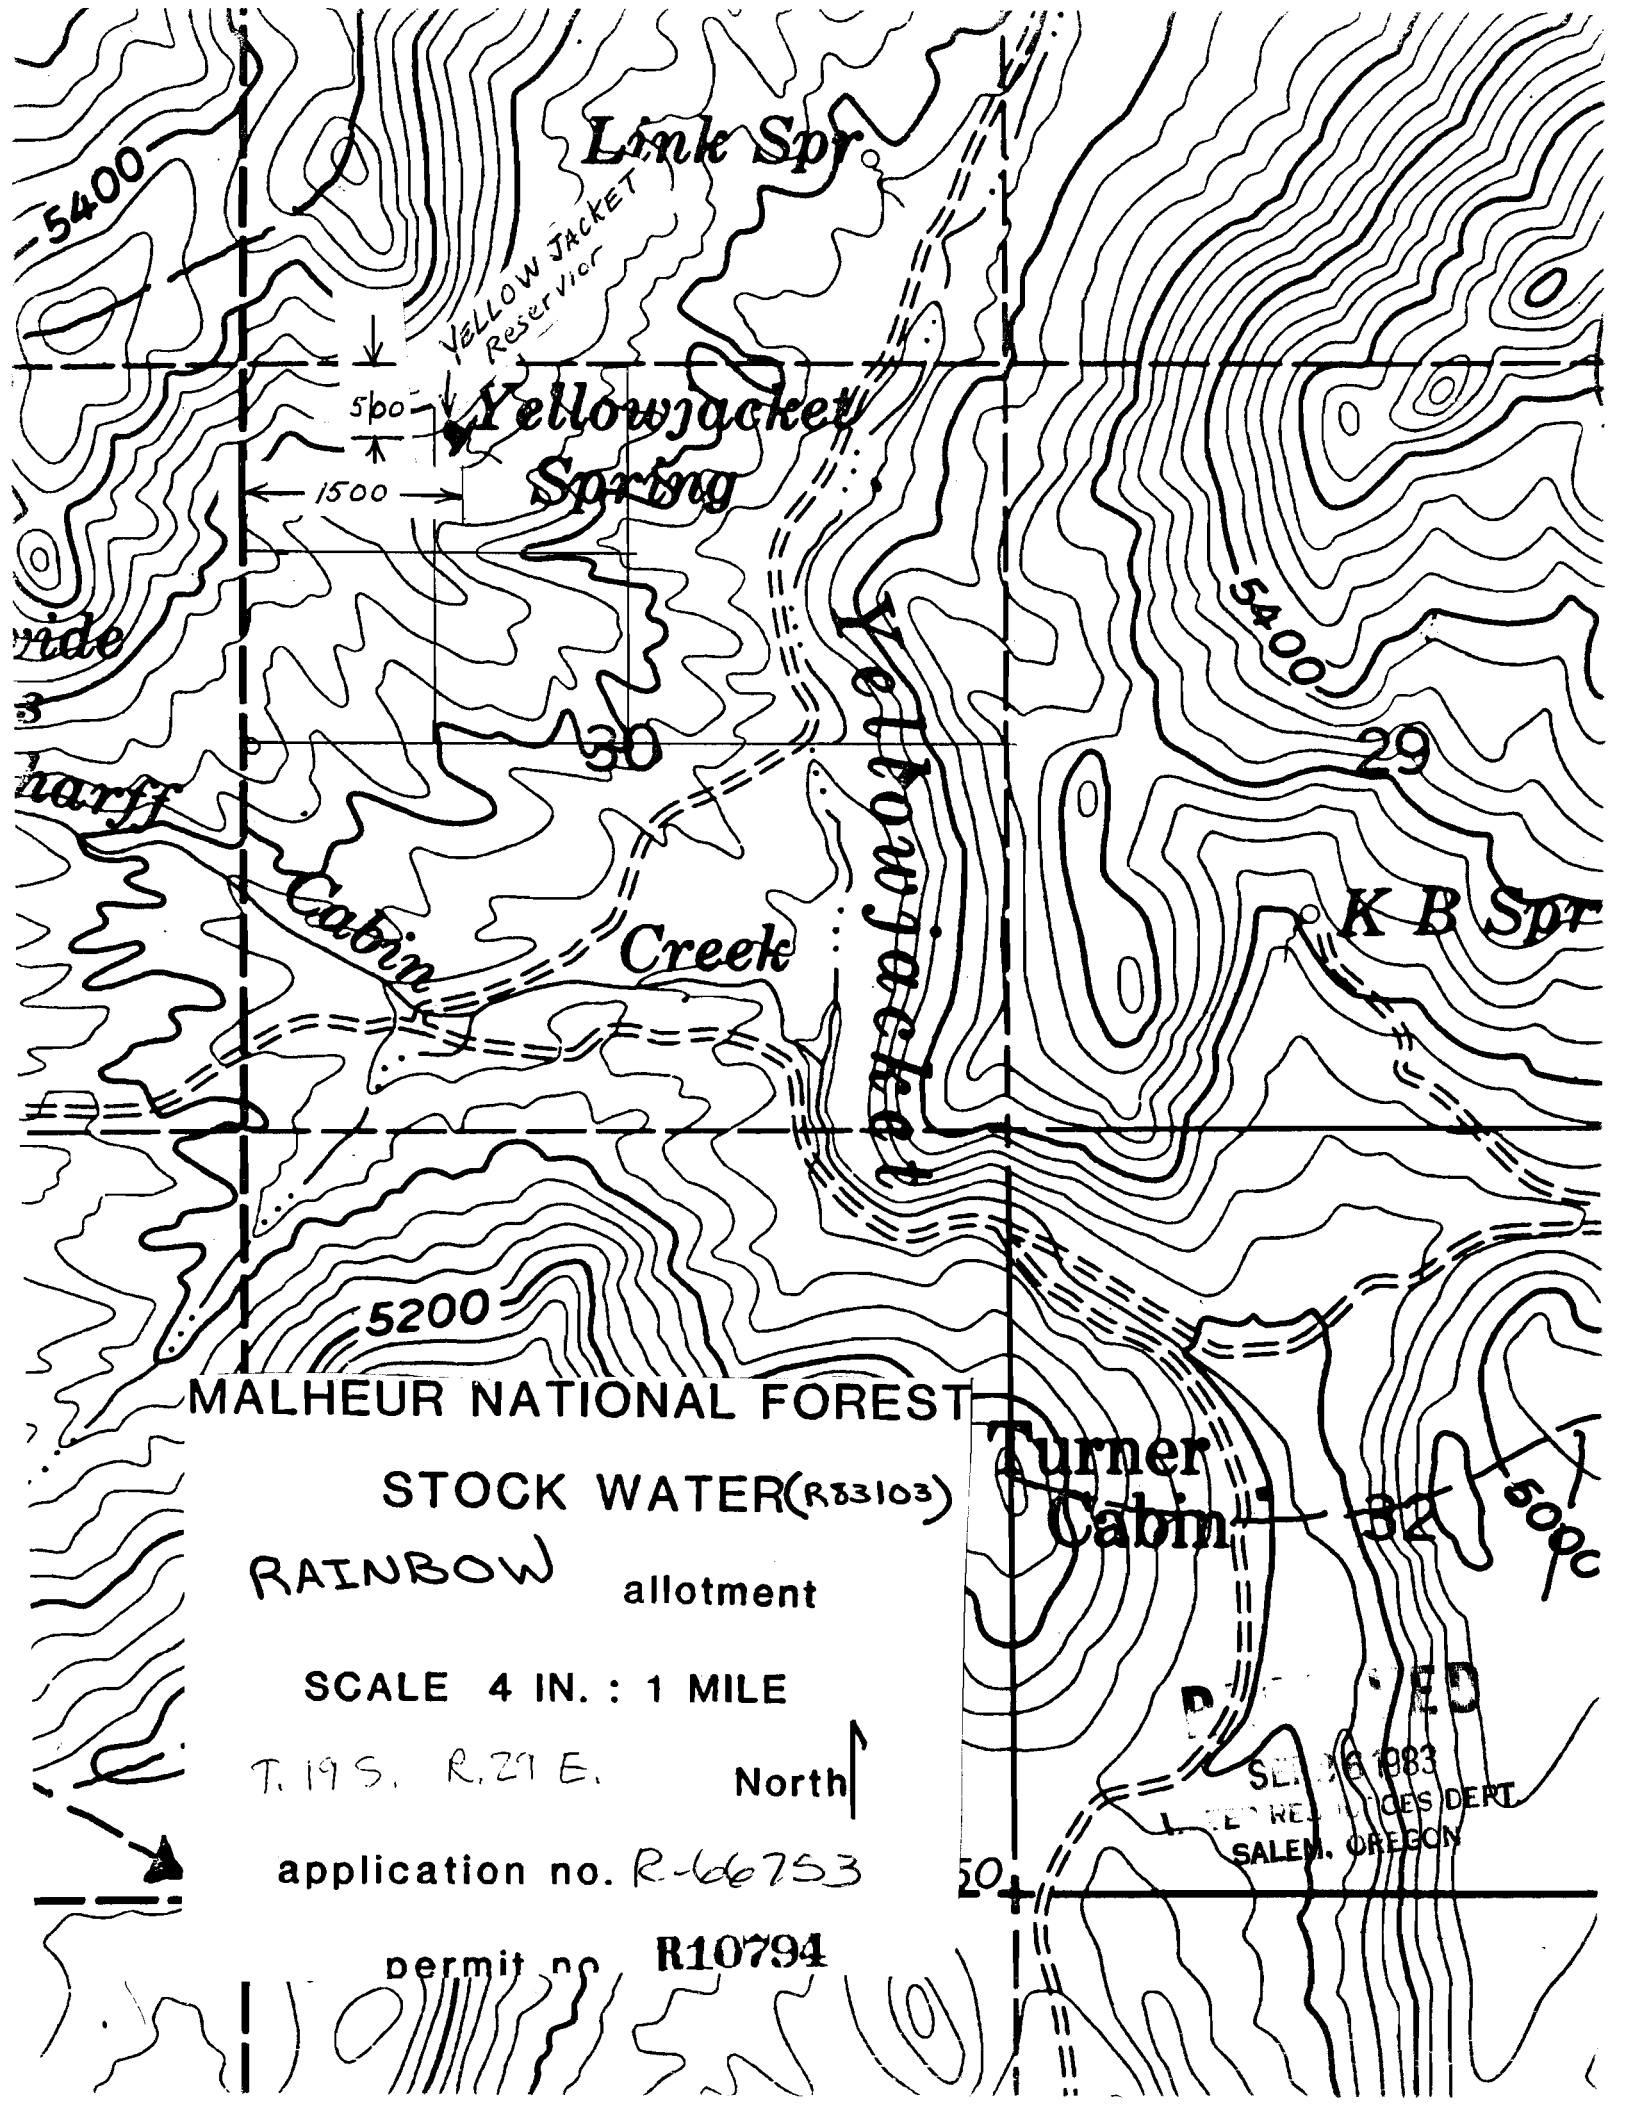

Link Spr.

Yellow Jacket
Reservoir

Yellowjacket
Spring

5400

500

1500

30

5400

29

Cabin

Creek

Yellowjacket

K B Spr

5200

MALHEUR NATIONAL FOREST

STOCK WATER (R83103)

RAINBOW allotment

SCALE 4 IN. : 1 MILE

T. 19 S. R. 21 E.

North ↑

application no. R-66753

permit no. R10794

Turner
Cabin

32

5000

SALEM, OREGON