

IALHEUR NATIONAL FOREST

STOCK WATER(R83197)


PIKE CREEK allotment

SCALE 4 IN. : 1 MILE

T. 21 S. R. 83 1/2 E North

application no. R-66756

permit no. R10797

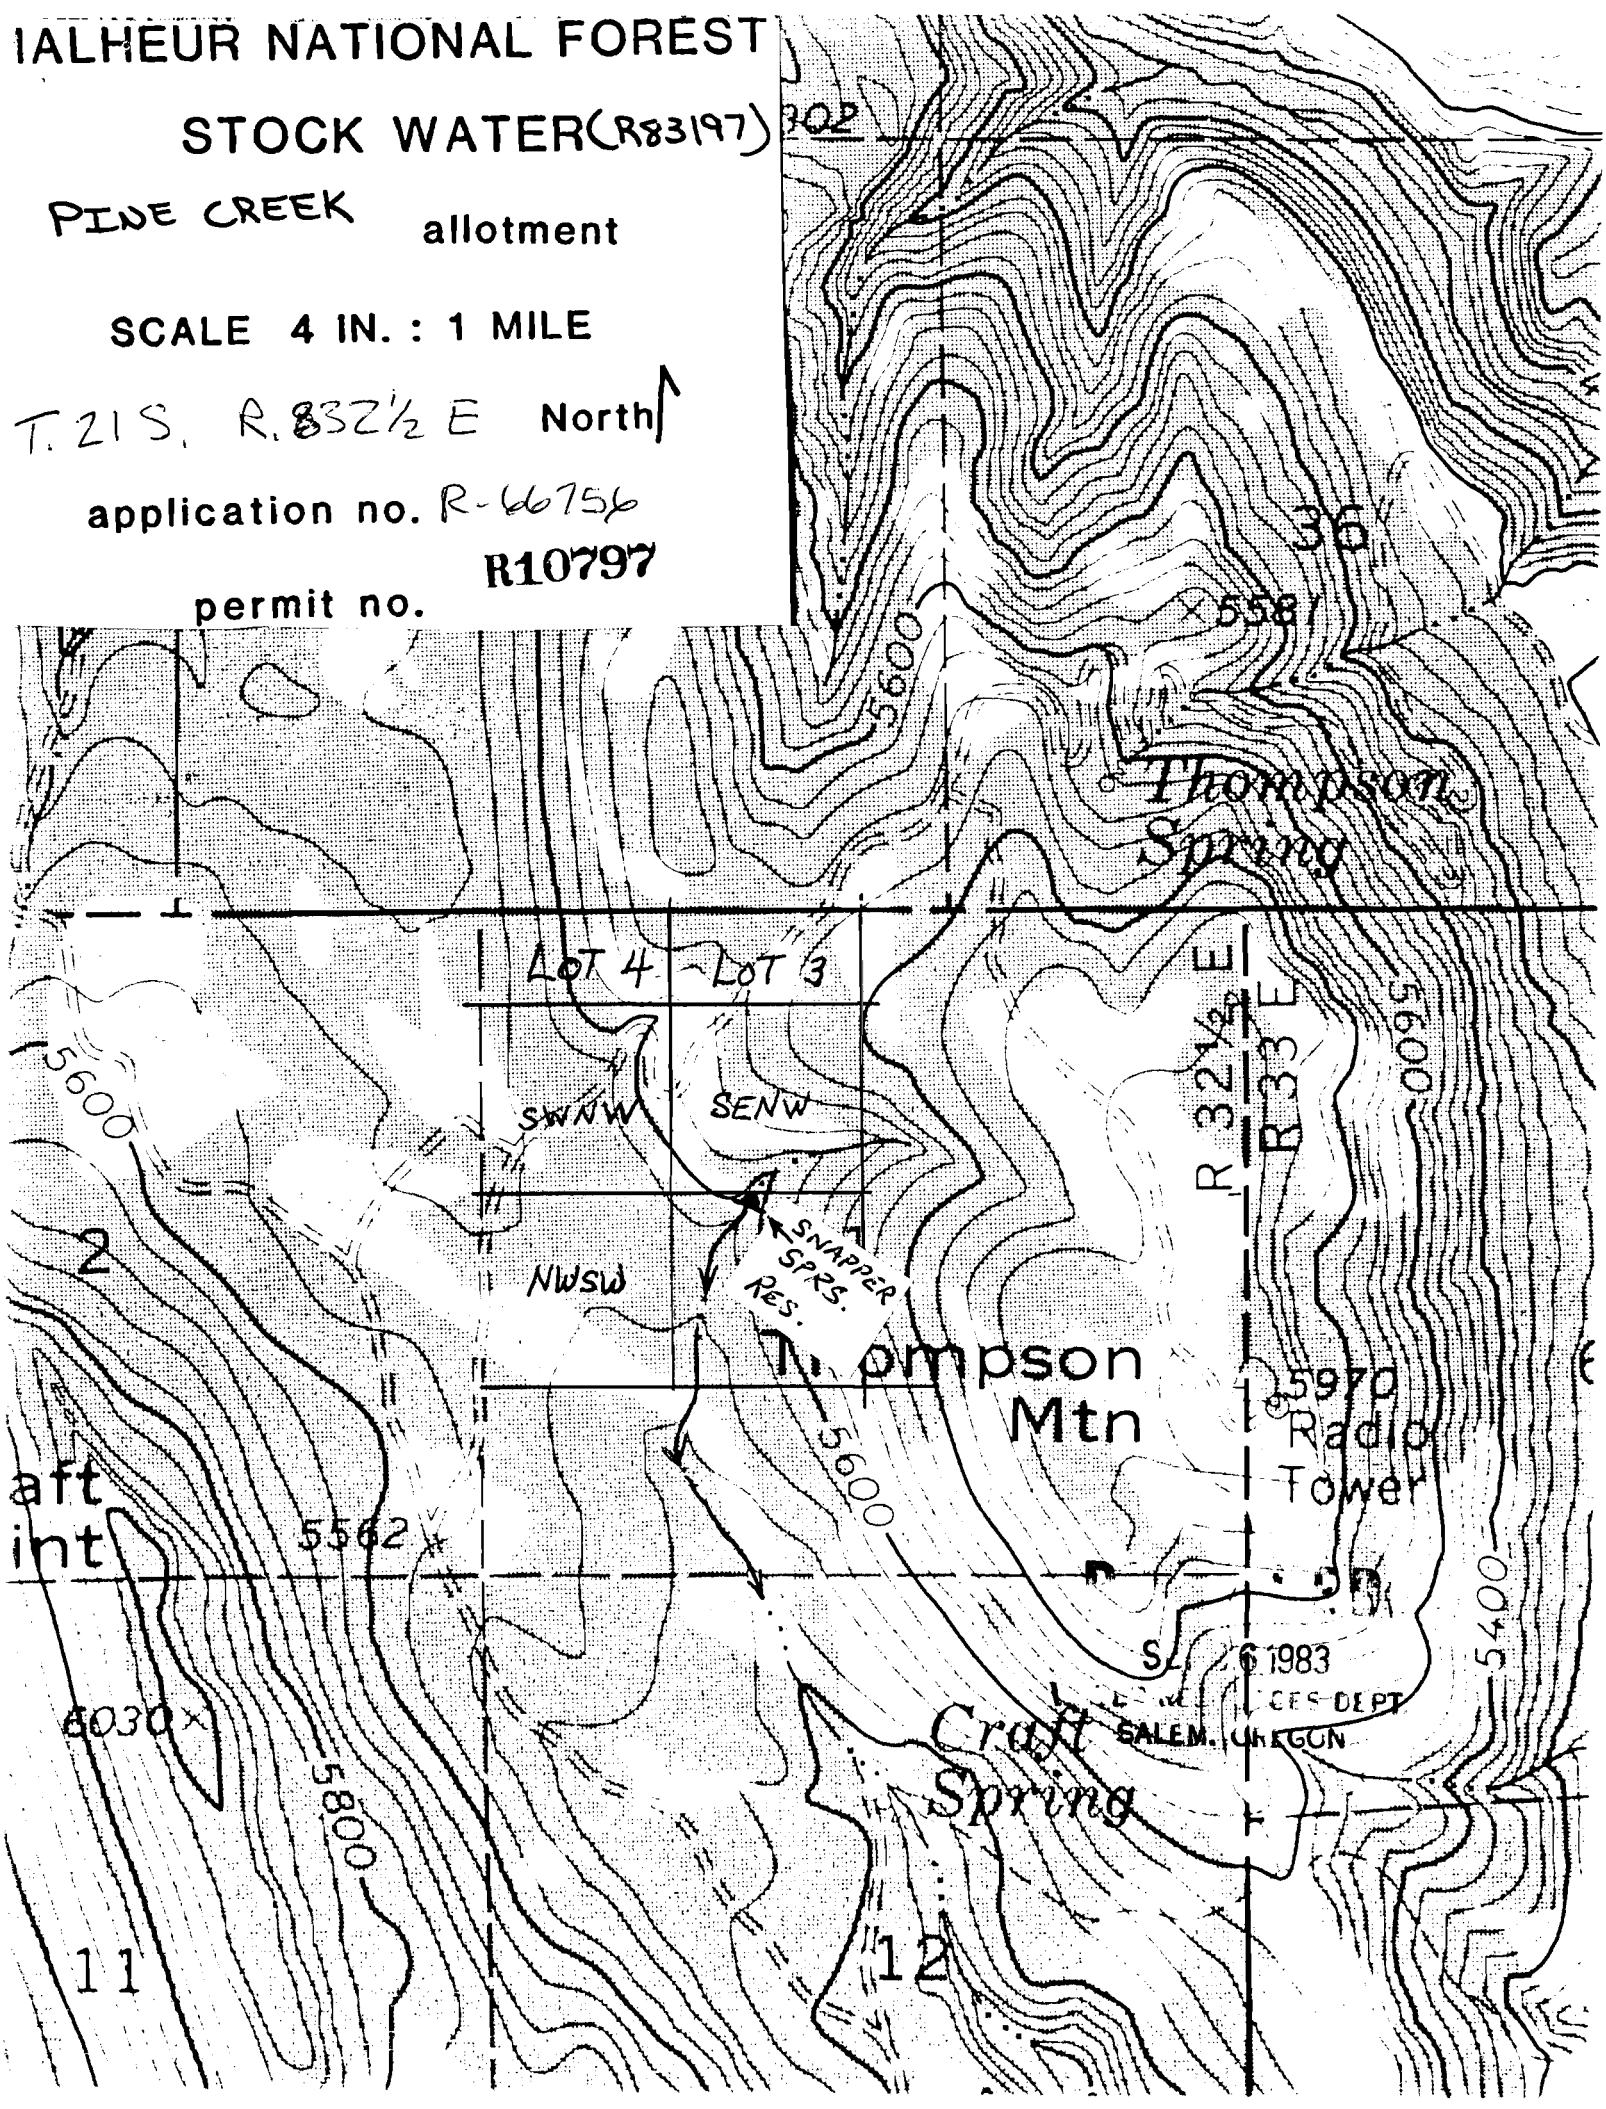

aft
int

6030x

11

12

SL 61983
CES-DEPT
SALEM, OREGON