


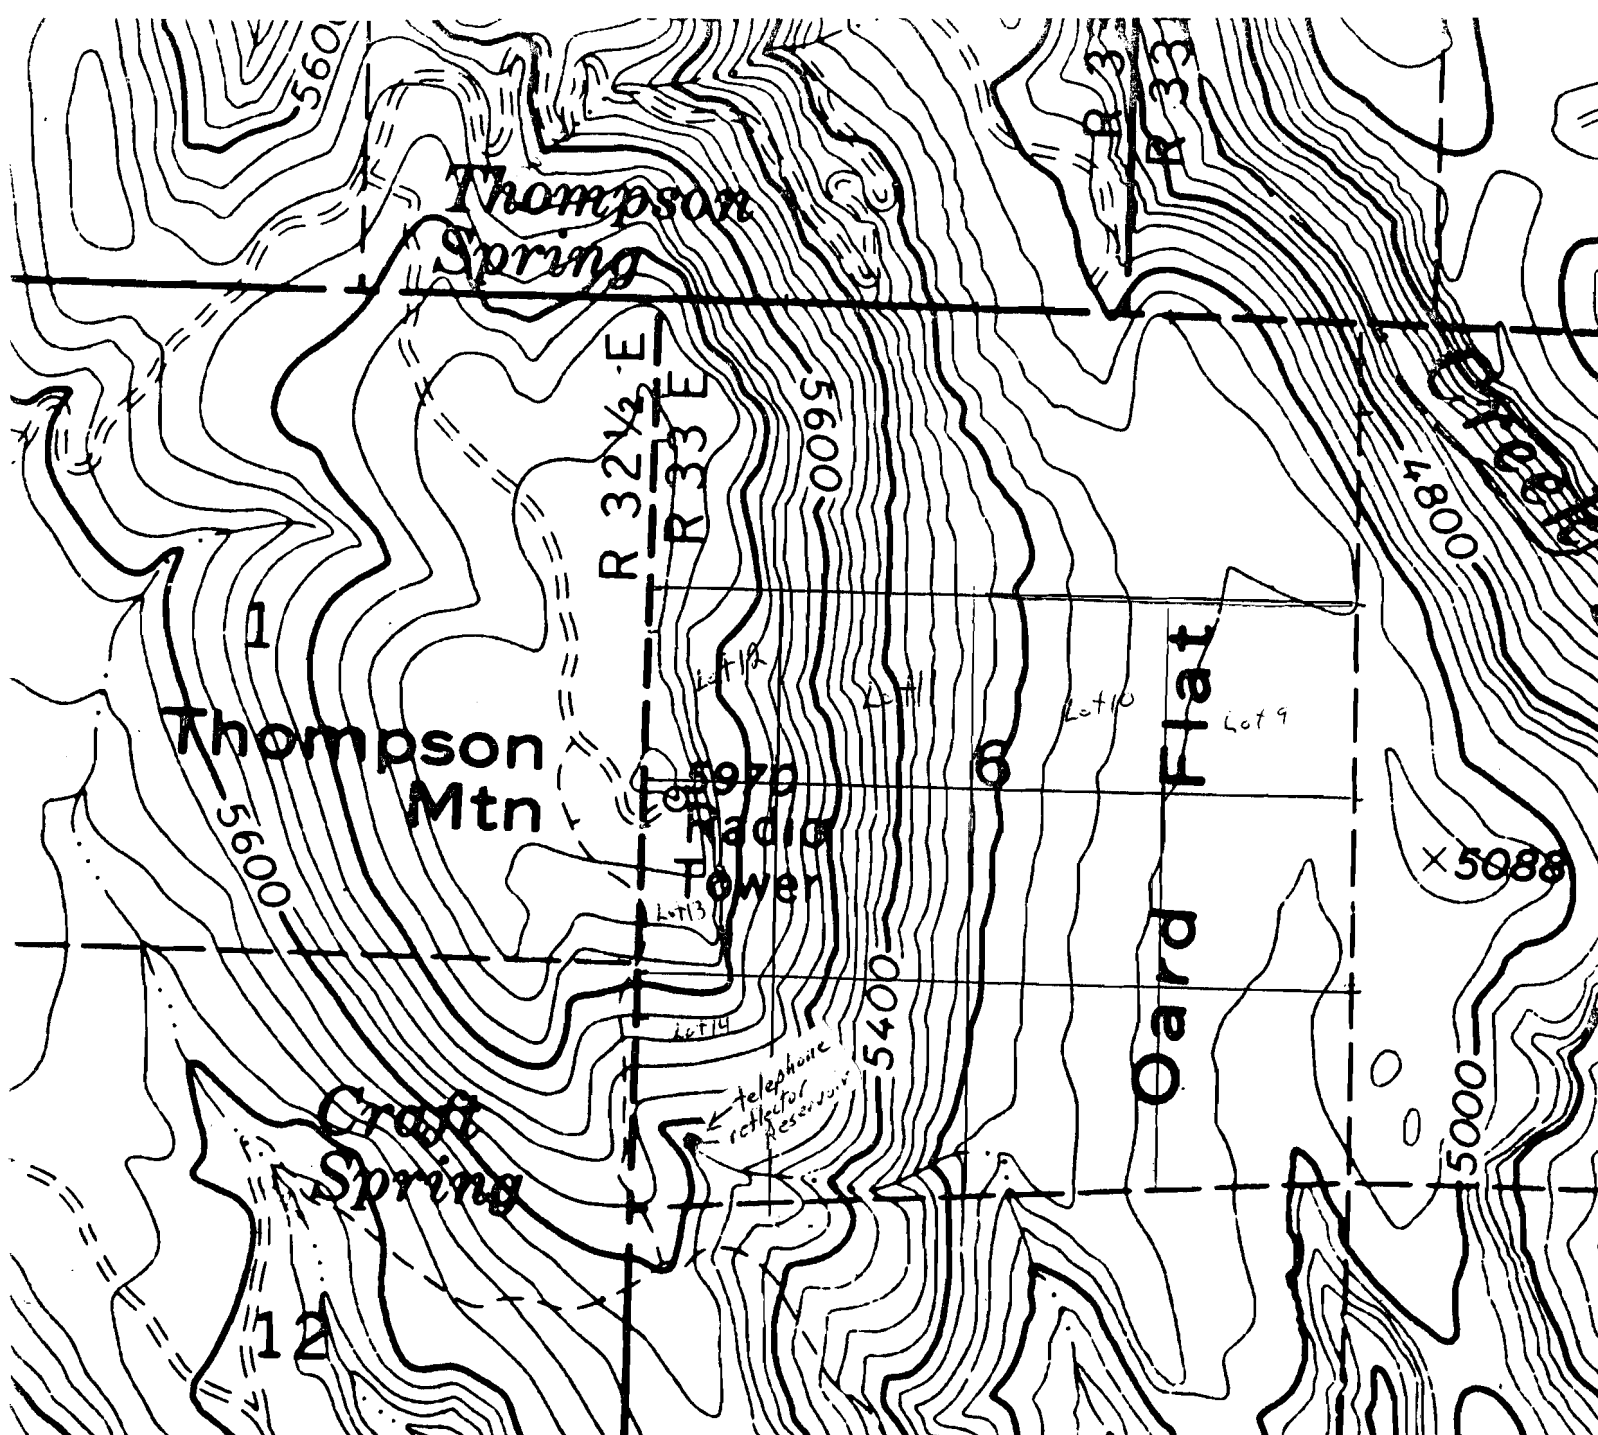

MALHEUR NATIONAL FOREST

STOCK WATER(R83195)

PINE CREEK allotment

SCALE 4 IN. : 1 MILE

T. 21 S. R. 33 E North ↑

application no. R-66757
R10798

permit no.

RECEIVED

SEP 26 1983

WATER RESOURCES DEPT
SALEM, OREGON