

MALHEUR NATIONAL FOREST

STOCK WATER(R83112)

WEST MALHEUR allotment


SCALE 4 IN. : 1 MILE

T. 18 S. R. 33 1/2 E.

North ↑

application no. R-66762

permit no. R10803

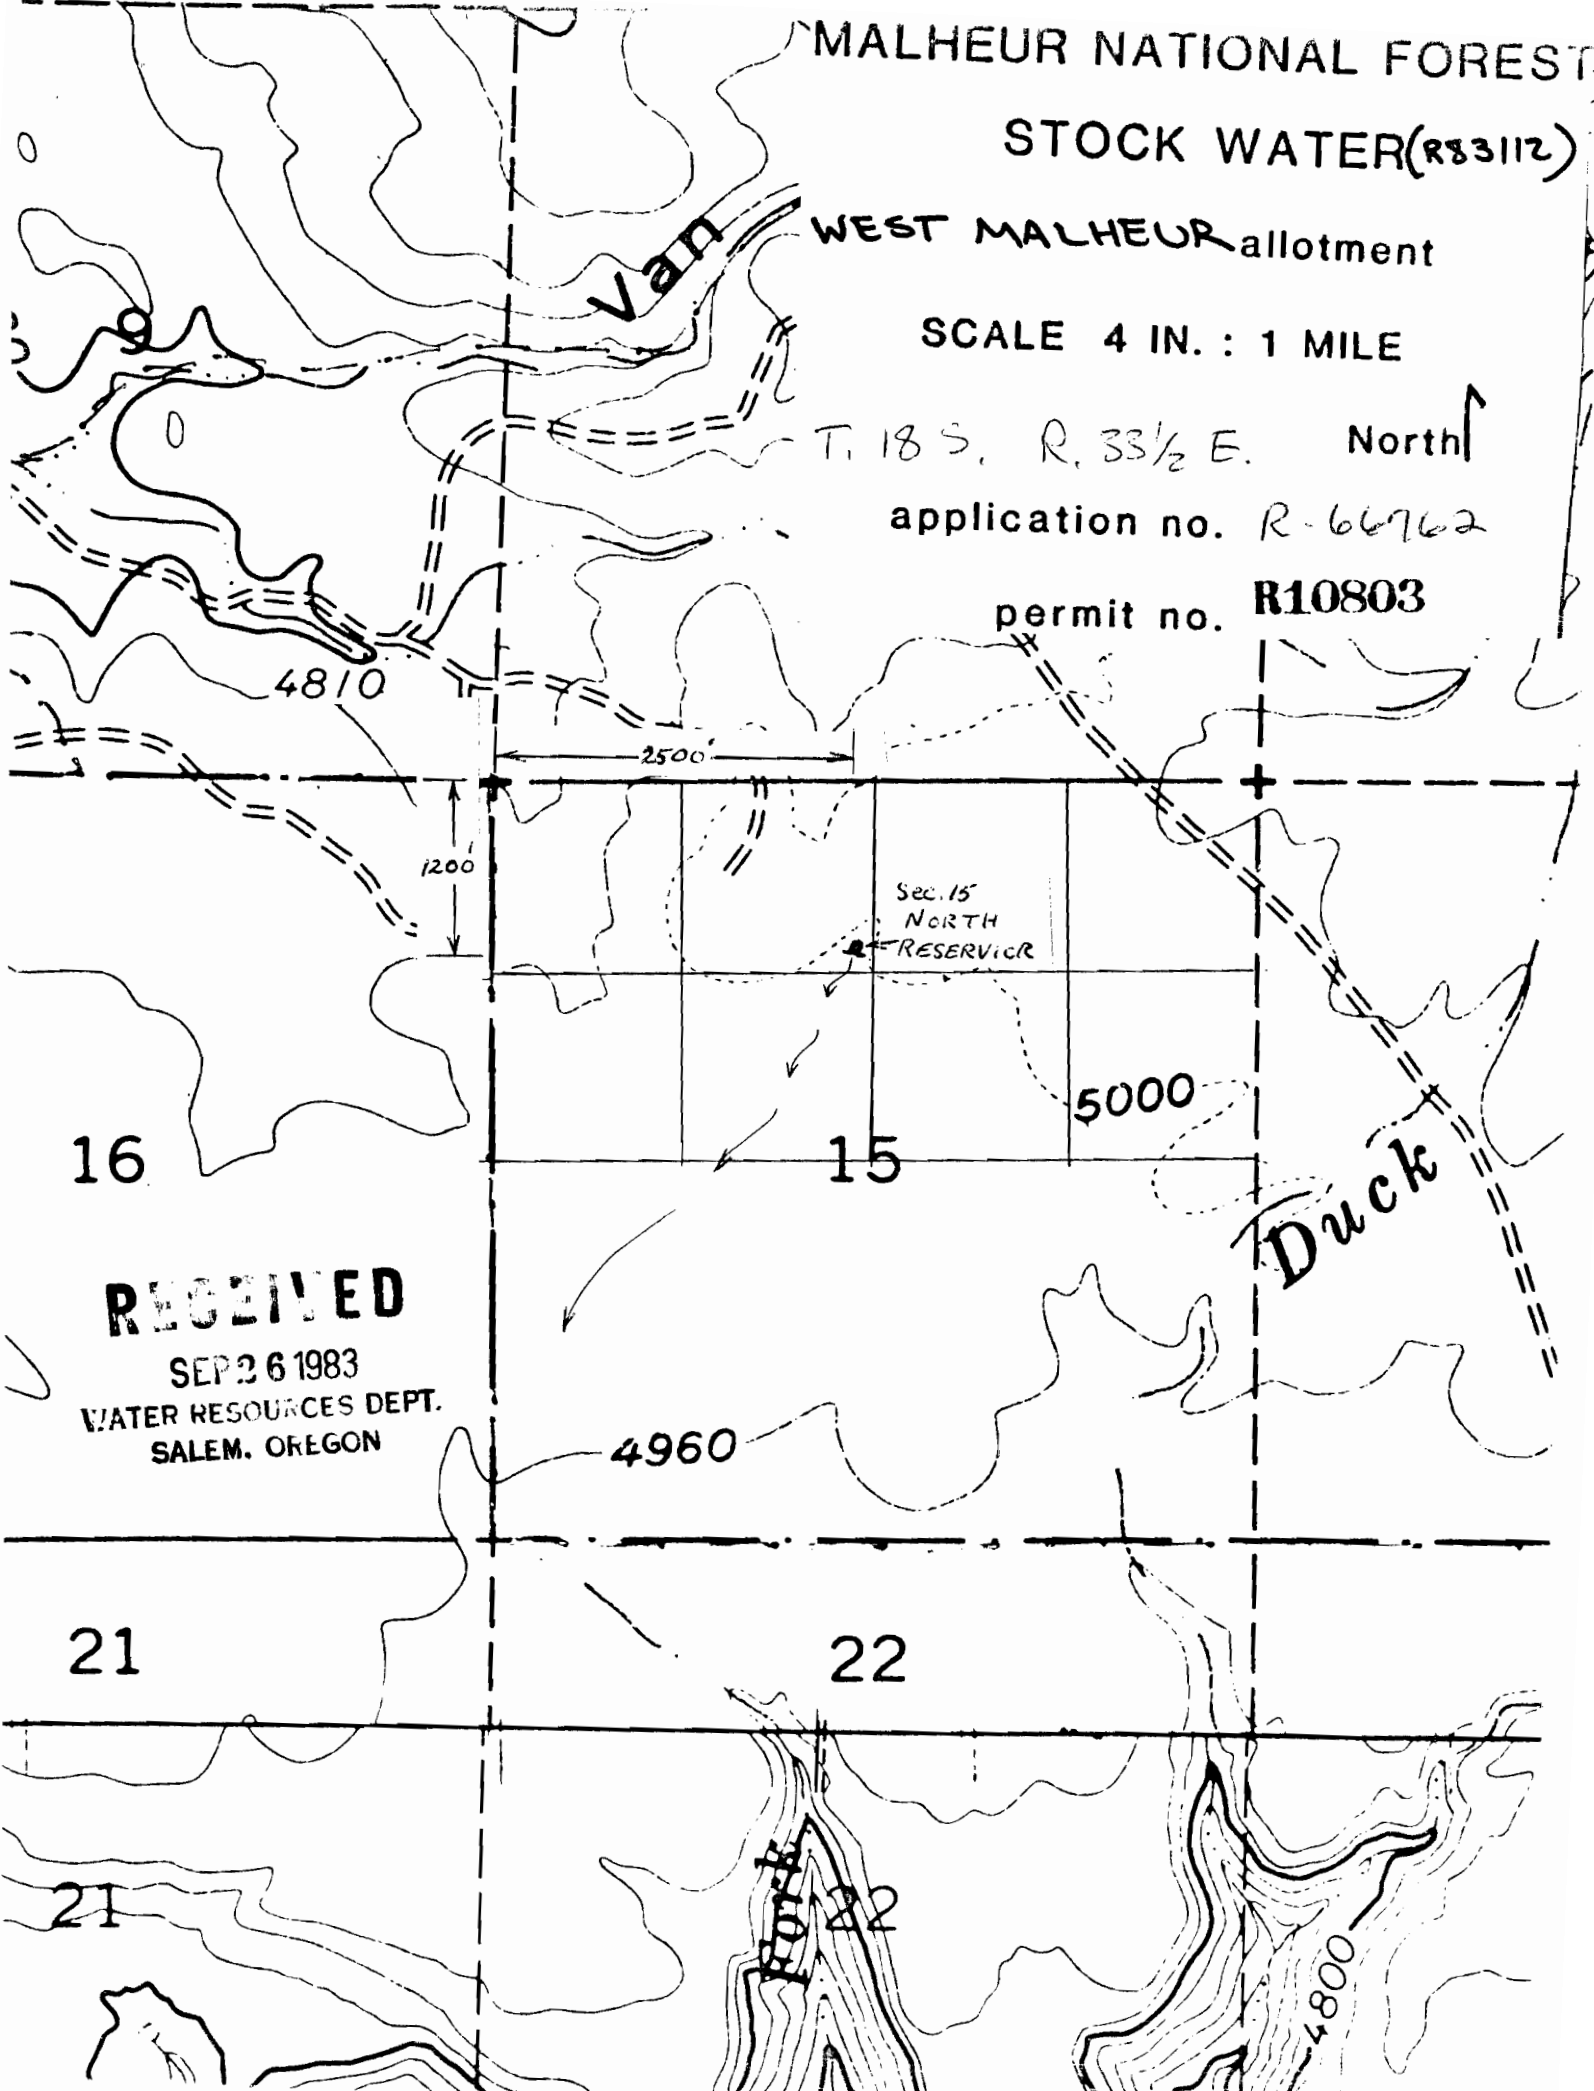

RECEIVED

SEP 26 1983

WATER RESOURCES DEPT.
SALEM, OREGON