

MALHEUR NATIONAL FOREST

STOCK WATER

SLIDE CR. allotment


F.S. Temp I.D. # 83L26

SCALE 4 IN. : 1 MILE

T.10 S. R.32 E. North

application no. R-66828

permit no. R10853

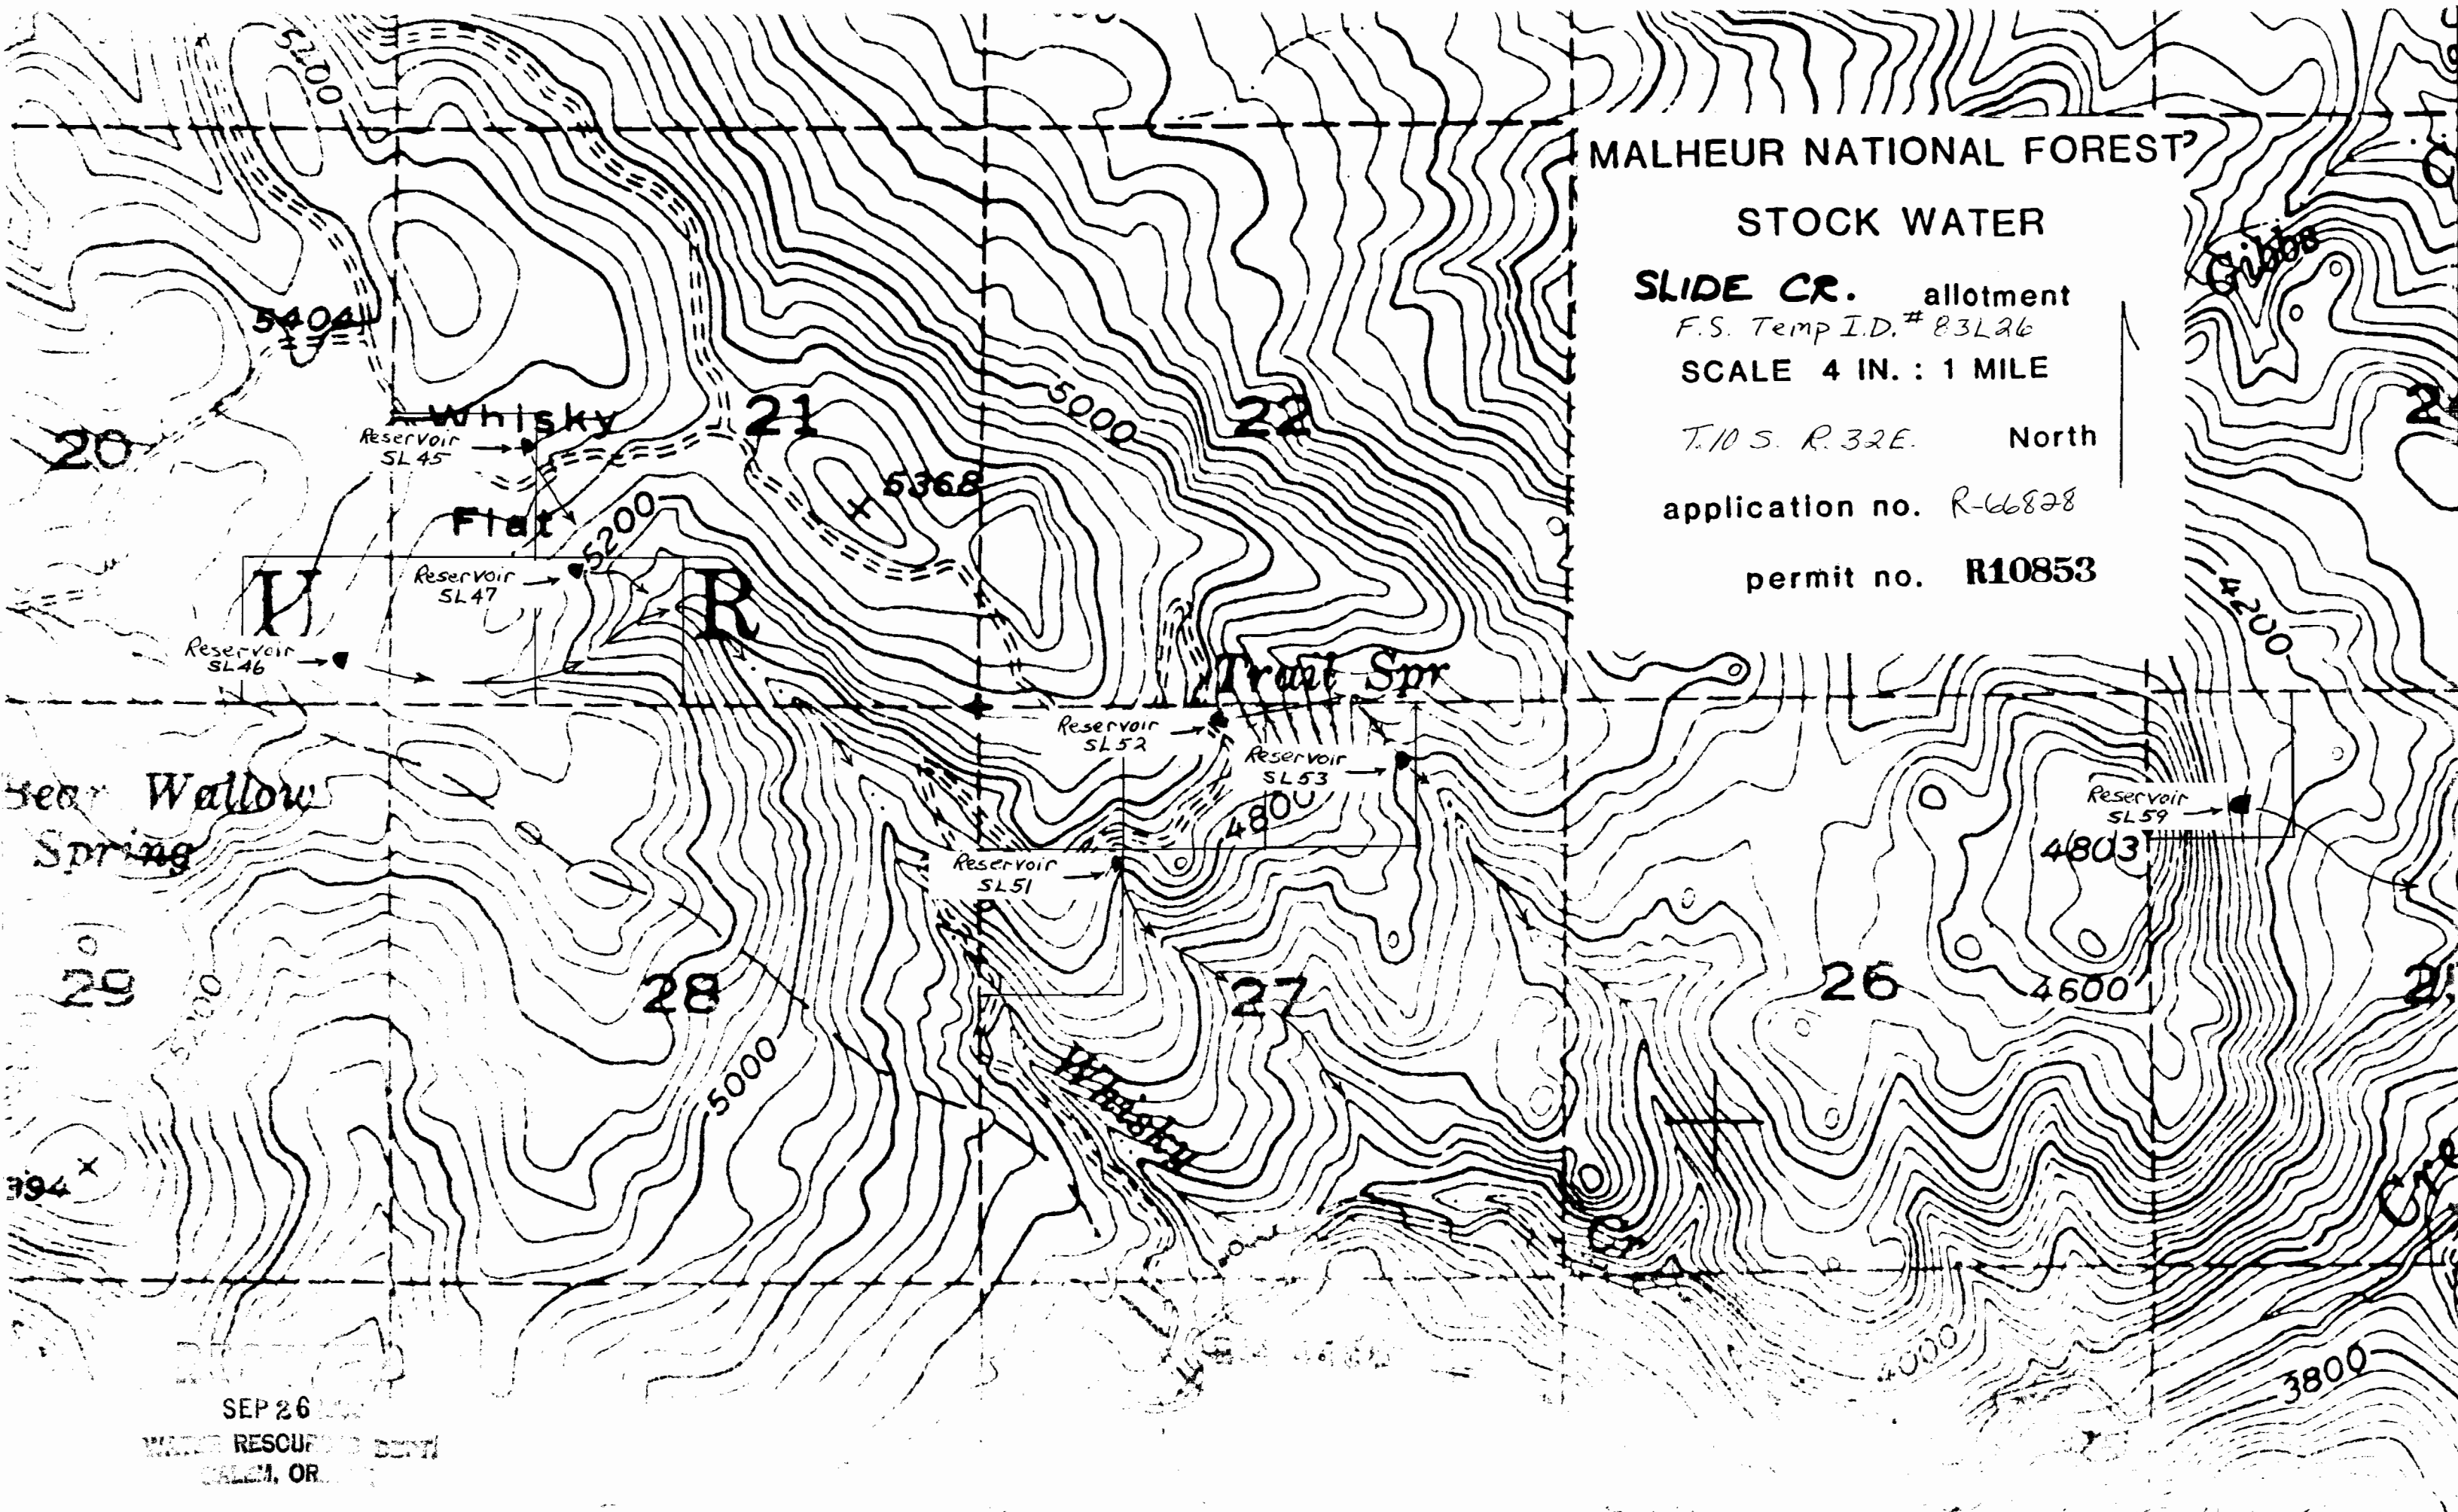


