


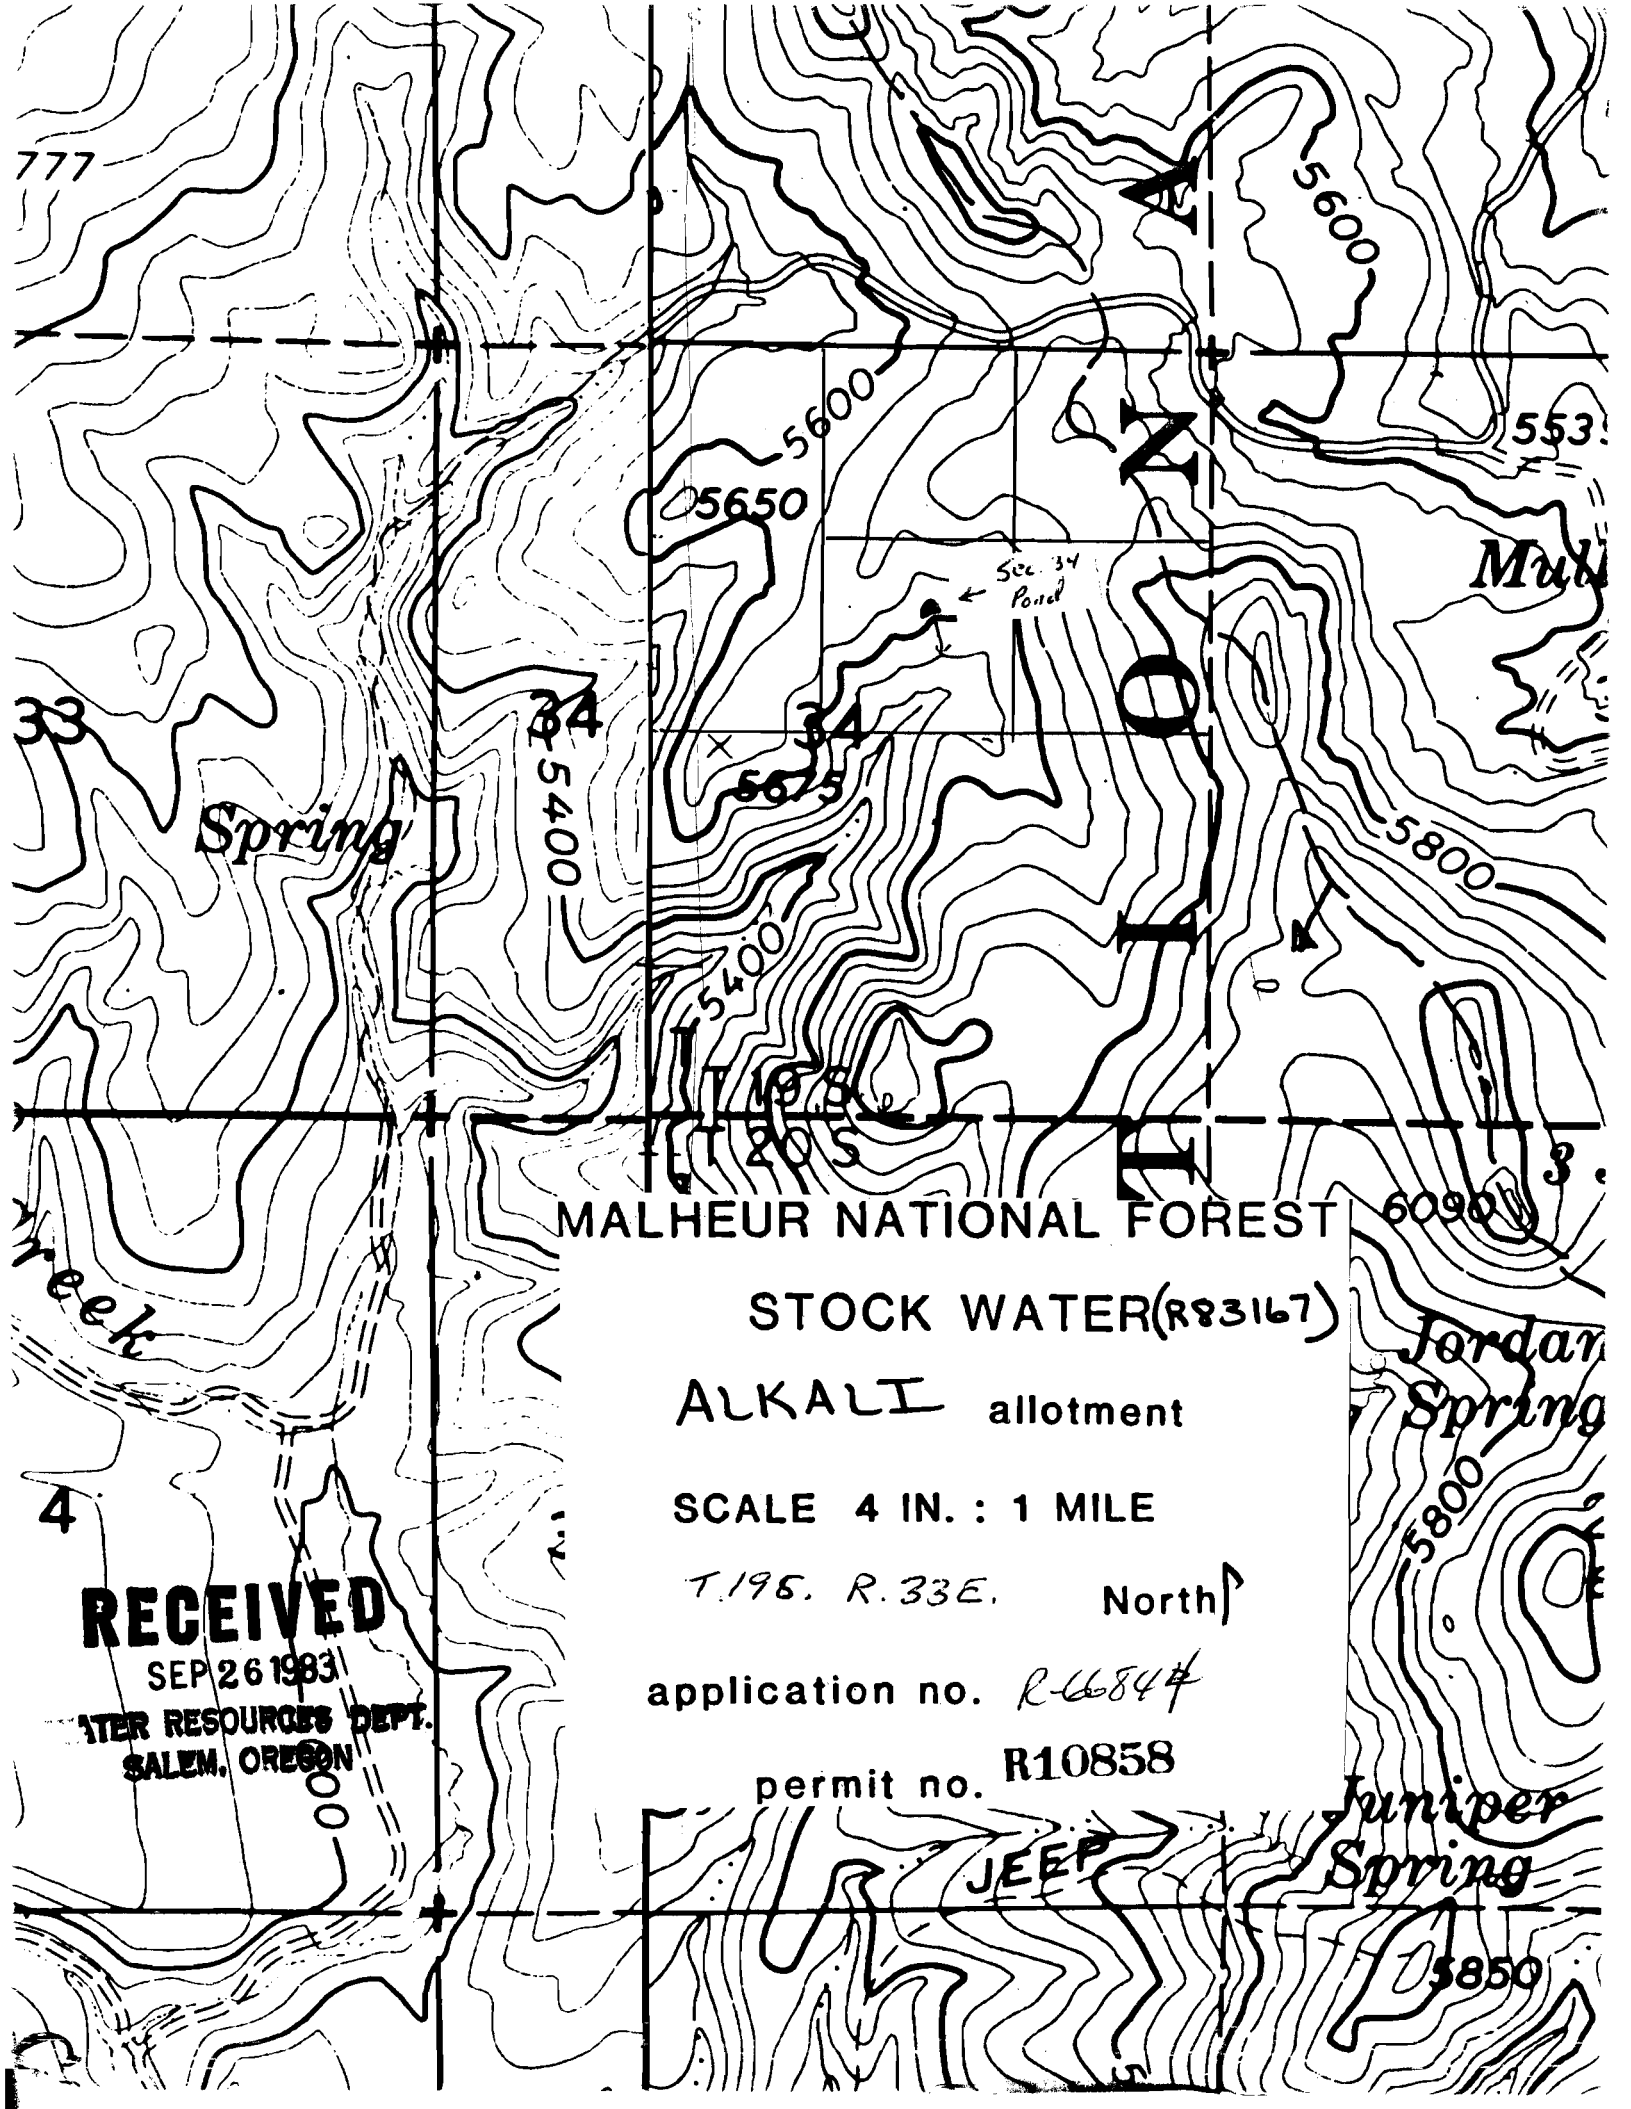

Spring

MALHEUR NATIONAL FOREST

STOCK WATER (R83167)

ALKALI allotment

SCALE 4 IN. : 1 MILE

T. 19 S. R. 33 E. North

application no. R-6847

permit no. R10858

RECEIVED

SEP 26 1983

WATER RESOURCES DEPT.
SALEM, OREGON

JEEP

Jordan Spring

Juniper Spring