


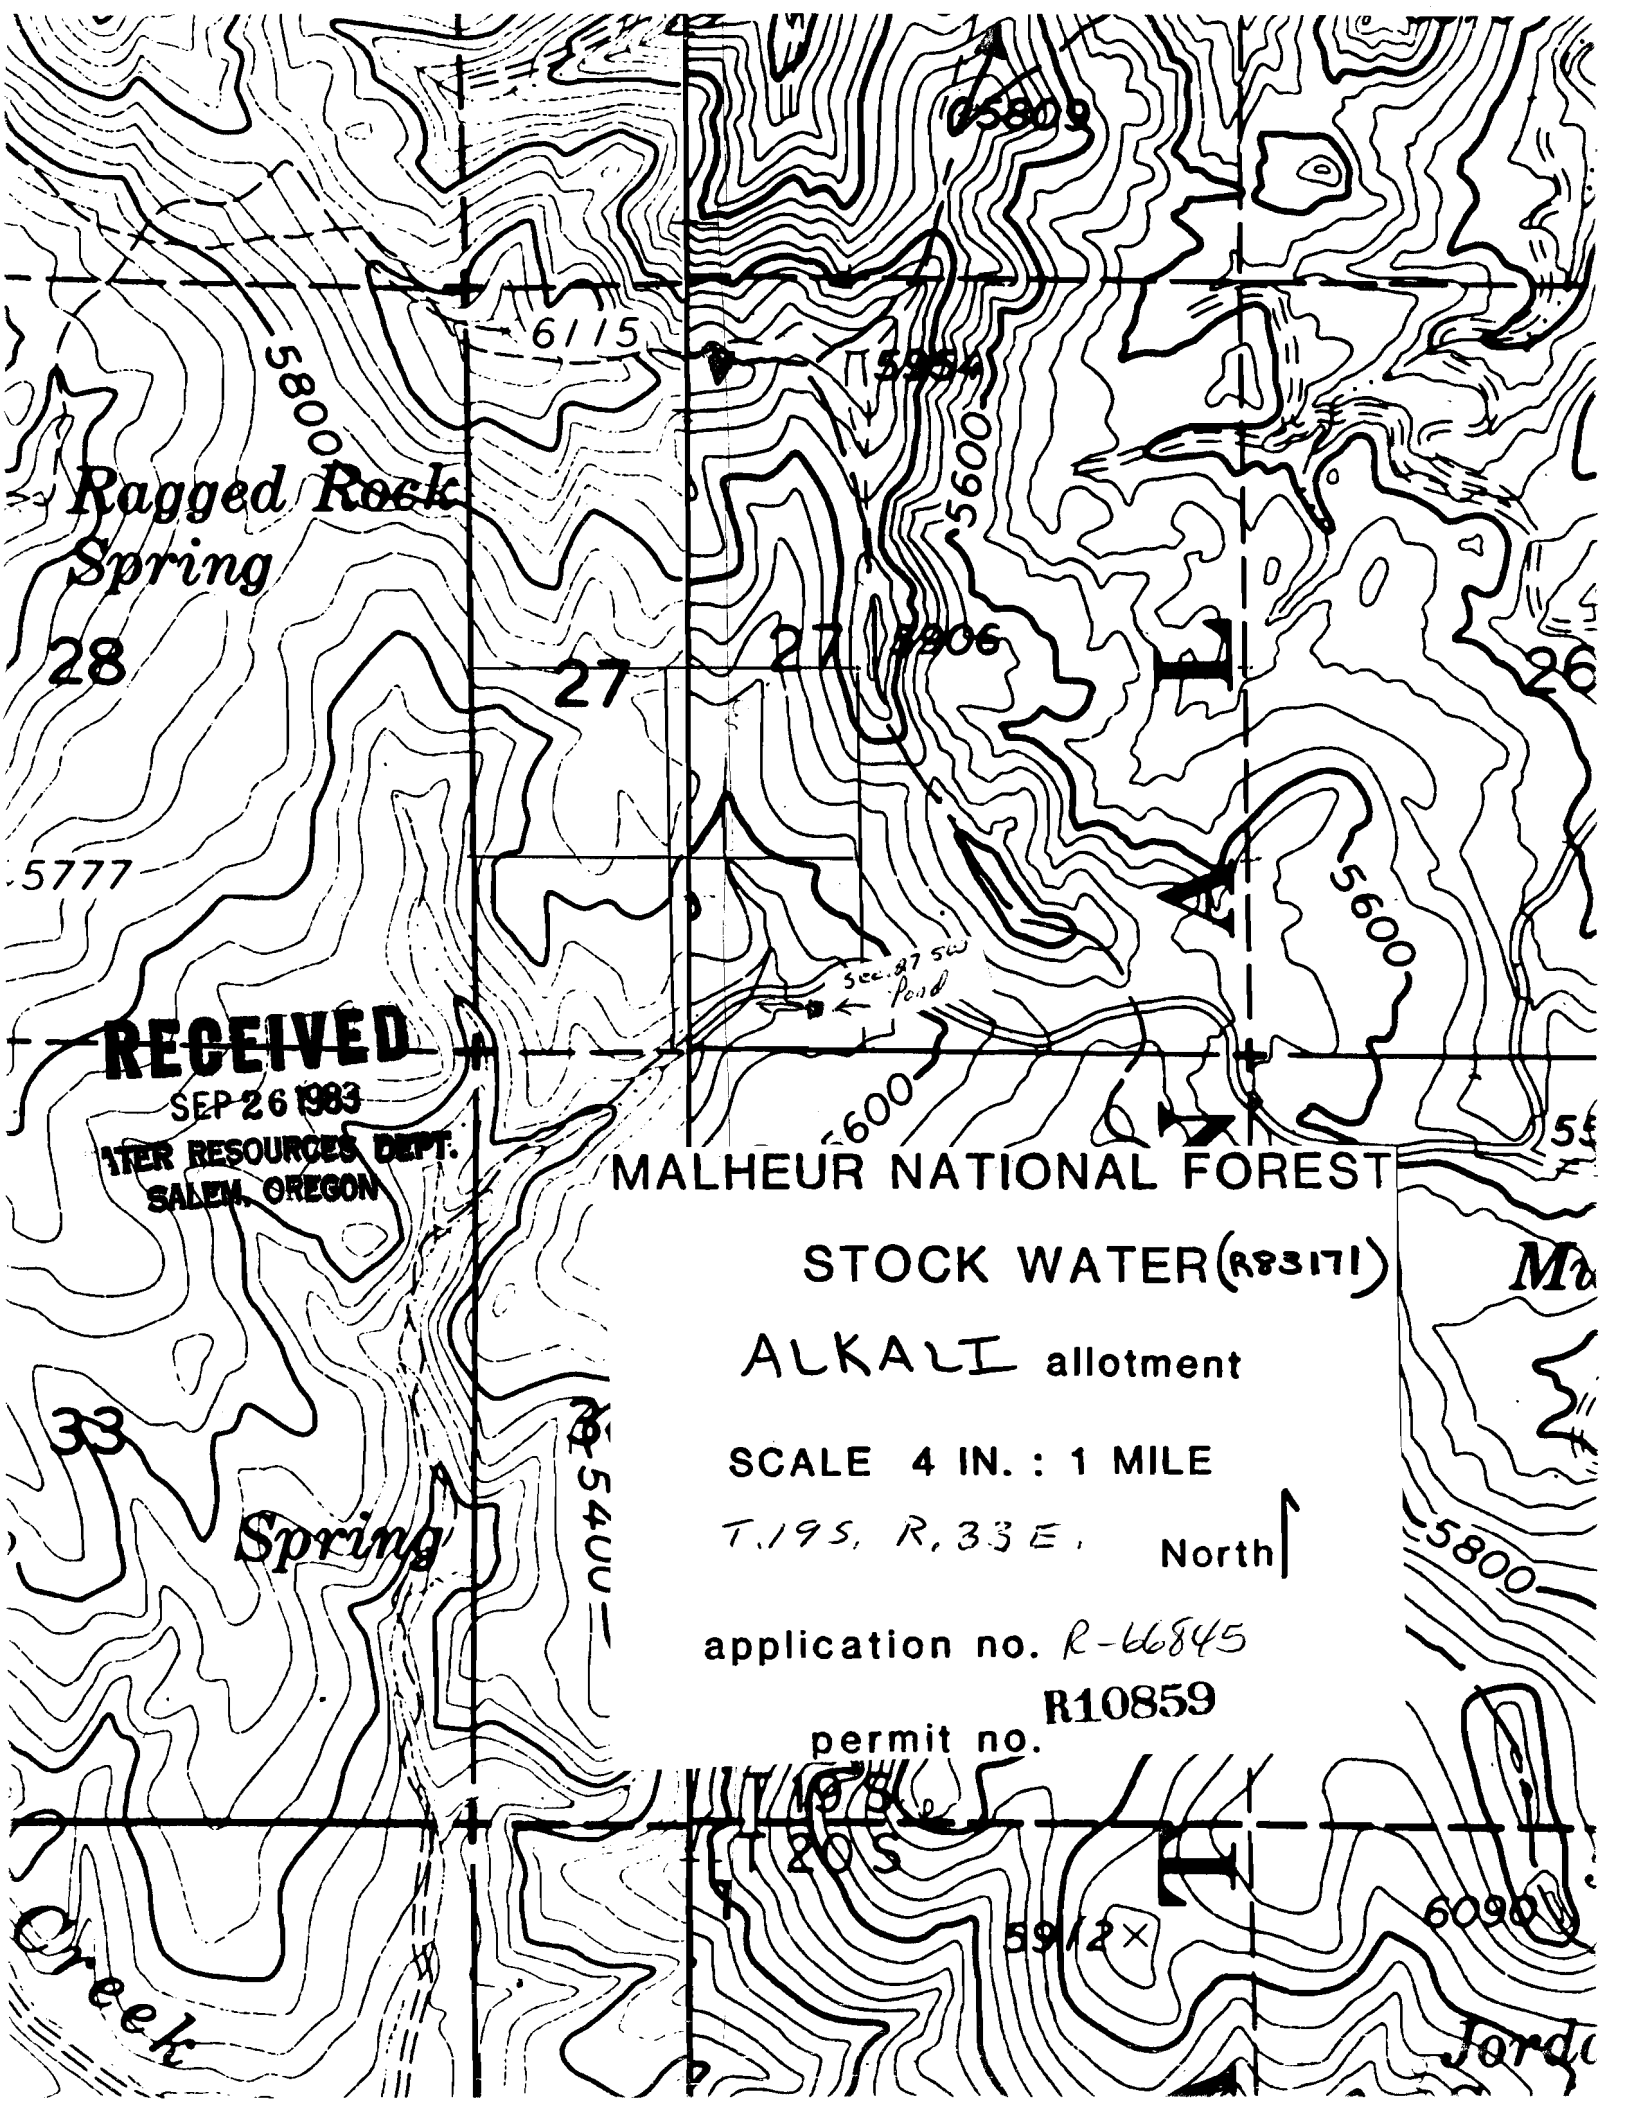

Ragged Rock
Spring

28

27

27

26

5777

RECEIVED

SEP 26 1983

WATER RESOURCES DEPT.
SALEM, OREGON

MALHEUR NATIONAL FOREST

STOCK WATER (R83171)

ALKALI allotment

SCALE 4 IN. : 1 MILE

T. 19 S. R. 33 E. North ↑

application no. R-66845

R10859

permit no.

33

Spring

5400

5800

Creek

20 S

5912X

6090

Jordan