


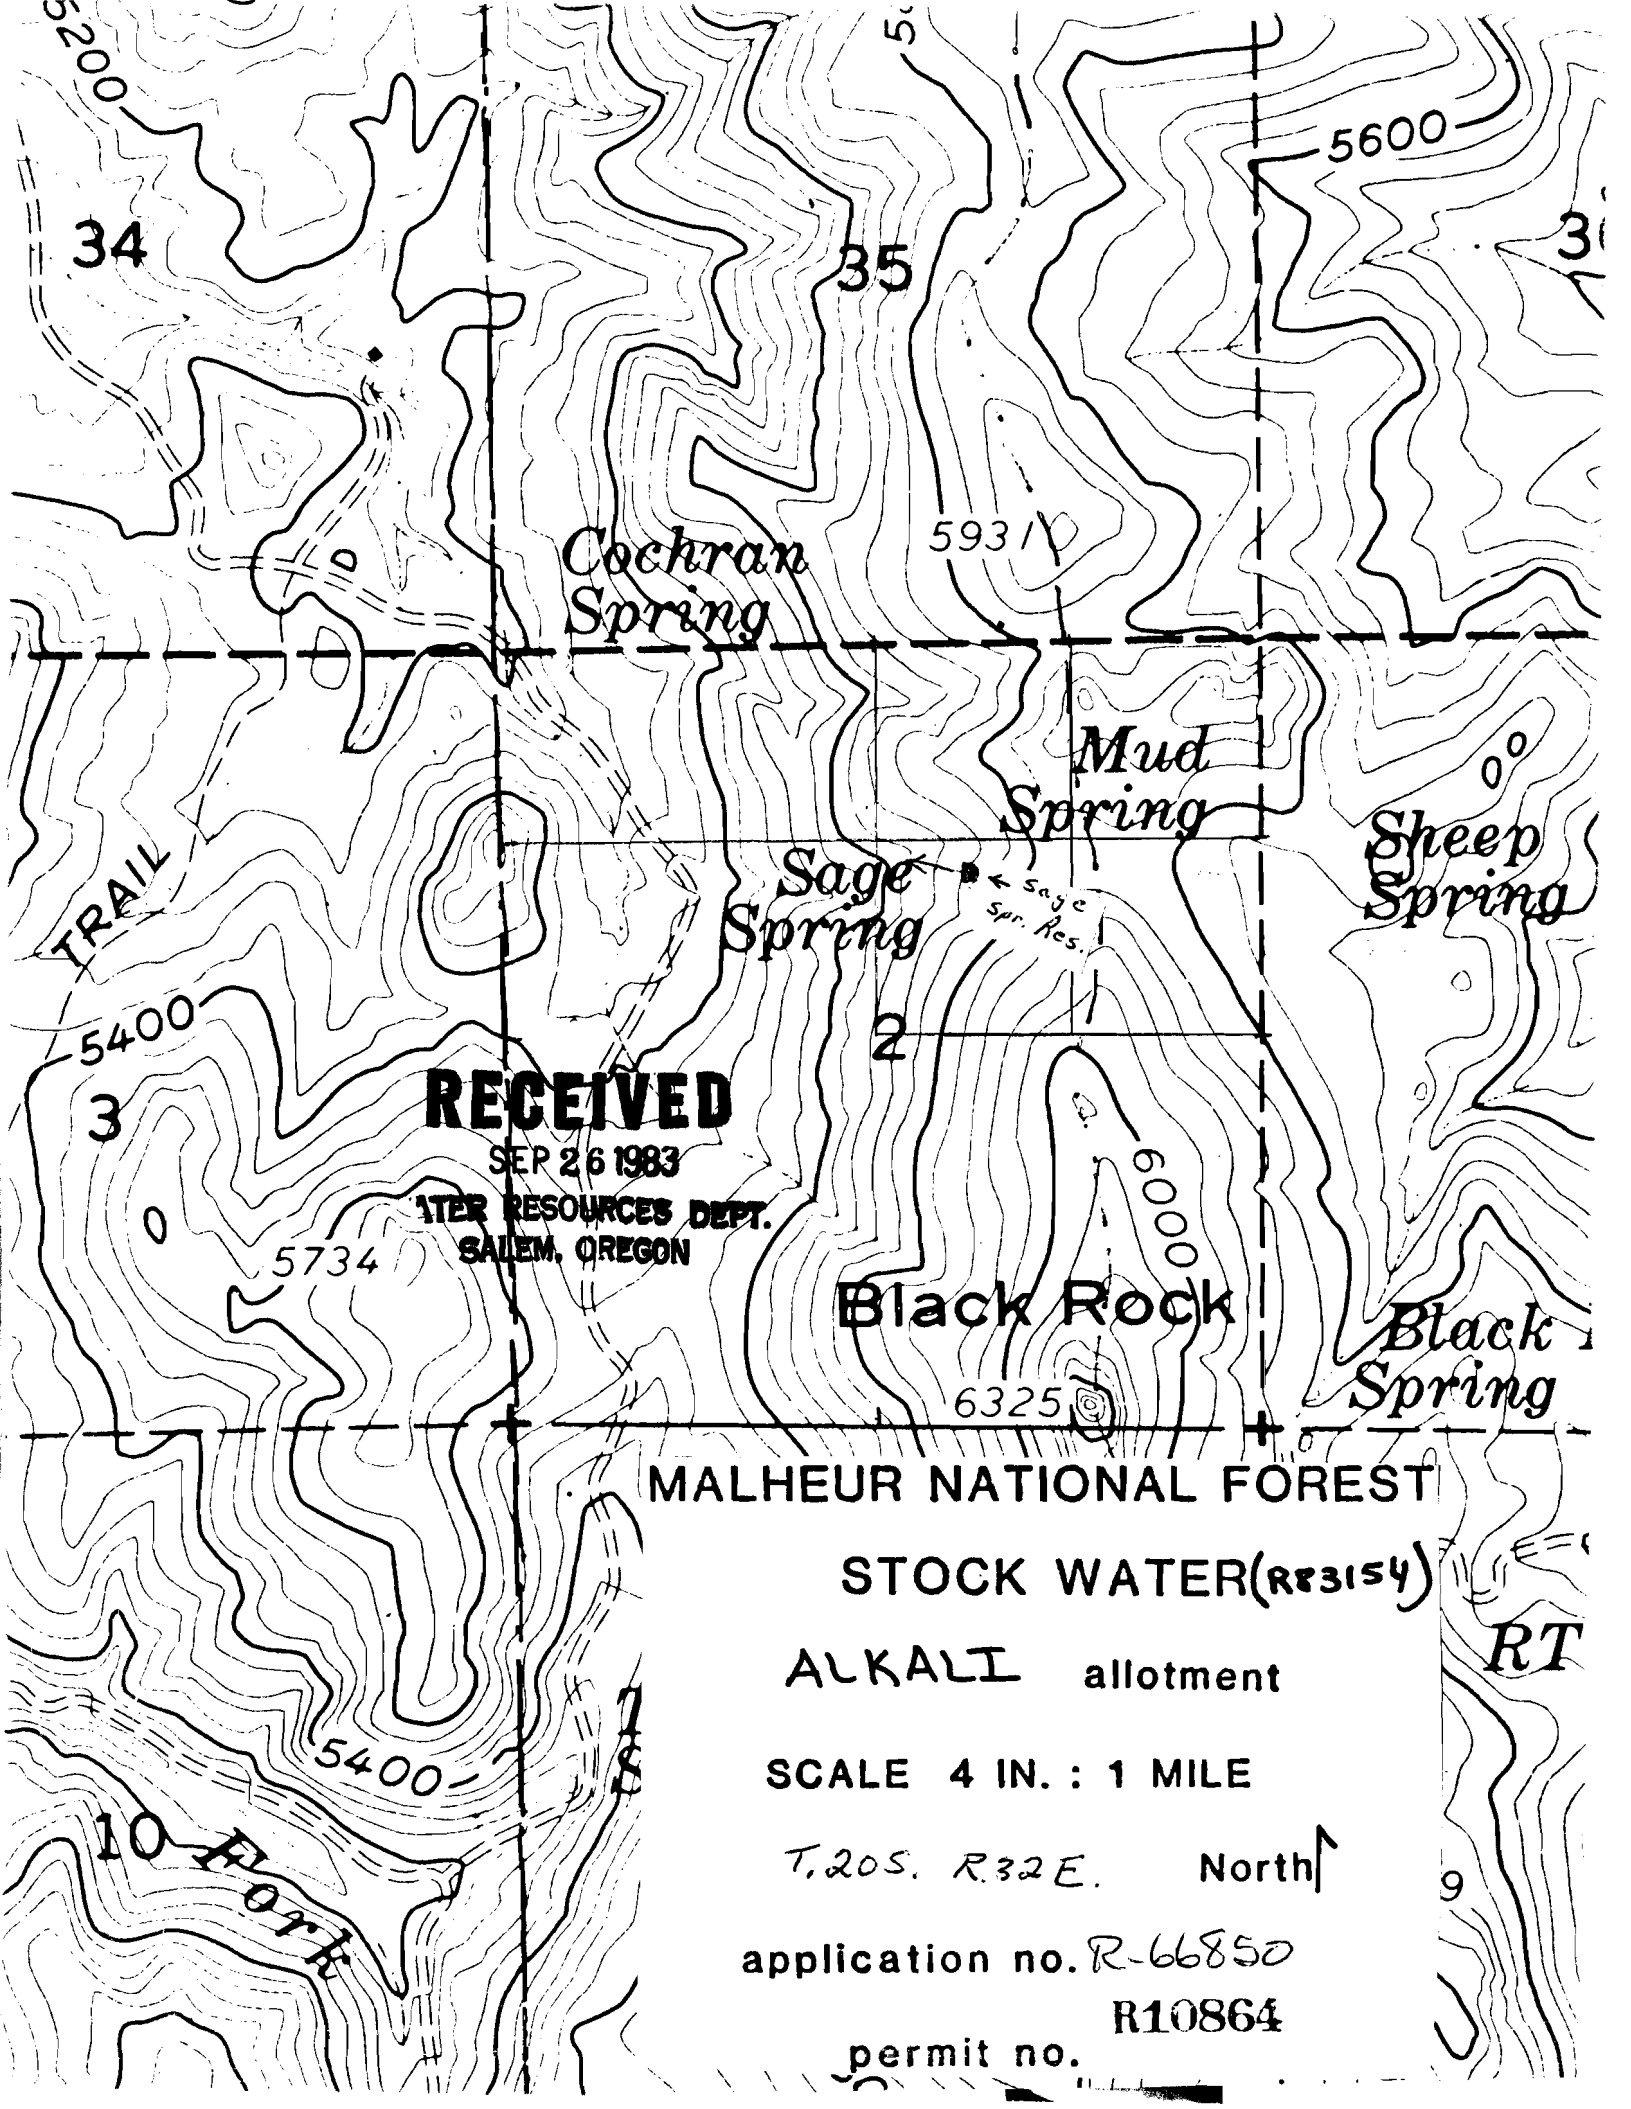

Cochran
Spring

5931

Mud
Spring

Sage
Spring

Sheep
Spring

RECEIVED

SEP 26 1983

WATER RESOURCES DEPT.
SALEM, OREGON

Black Rock

Black
Spring

MALHEUR NATIONAL FOREST

STOCK WATER(R#3154)

ALKALI allotment

SCALE 4 IN. : 1 MILE

T.20S. R.32E. North

application no. R-66850

R10864

permit no.

RT

9