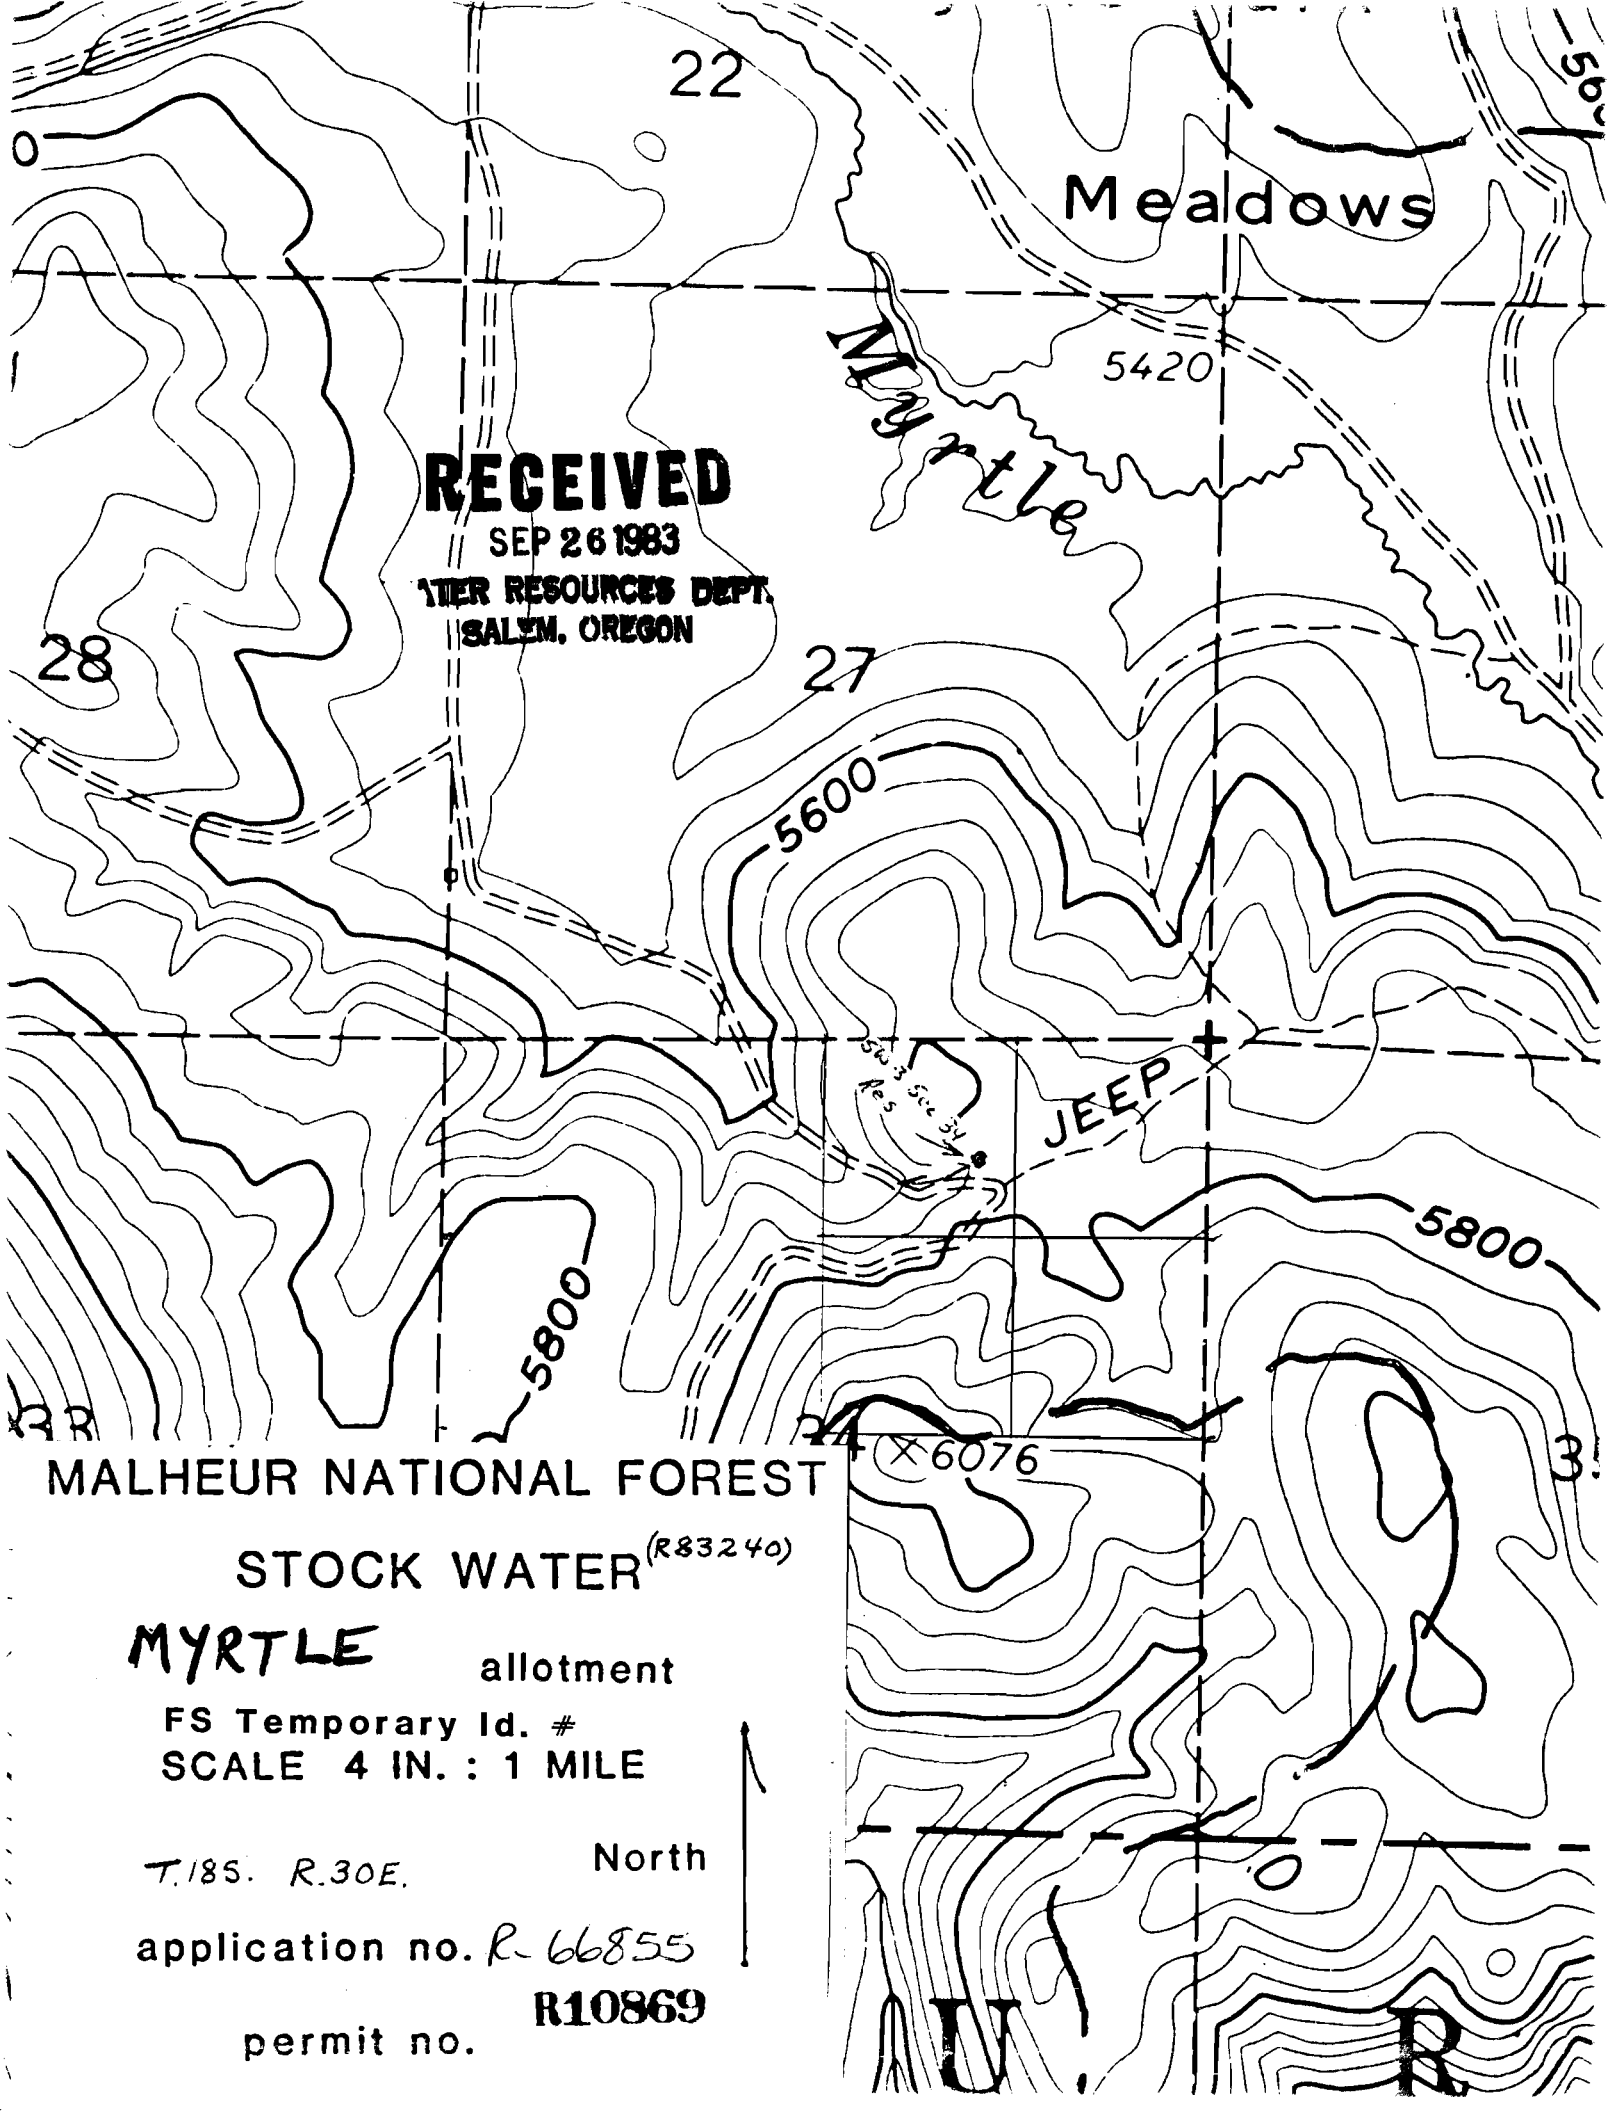

22
Meadows
5420
Myrtle
RECEIVED
SEP 26 1983
WATER RESOURCES DEPT.
SALEM, OREGON
28
27
5600
JEEP
5800
5800
6076
3
MALHEUR NATIONAL FOREST
STOCK WATER (R83240)
MYRTLE allotment
FS Temporary Id. #
SCALE 4 IN. : 1 MILE
North
T. 18S. R. 30E.
application no. R-66855
R10869
permit no.