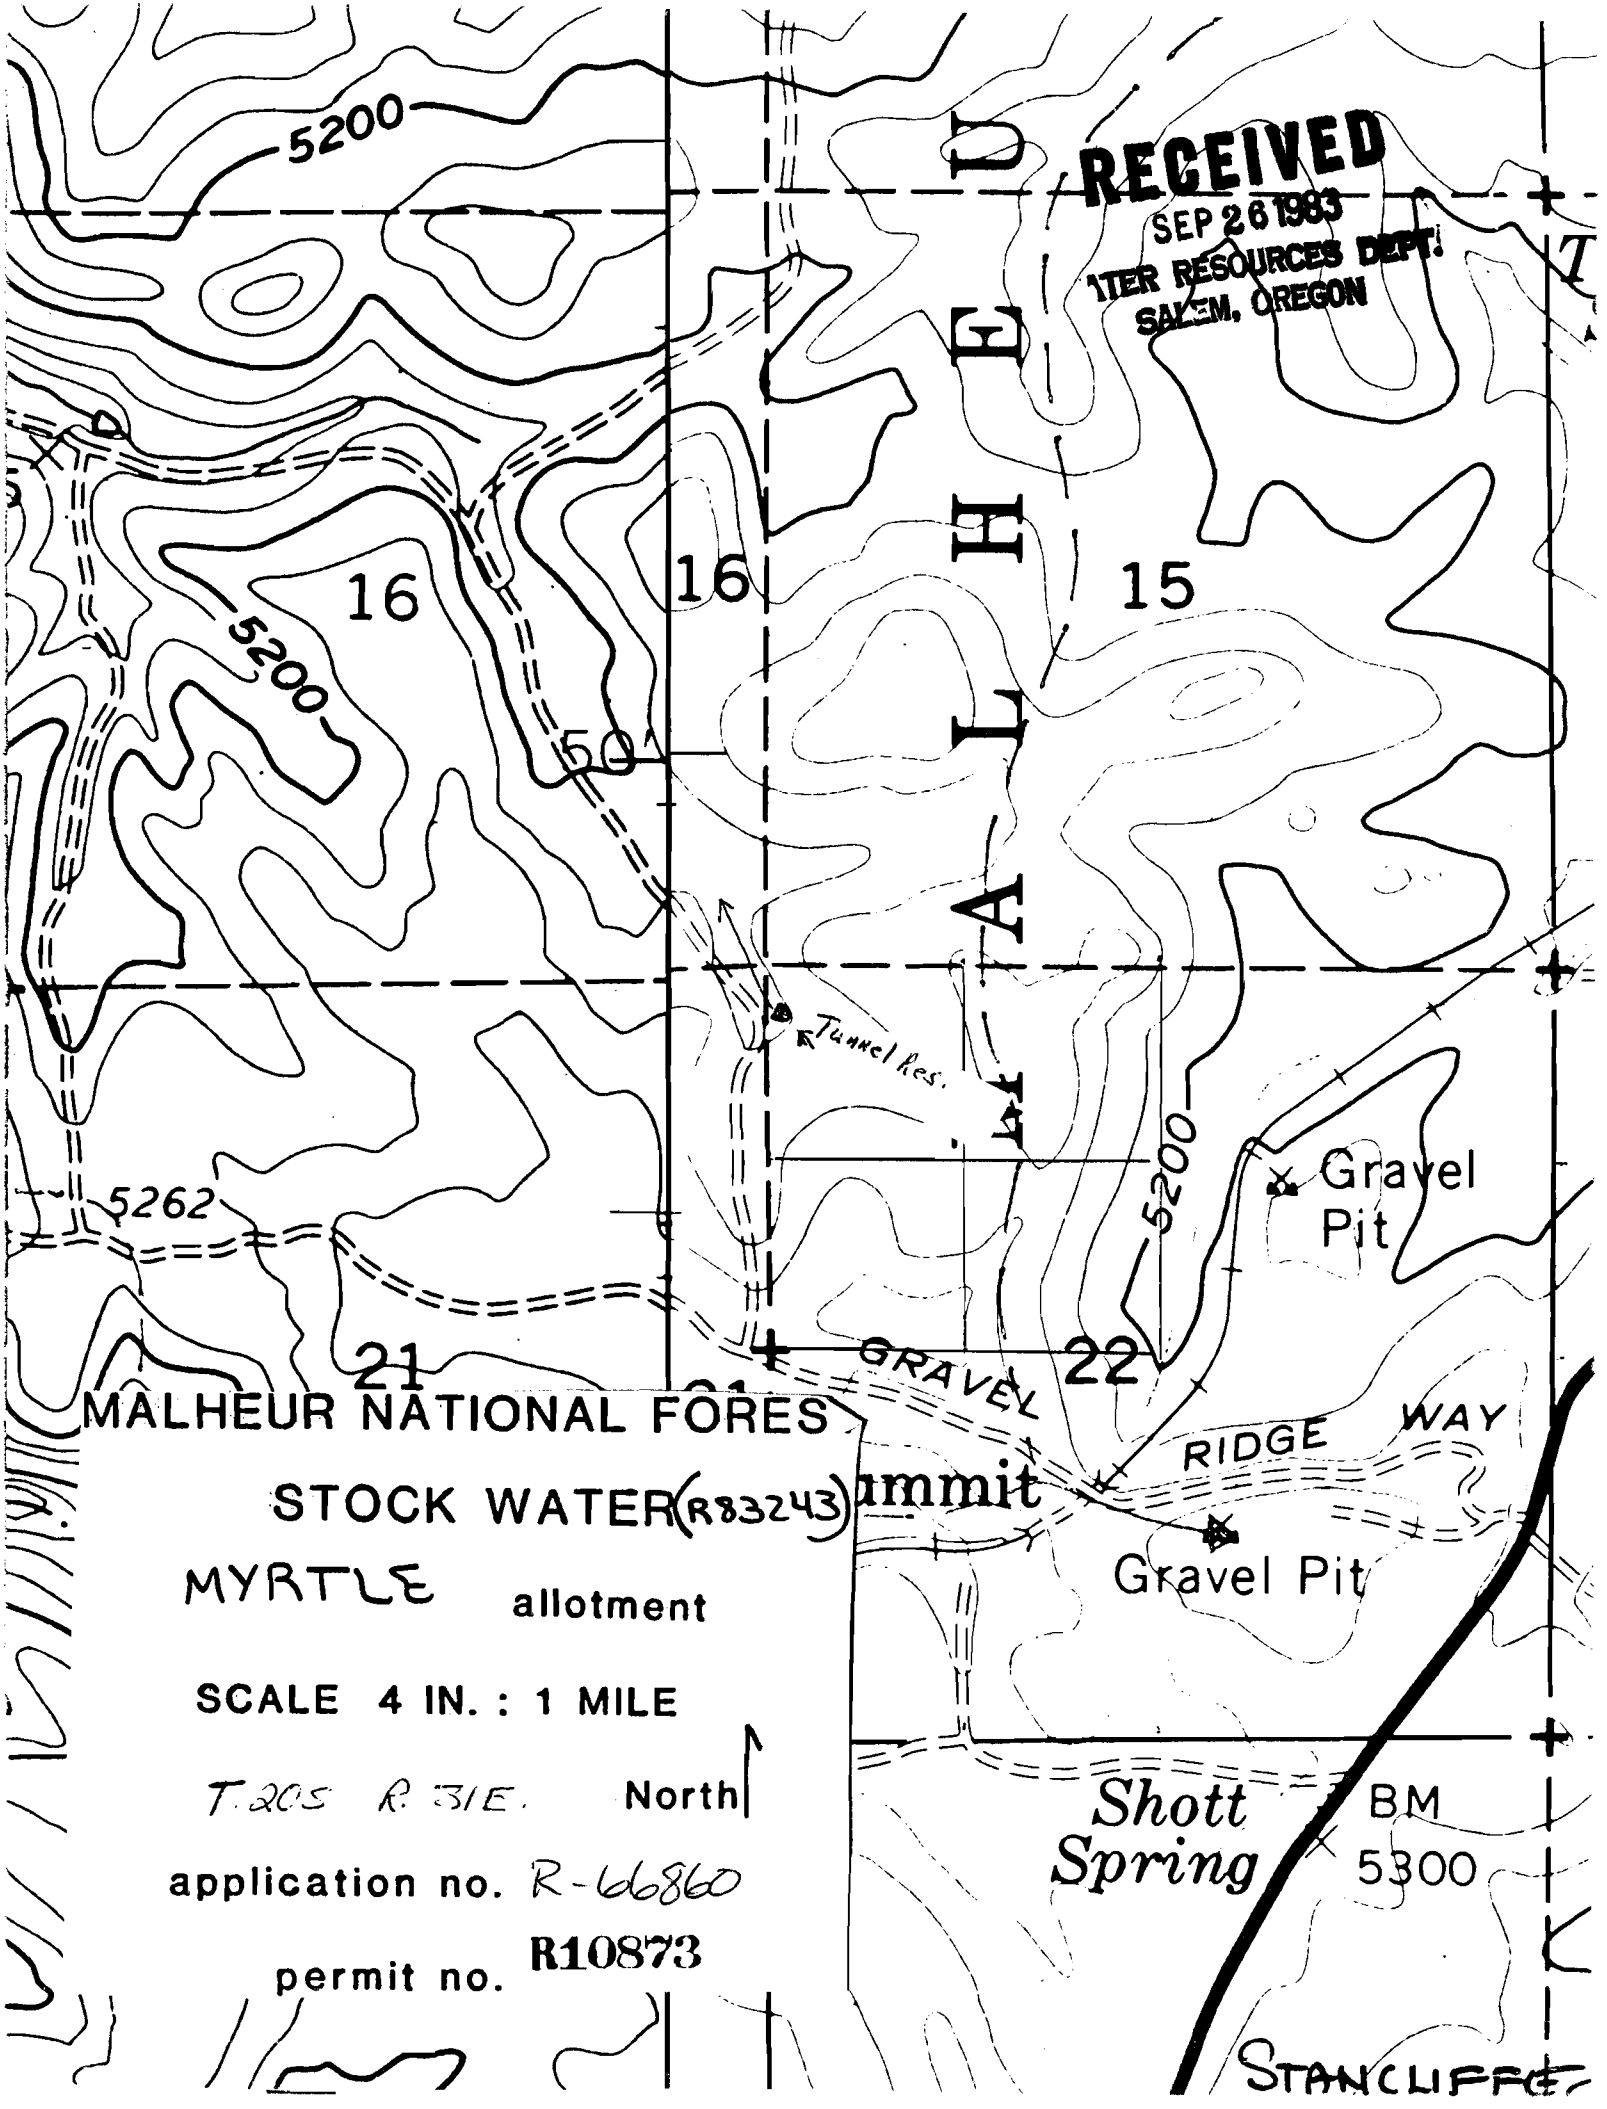
RECEIVED
SEP 26 1983
WATER RESOURCES DEPT.
SALEM, OREGON
5200
16
16
15
5200
50
Tunnel Res.
5262
5200
Gravel Pit
21
22
GRAVEL
RIDGE WAY
Gravel Pit
Shott Spring
BM 5300
STANCLIFFE
MALHEUR NATIONAL FORES
STOCK WATER (R83243)
MYRTLE allotment
SCALE 4 IN. : 1 MILE
T. 20S R. 31E.
North
application no. R-66860
permit no. R10873