


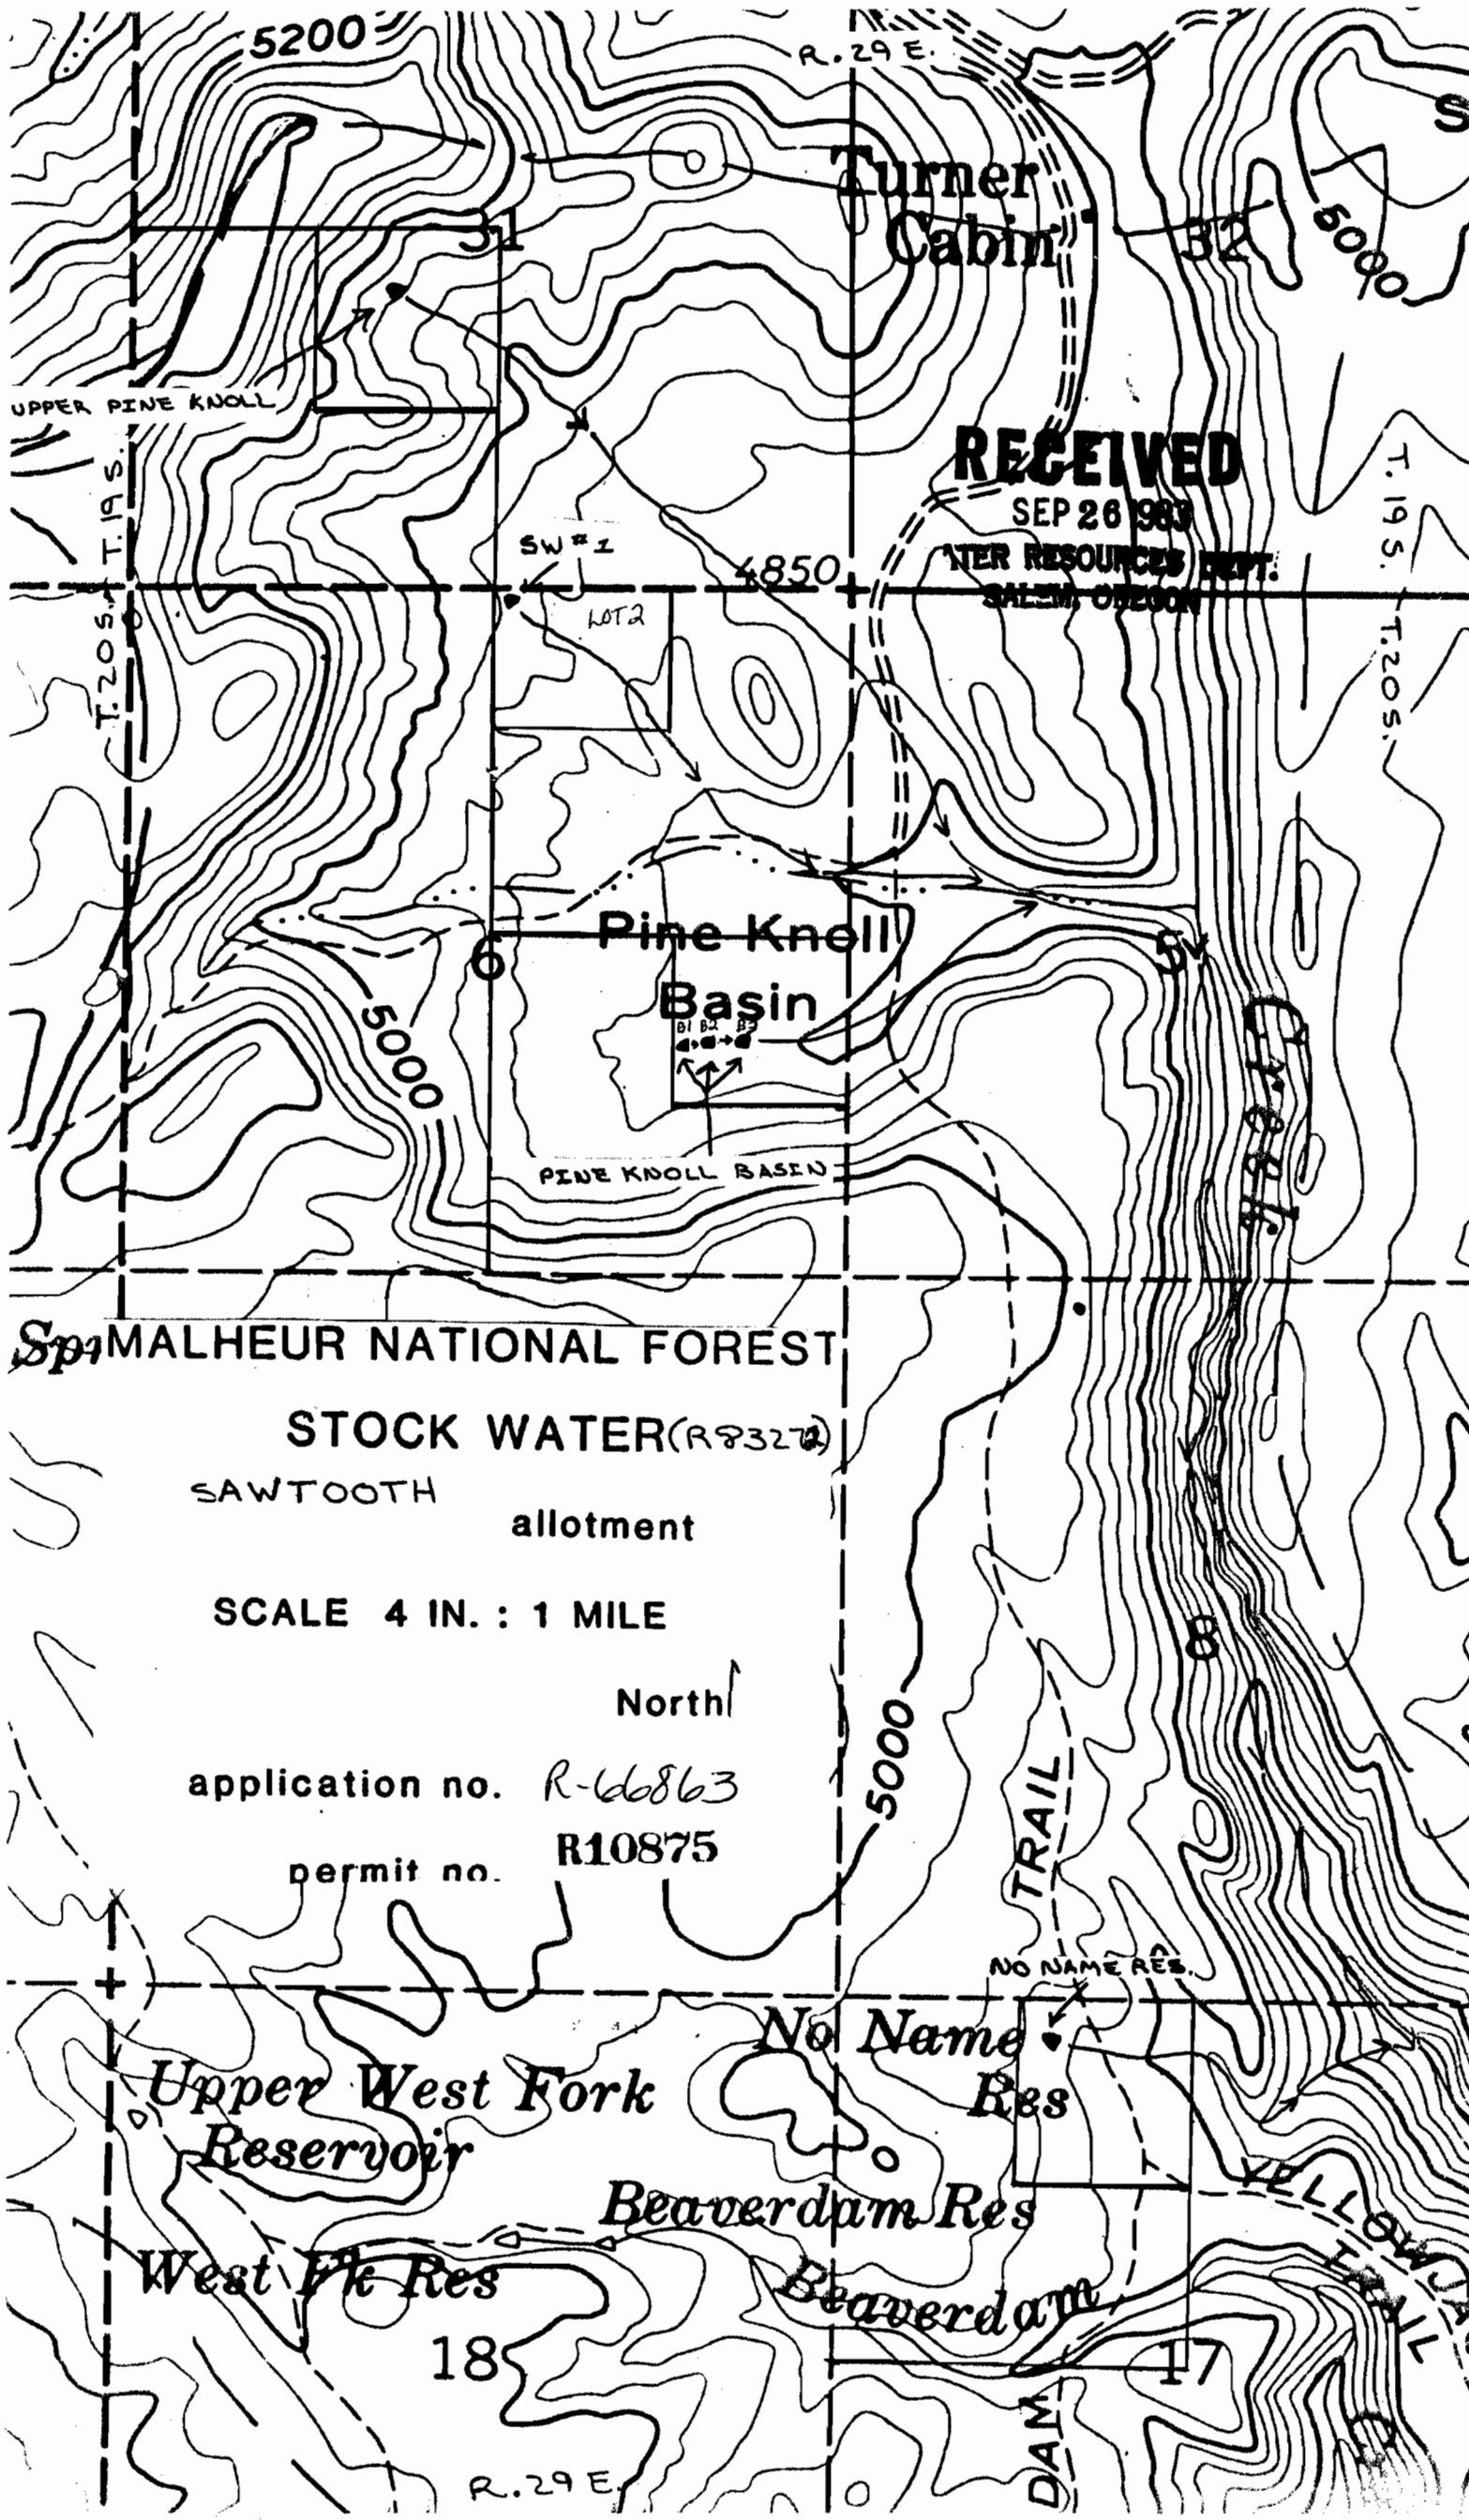

RECEIVED

SEP 26 1983

WATER RESOURCES DEPT.
SALEM, OREGON

UPPER PINE KNOLL

SW #1

LOT 2

Pine Knoll
Basin

PINE KNOLL BASIN

SPALHEUR NATIONAL FOREST

STOCK WATER (R8327)

SAWTOOTH

allotment

SCALE 4 IN. : 1 MILE

North

application no. R-66863

permit no. R10875

Upper West Fork
Reservoir

No Name
Res

Beaverdam Res

West Fork Res

Beaverdam

18

17

R. 29 E.

NO NAME RES.

TRAIL

YELLOW TRAIL

DAM