


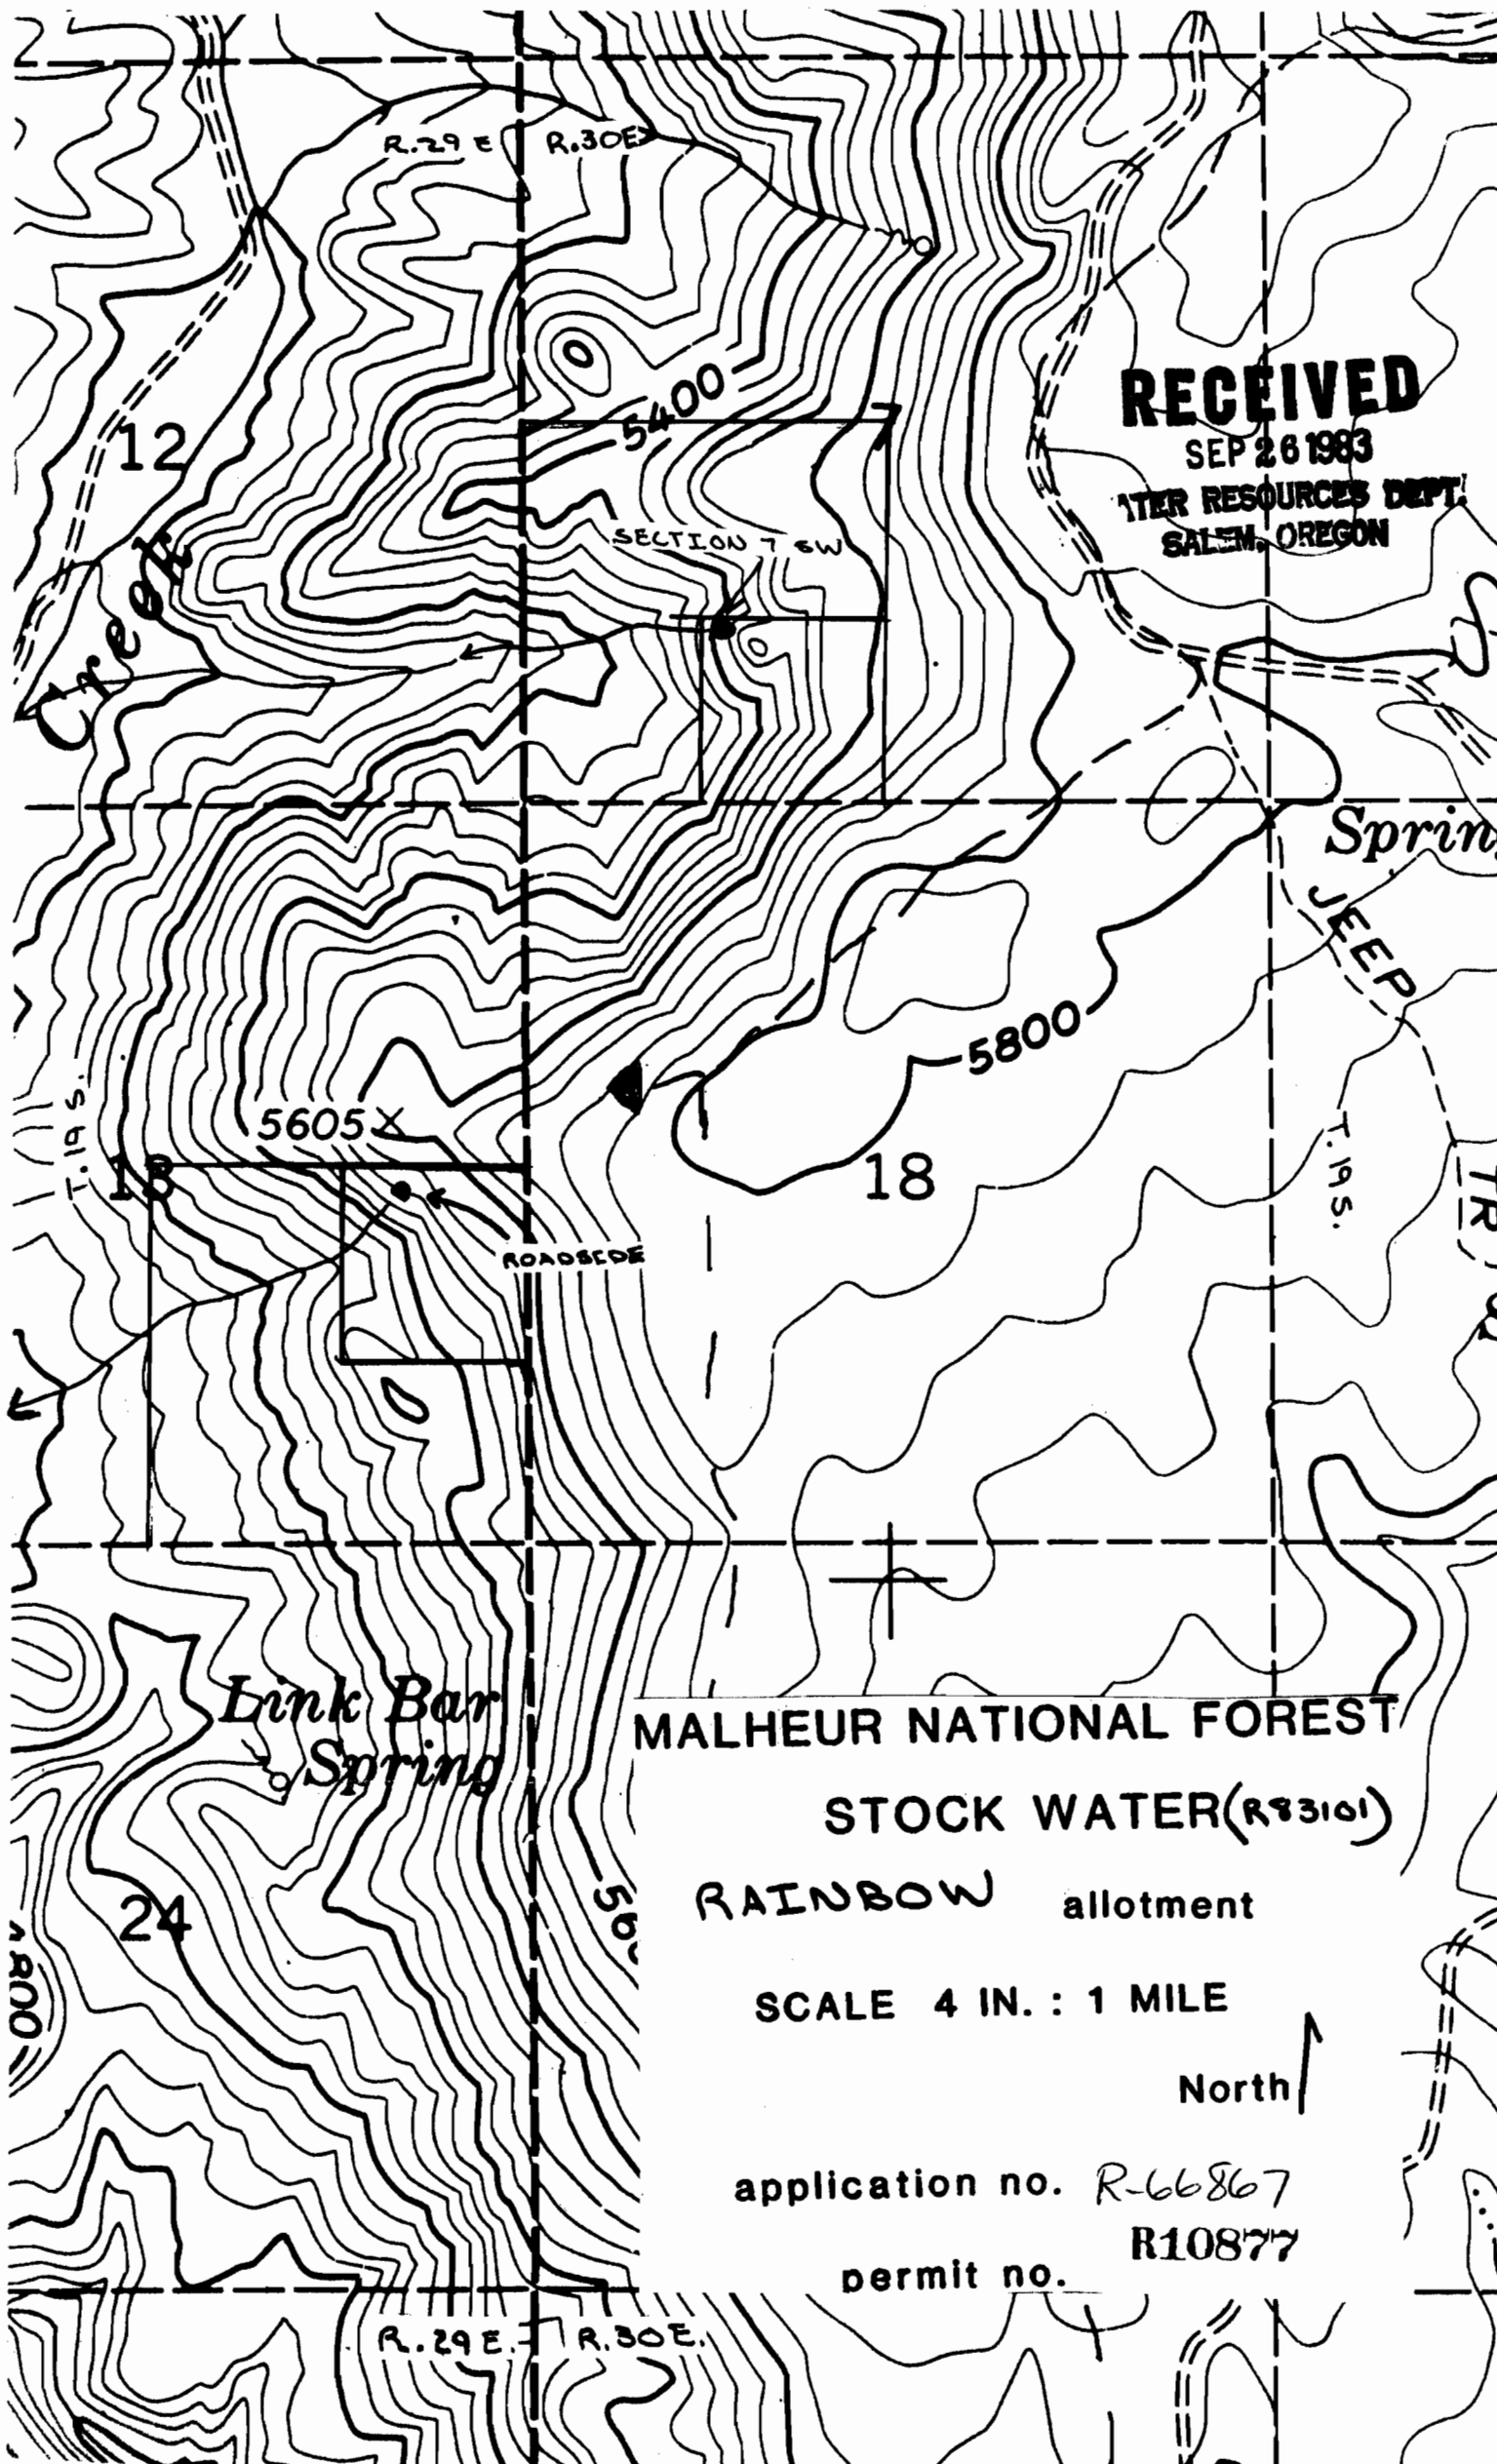

RECEIVED
SEP 26 1983
WATER RESOURCES DEPT.
SALEM, OREGON

MALHEUR NATIONAL FOREST

STOCK WATER (R33101)

RAINBOW allotment

SCALE 4 IN. : 1 MILE

North ↑

application no. R-66867

permit no. R10877

R.29E. R.30E.