


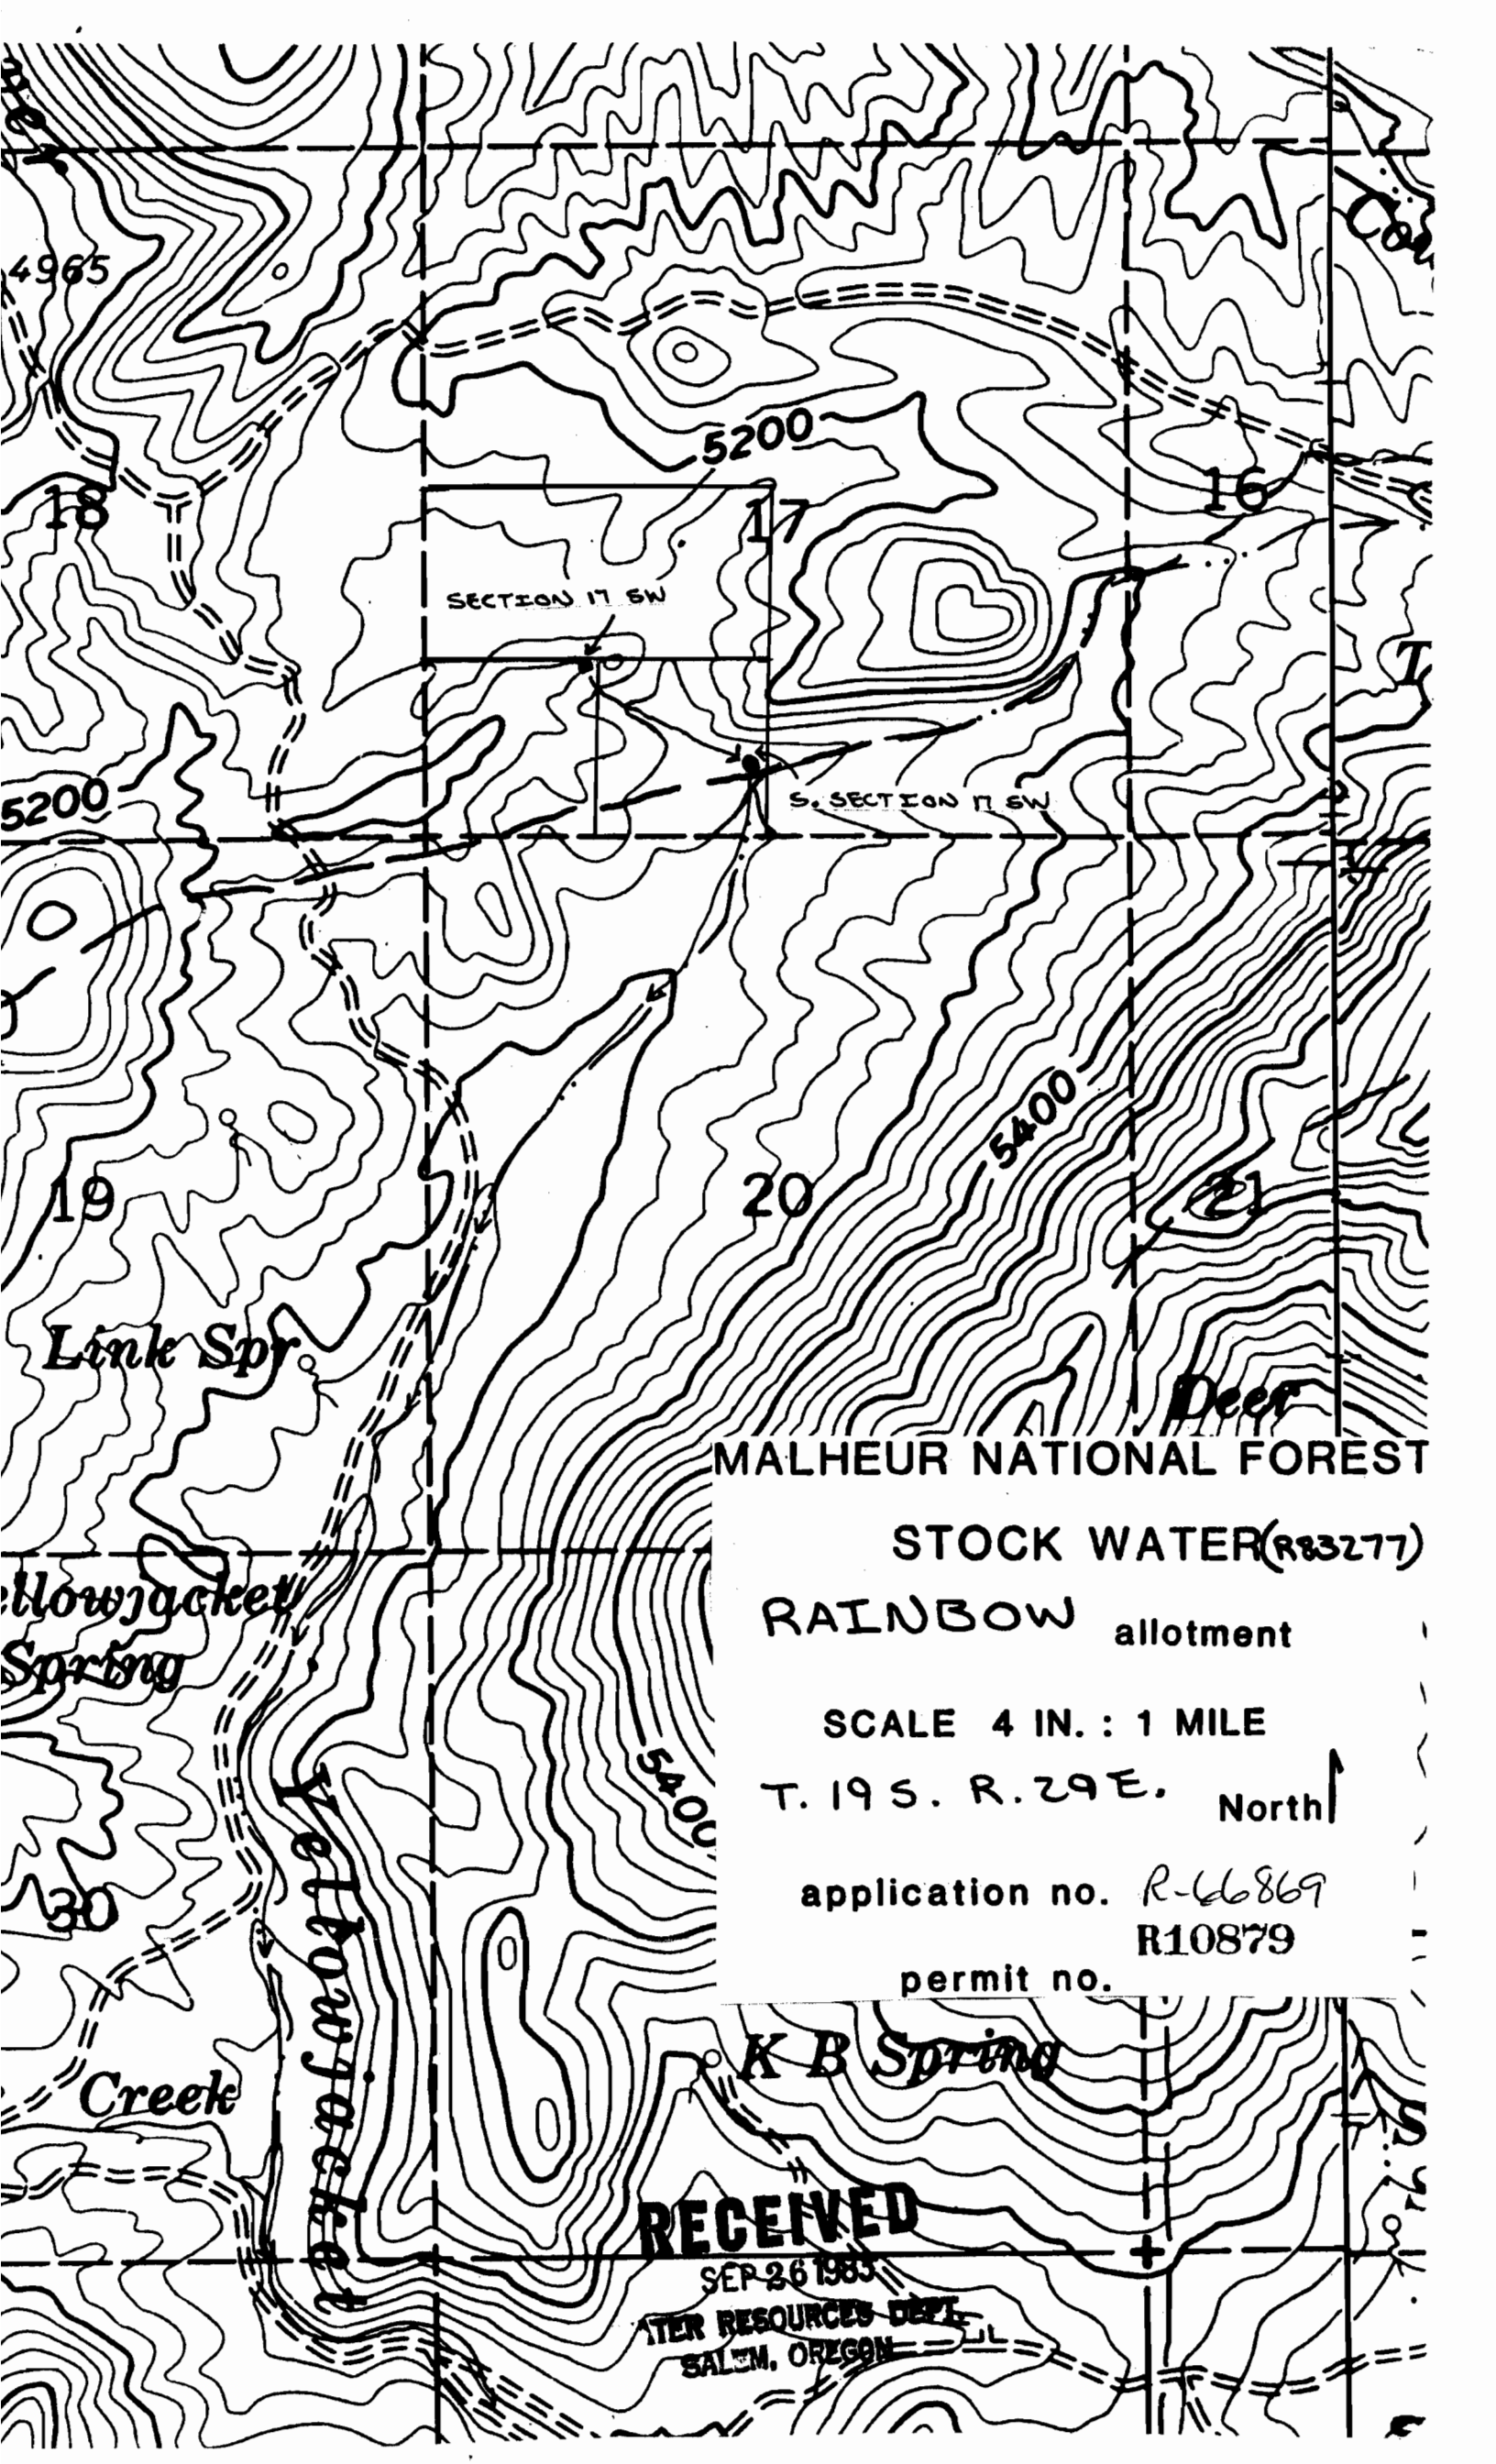

MALHEUR NATIONAL FOREST

STOCK WATER(R13277)

RAINBOW allotment

SCALE 4 IN. : 1 MILE

T. 19 S. R. 29 E. North ↑

application no. R-66869

R10879

permit no.

K B Spring

RECEIVED

SEP 26 1983

WATER RESOURCES DEPT.
SALEM, OREGON