


ED  
OCT 11 1983  
WATER RESOURCES DIVISION  
SALEM, OREGON

MALHEUR NATIONAL FOREST  
BLUE BUCKET  
STOCK WATER  
FS Temporary allotment  
SCALE 4 IN. : 1 MILE  
Map # 2 of 2

application no. R-67480  
North  
permit no. R-10920

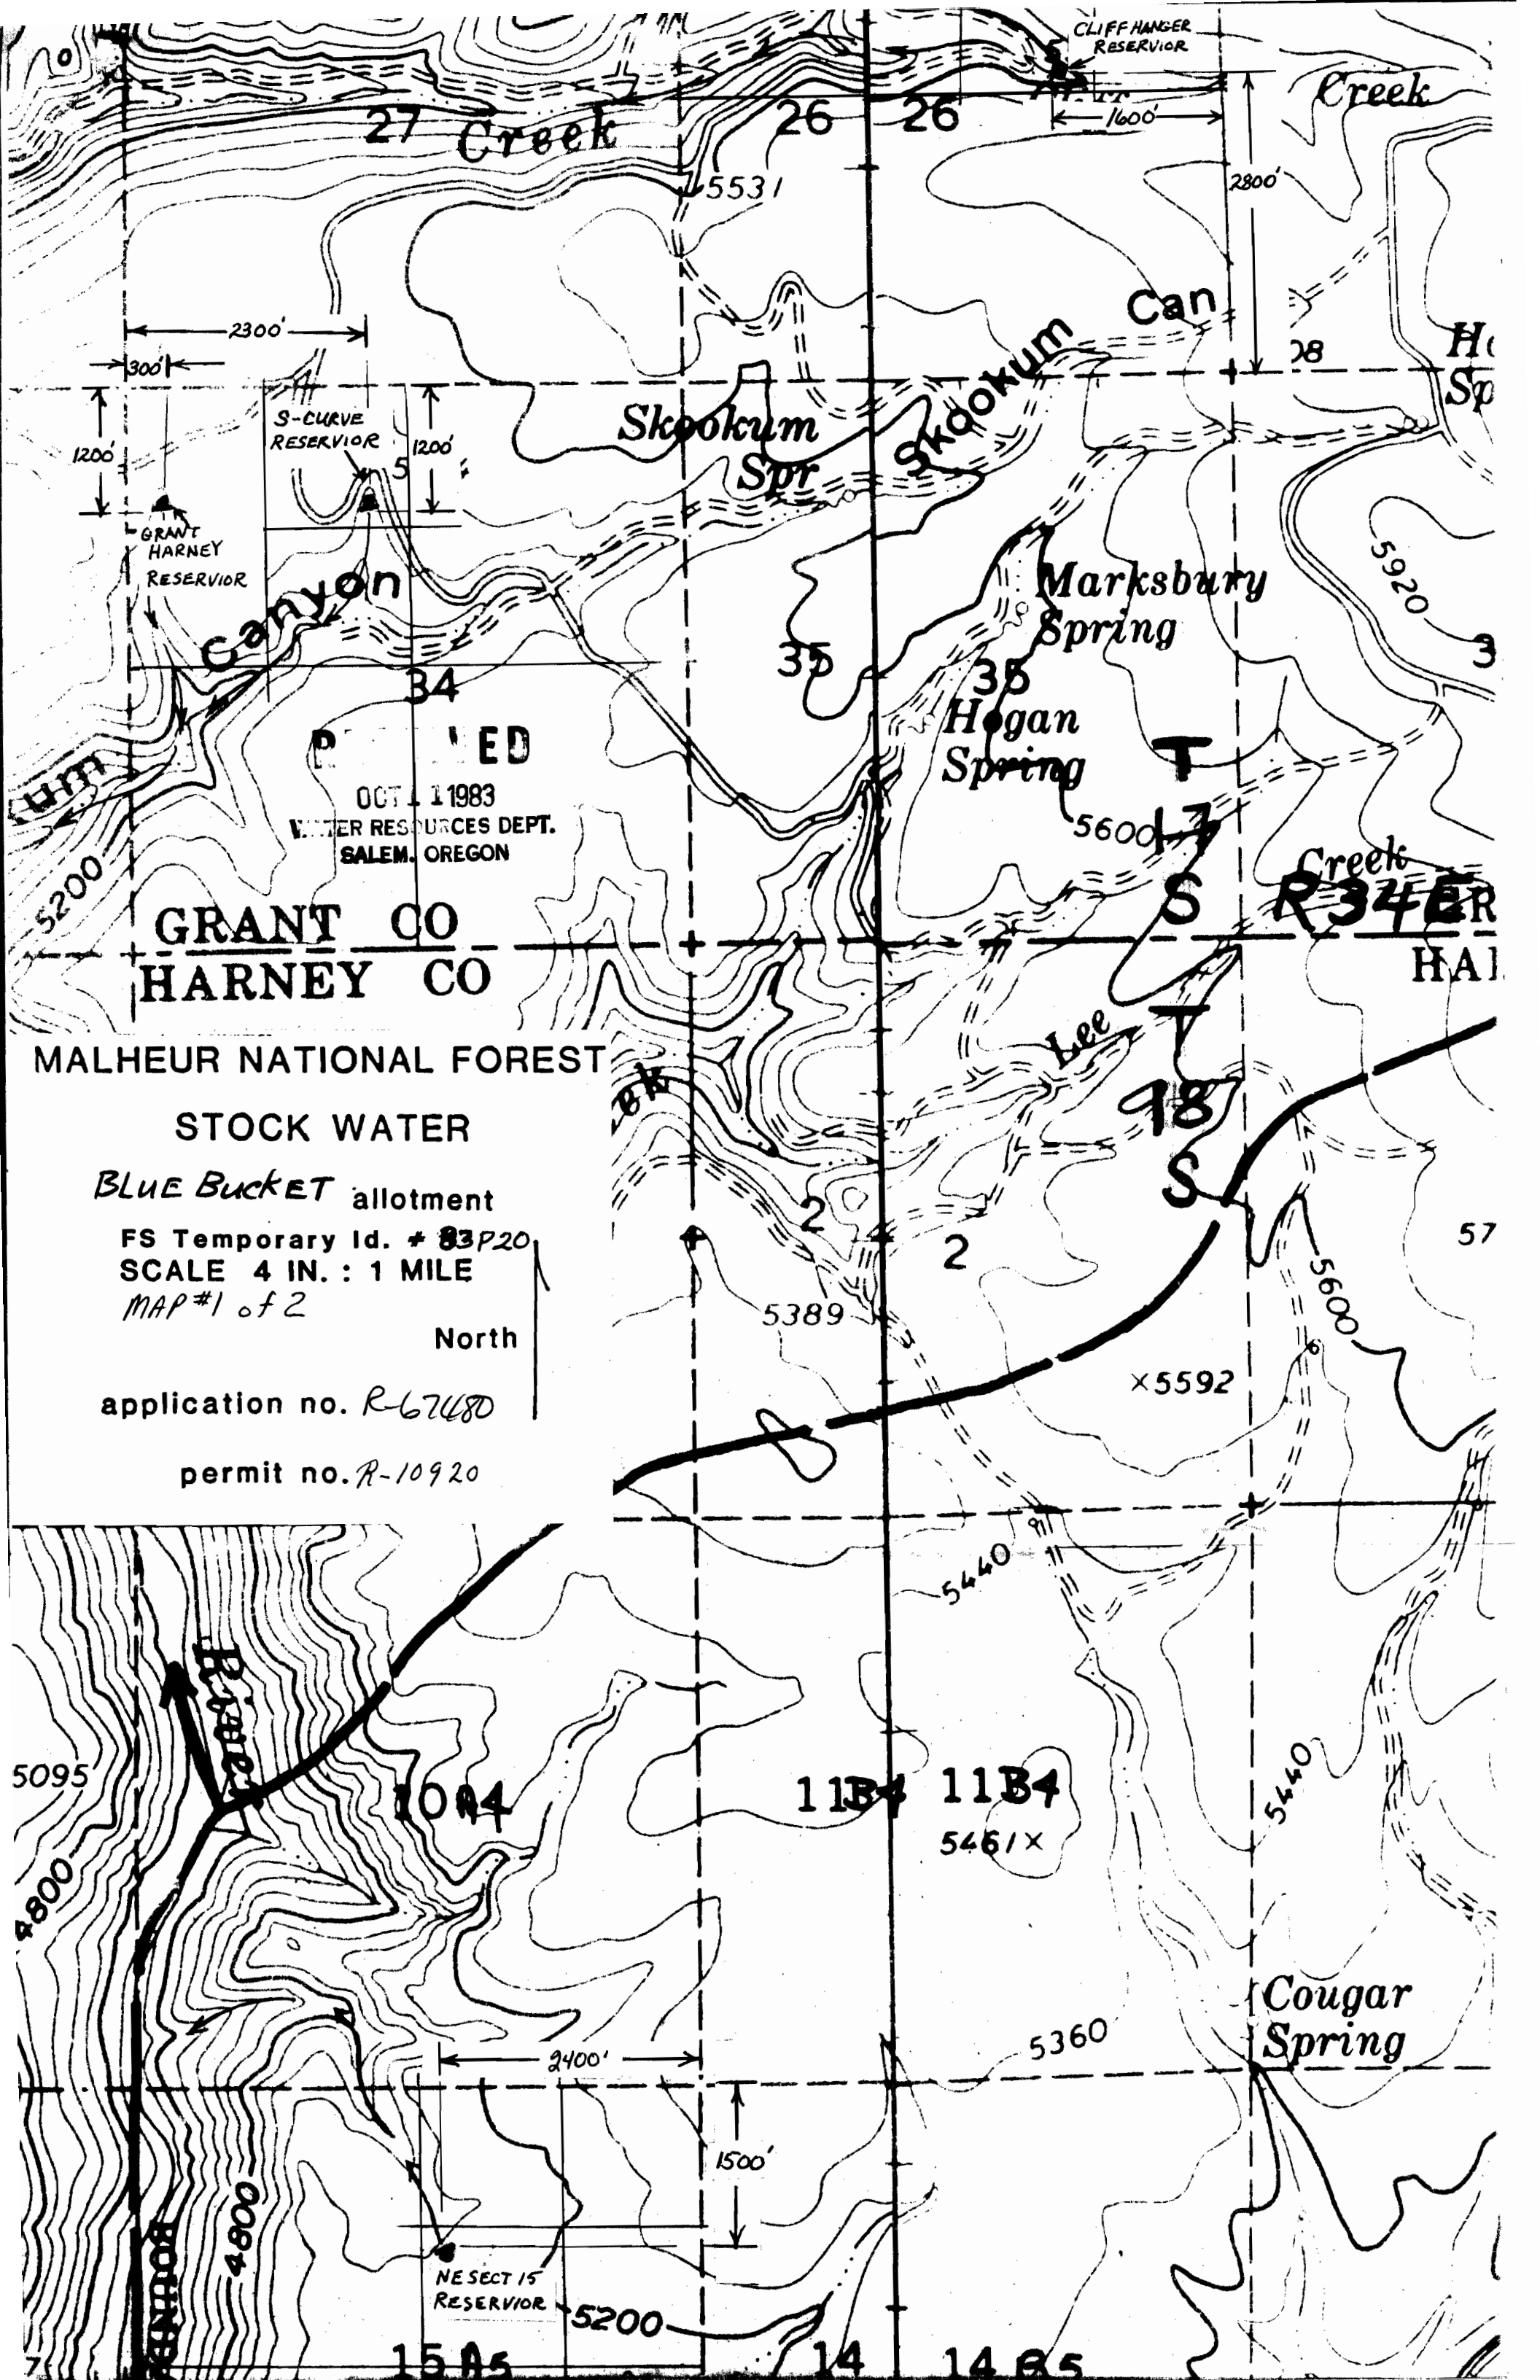

OCT 1 1983  
 WATER RESOURCES DEPT.  
 SALEM, OREGON

GRANT CO  
 HARNEY CO

MALHEUR NATIONAL FOREST

STOCK WATER

BLUE BUCKET allotment

FS Temporary Id. # 83P20

SCALE 4 IN. : 1 MILE

MAP #1 of 2

North

application no. R-67480

permit no. R-10920

