


T.16S. R.14E. W.M.

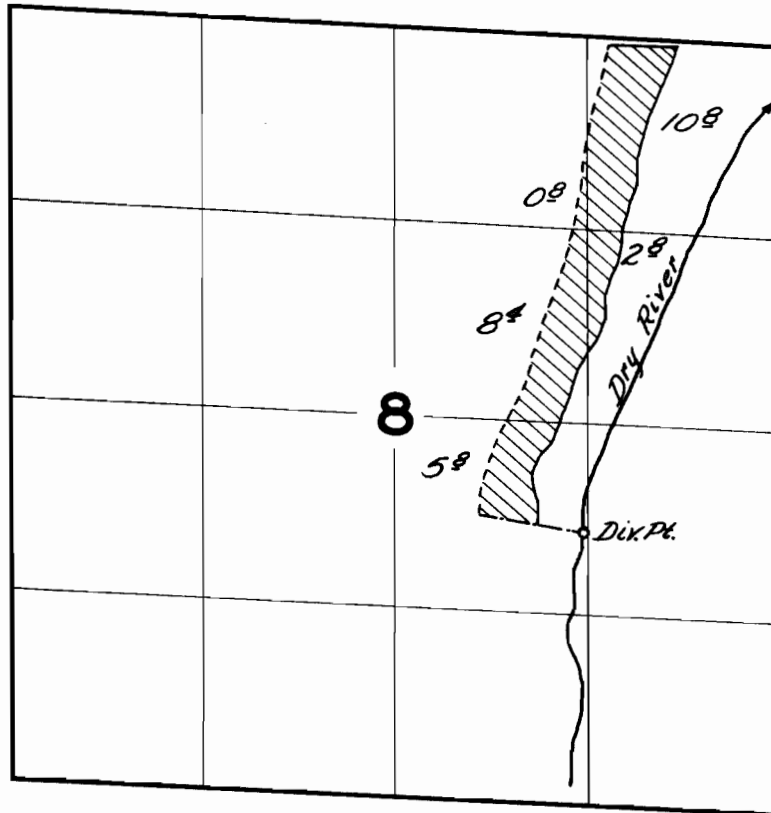

FINAL PROOF SURVEY
UNDER

Application No. 26083. Permit No. 20396
IN NAME OF

Jack McCaffery

Surveyed Aug. 8, 1957, by *C.R. Smith*