




FINAL PROOF SURVEY MAP

IN THE NAME OF GREG AND LAURIE LANG

SECTIONS 27 & 28, TOWNSHIP 29 SOUTH, RANGE 6 WEST, W.M.

APPLICATION 69314

PERMIT 50647

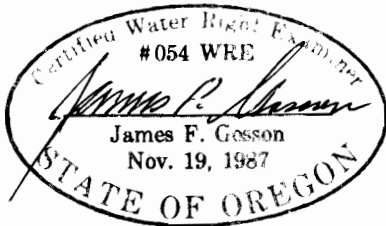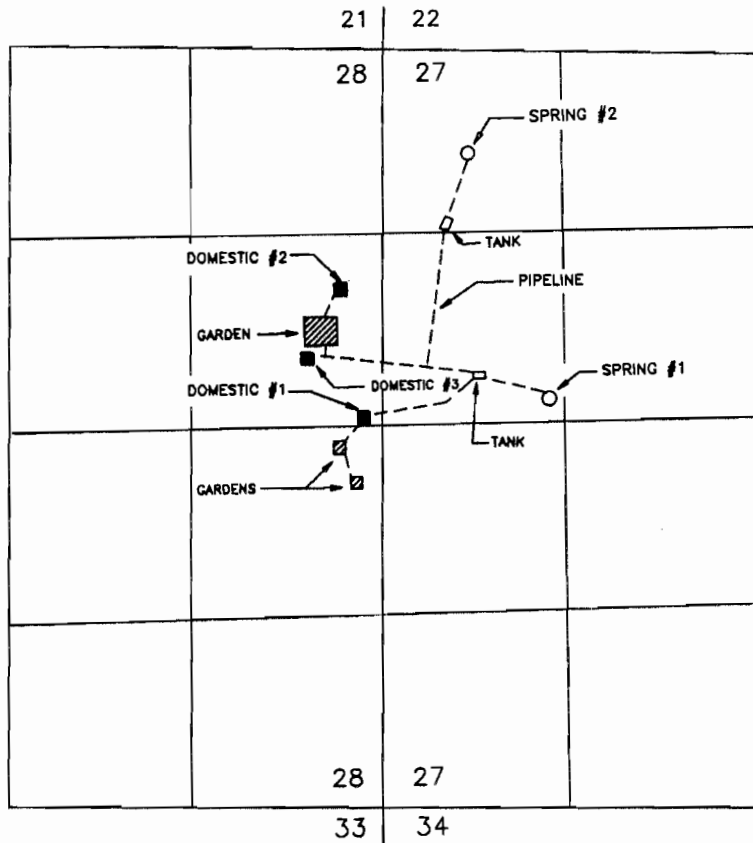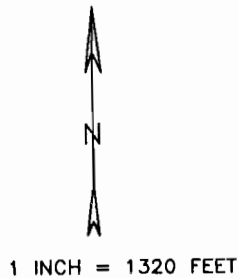

SPRING	FEET N/S	FEET E/W	FROM	1/4 1/4	SECTION
#1	150 N	1100 E	WEST 1/4 CORNER, SECTION 27	SW1/4 NW1/4	27
#2	1800 N	600 E	WEST 1/4 CORNER, SECTION 27	NW1/4 NW1/4	27

BOTH SPRINGS BEING WITHIN TOWNSHIP 29 SOUTH, RANGE 6 WEST, W.M., DOUGLAS COUNTY.

THE PURPOSE OF THIS MAP IS TO IDENTIFY THE LOCATION OF THE WATER RIGHT. IT IS NOT INTENDED TO PROVIDE INFORMATION RELATIVE TO THE LOCATION OF PROPERTY OWNERSHIP BOUNDARY LINES.