


T. 3N. R. 29E. W.M.

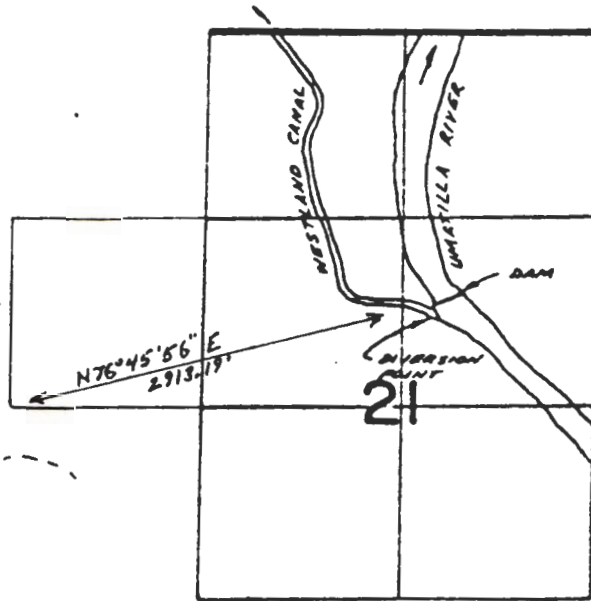


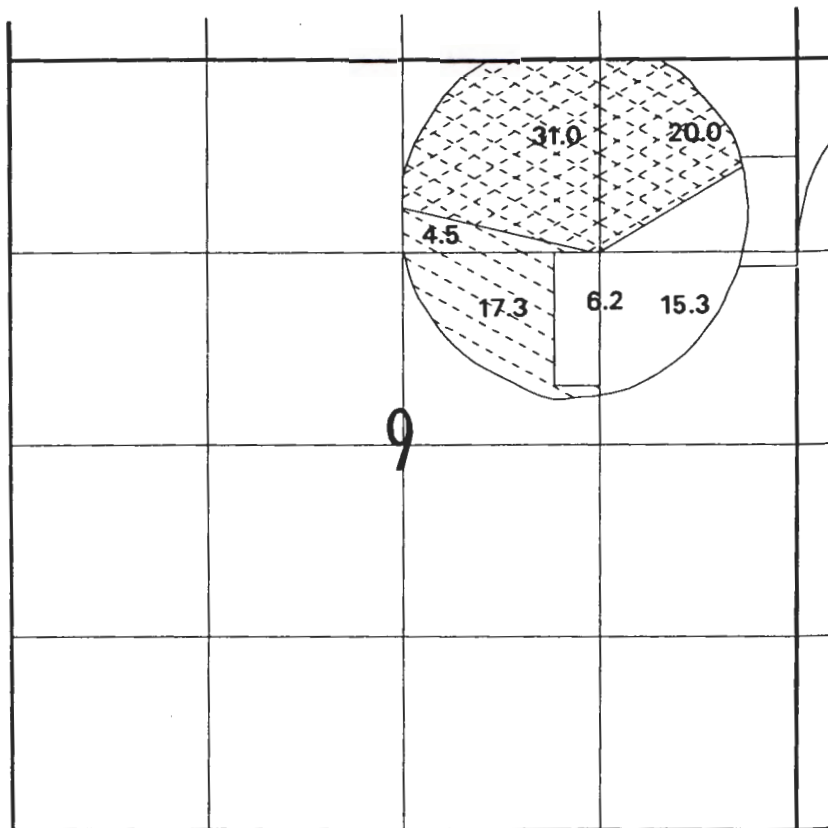
Application No. 61696
Permit No. 49337

TOWNSHIP 3 N., RANGE 27 E., W.M.

FINAL PROOF TRI-SET INC.

C. 77604  TRANSFER 5611

C. 77603  PERMIT 49337



SCALE: 1 Inch = 1320 Feet

SURVEYED 1989

FINAL MAP SEPT 2001