



SECTION



STATE ENGINEER

North

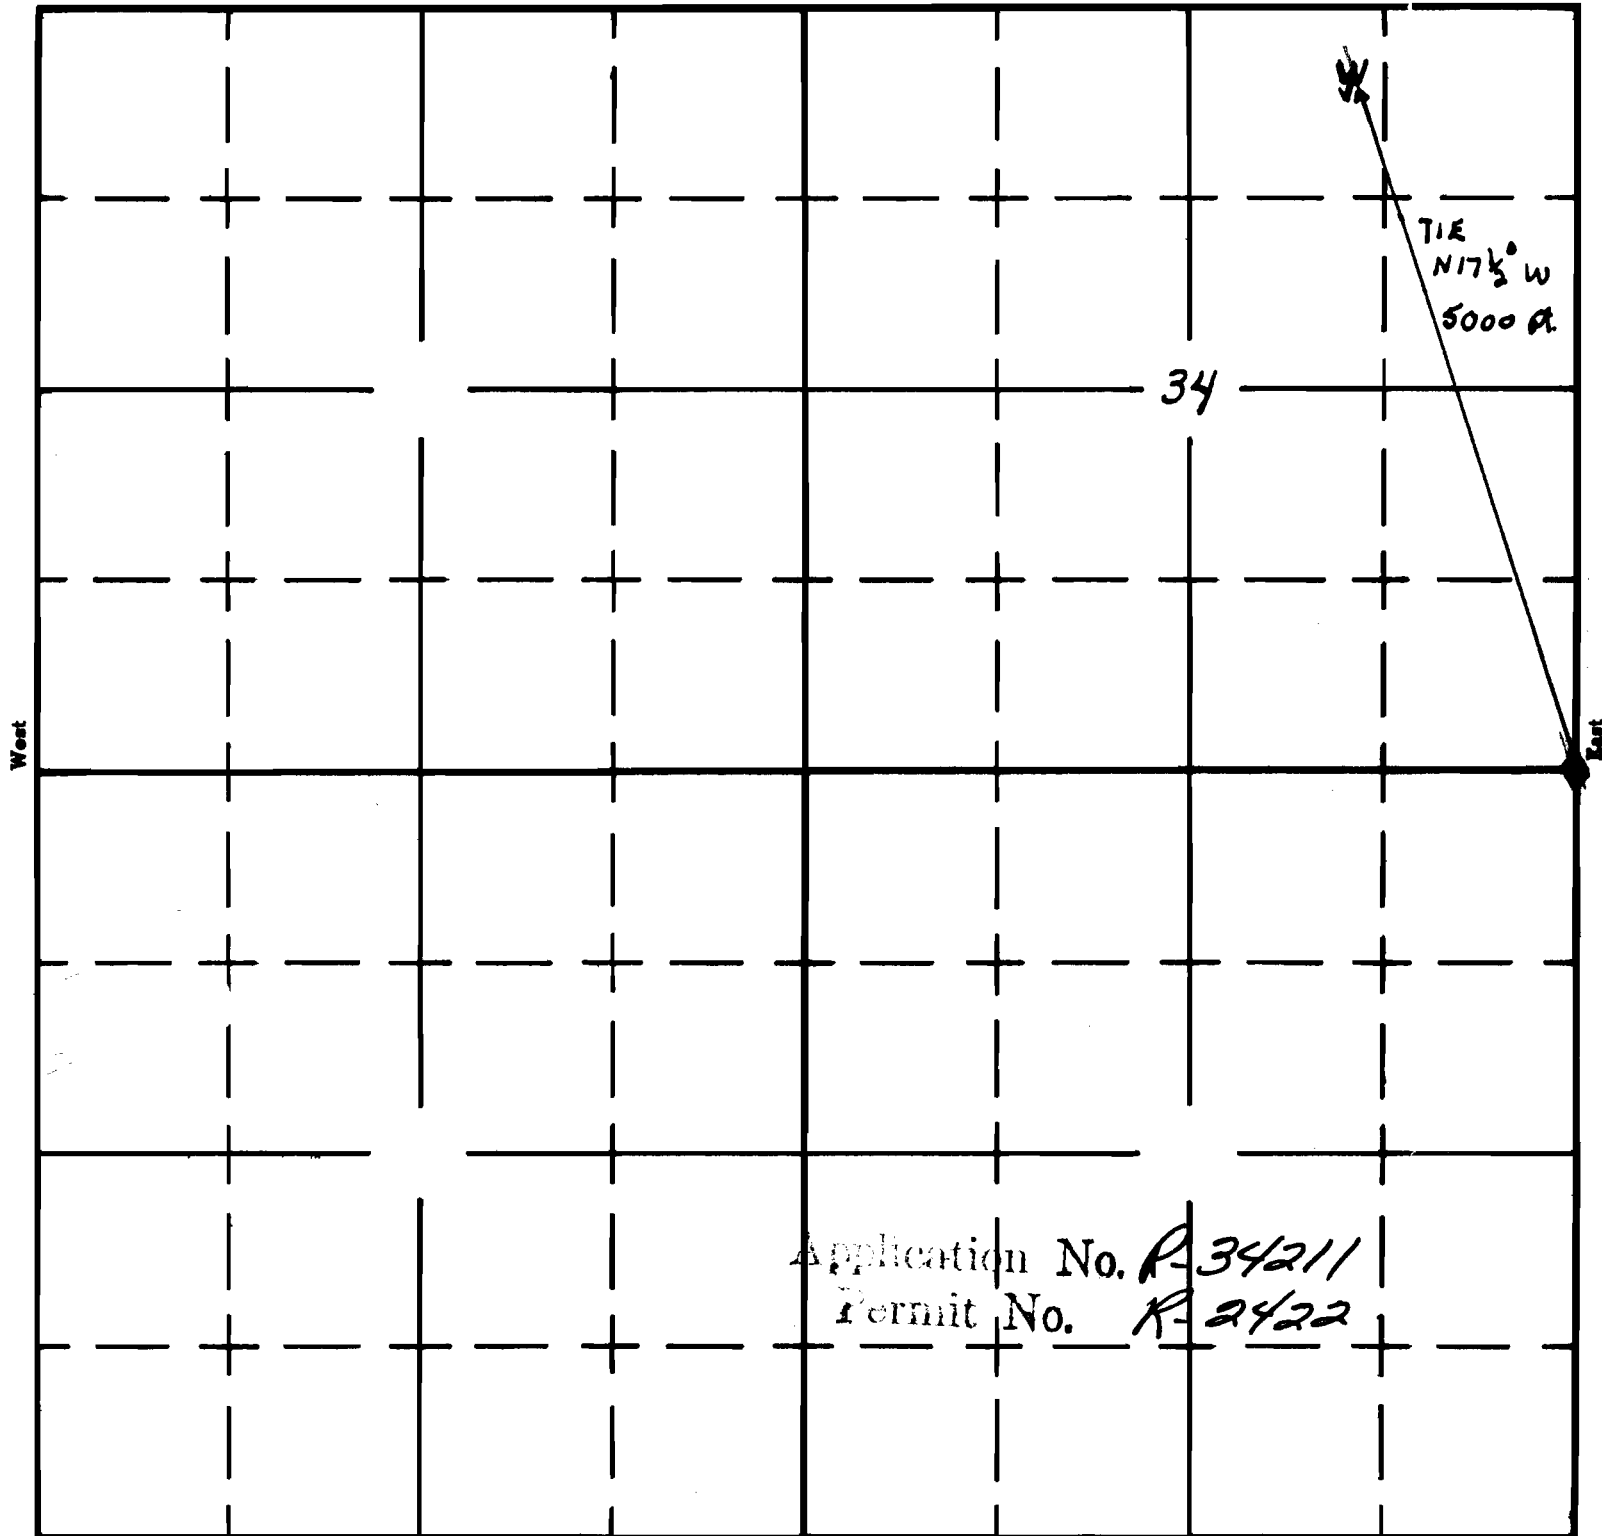

PROJECT

South

FOUND SURVEY CORNER

APPLICATION No.

PERMIT No.