


UNITED STATES
DEPARTMENT OF THE INTERIOR
BUREAU OF LAND MANAGEMENT

SECTION

Oregon State Water Filings

TOWNSHIP 27S, RANGE 14E, W. M.

North SCHUMACHER ~~W~~ RESERVOIR RECONSTRUCTION

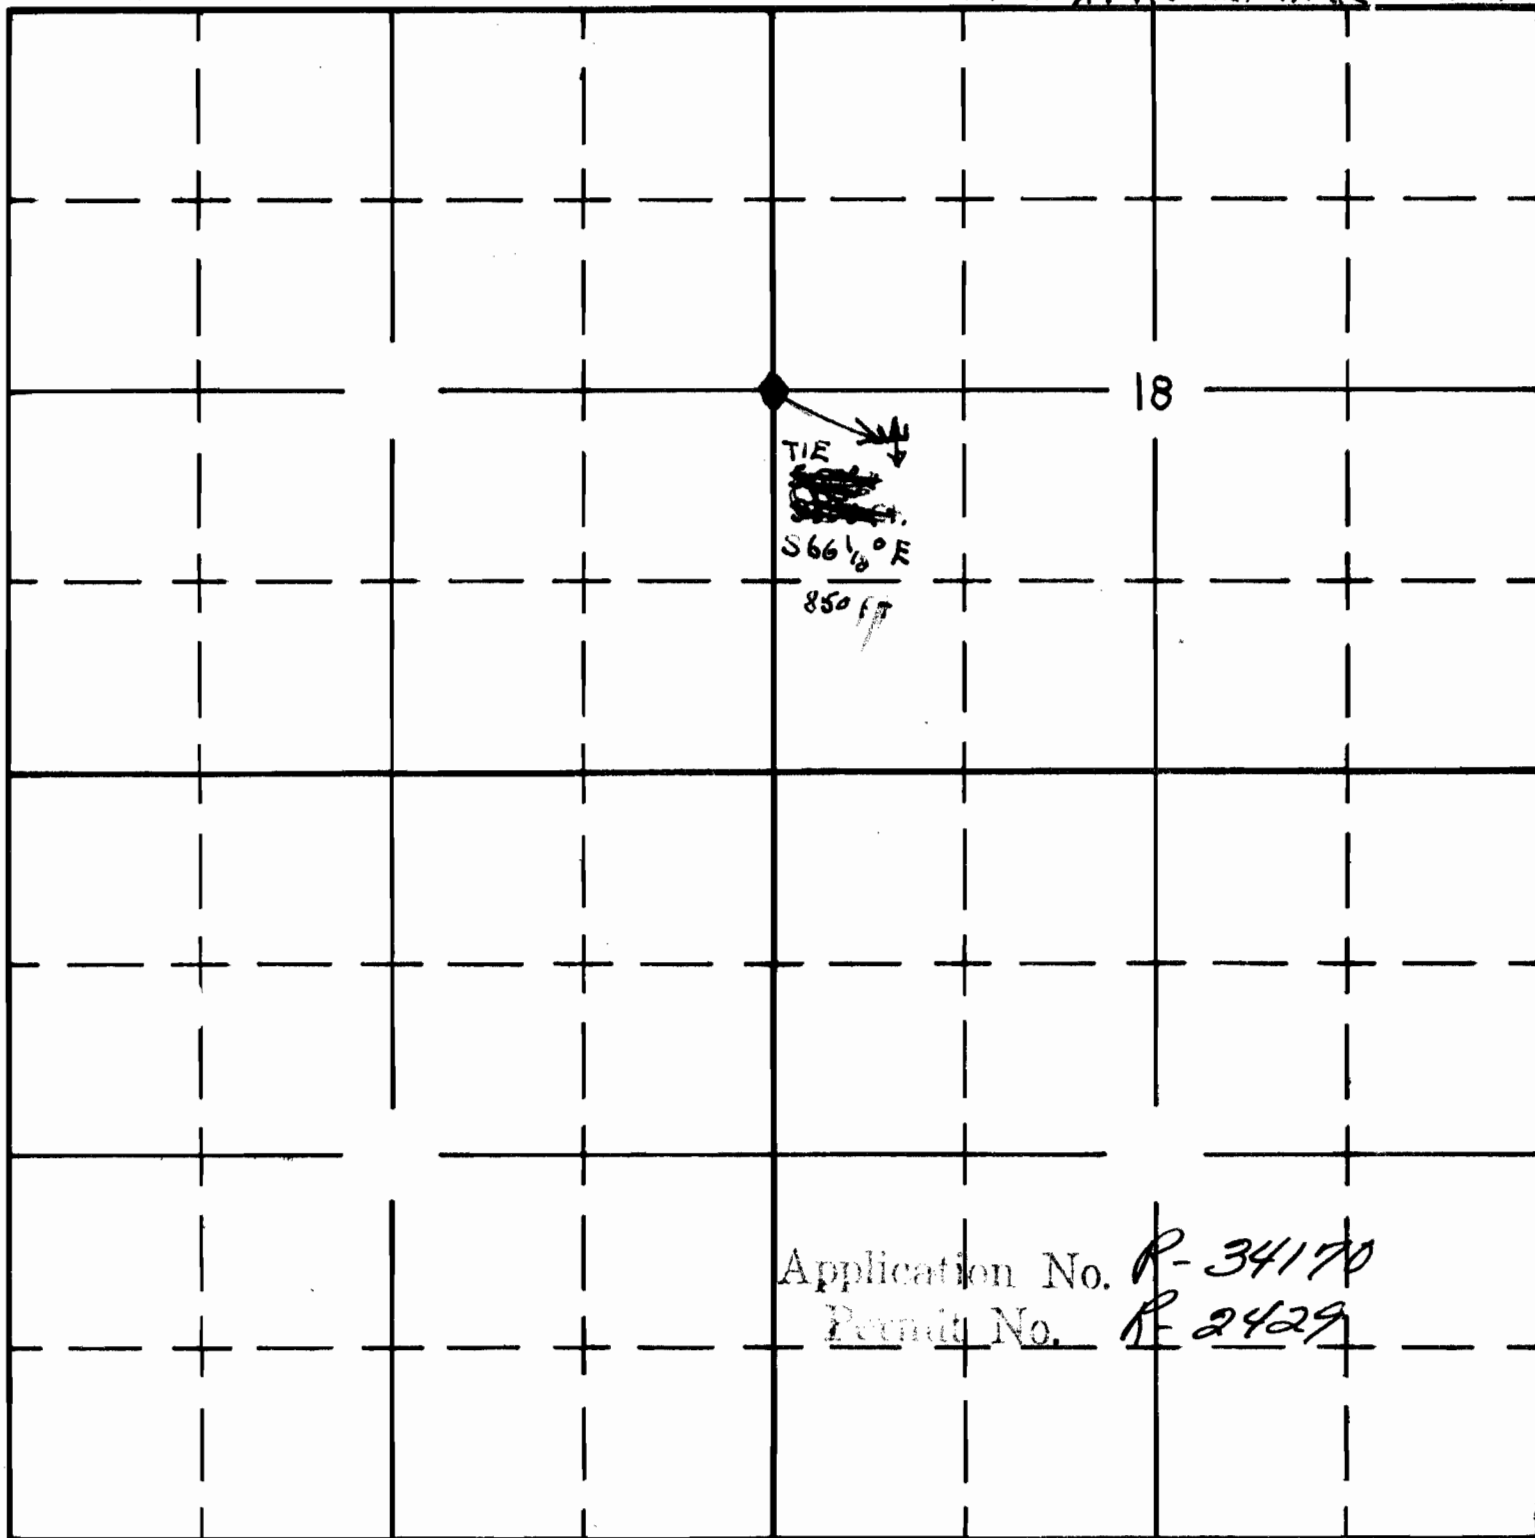

◆ FOUND SURVEY CORNER

South

W PROJECT

APPLICATION No.

PERMIT No.