

UNITED STATES
DEPARTMENT OF THE INTERIOR
BUREAU OF LAND MANAGEMENT


RECEIVED
JUL 29 1960
DATE FILLED

SECTION

Oregon State Water Filings

TOWNSHIP 27S, RANGE 14E, W. M.

North

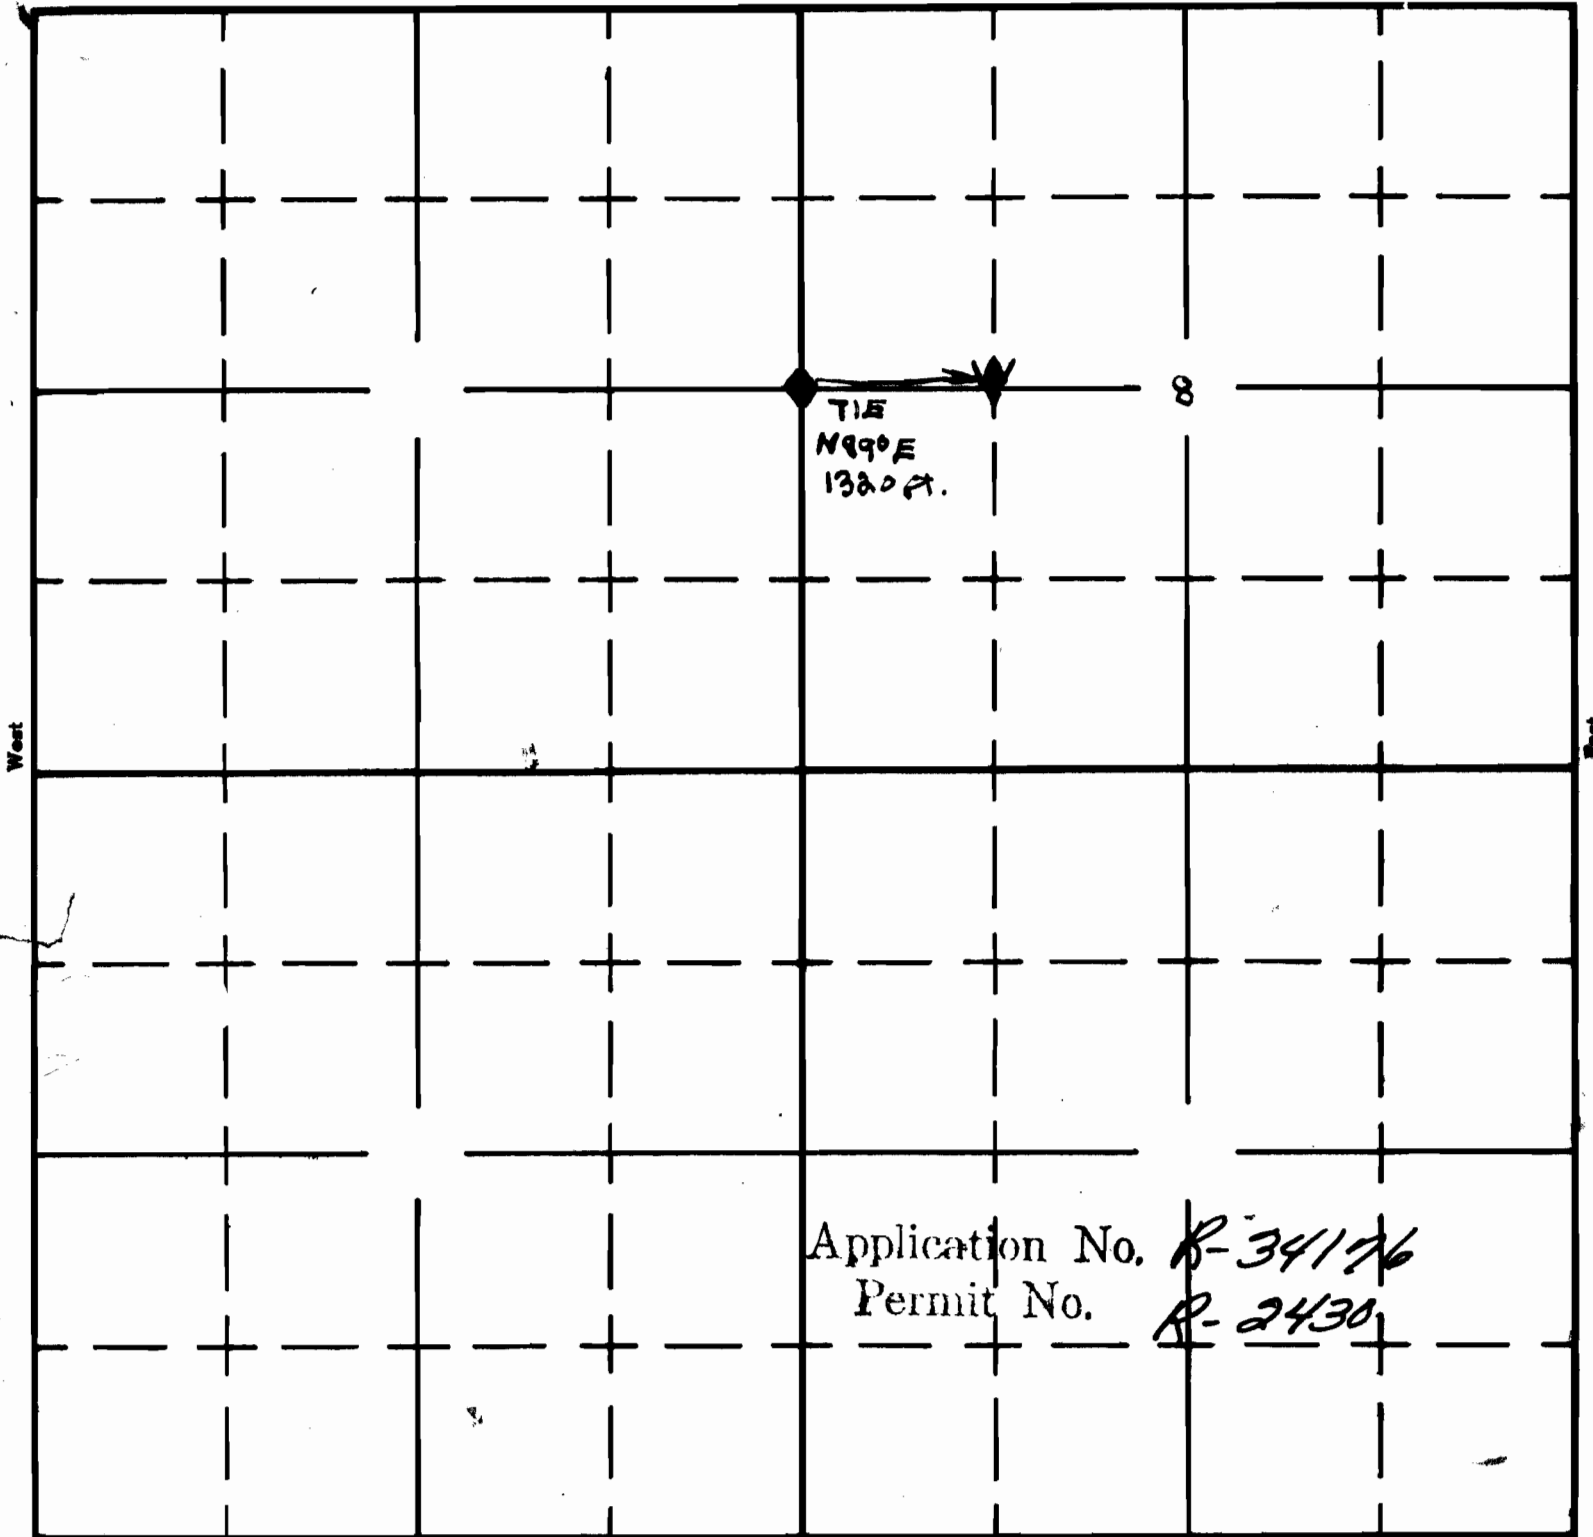

Application No. R-34176
Permit No. R-2430

◆ FOUND SURVEY CORNER
W PROJECT

South

APPLICATION No.
PERMIT No.