


UNITED STATES
DEPARTMENT OF THE INTERIOR
BUREAU OF LAND MANAGEMENT

SECTION

Oregon State Water Filings

TOWNSHIP 27S, RANGE 14E, W. M.

North

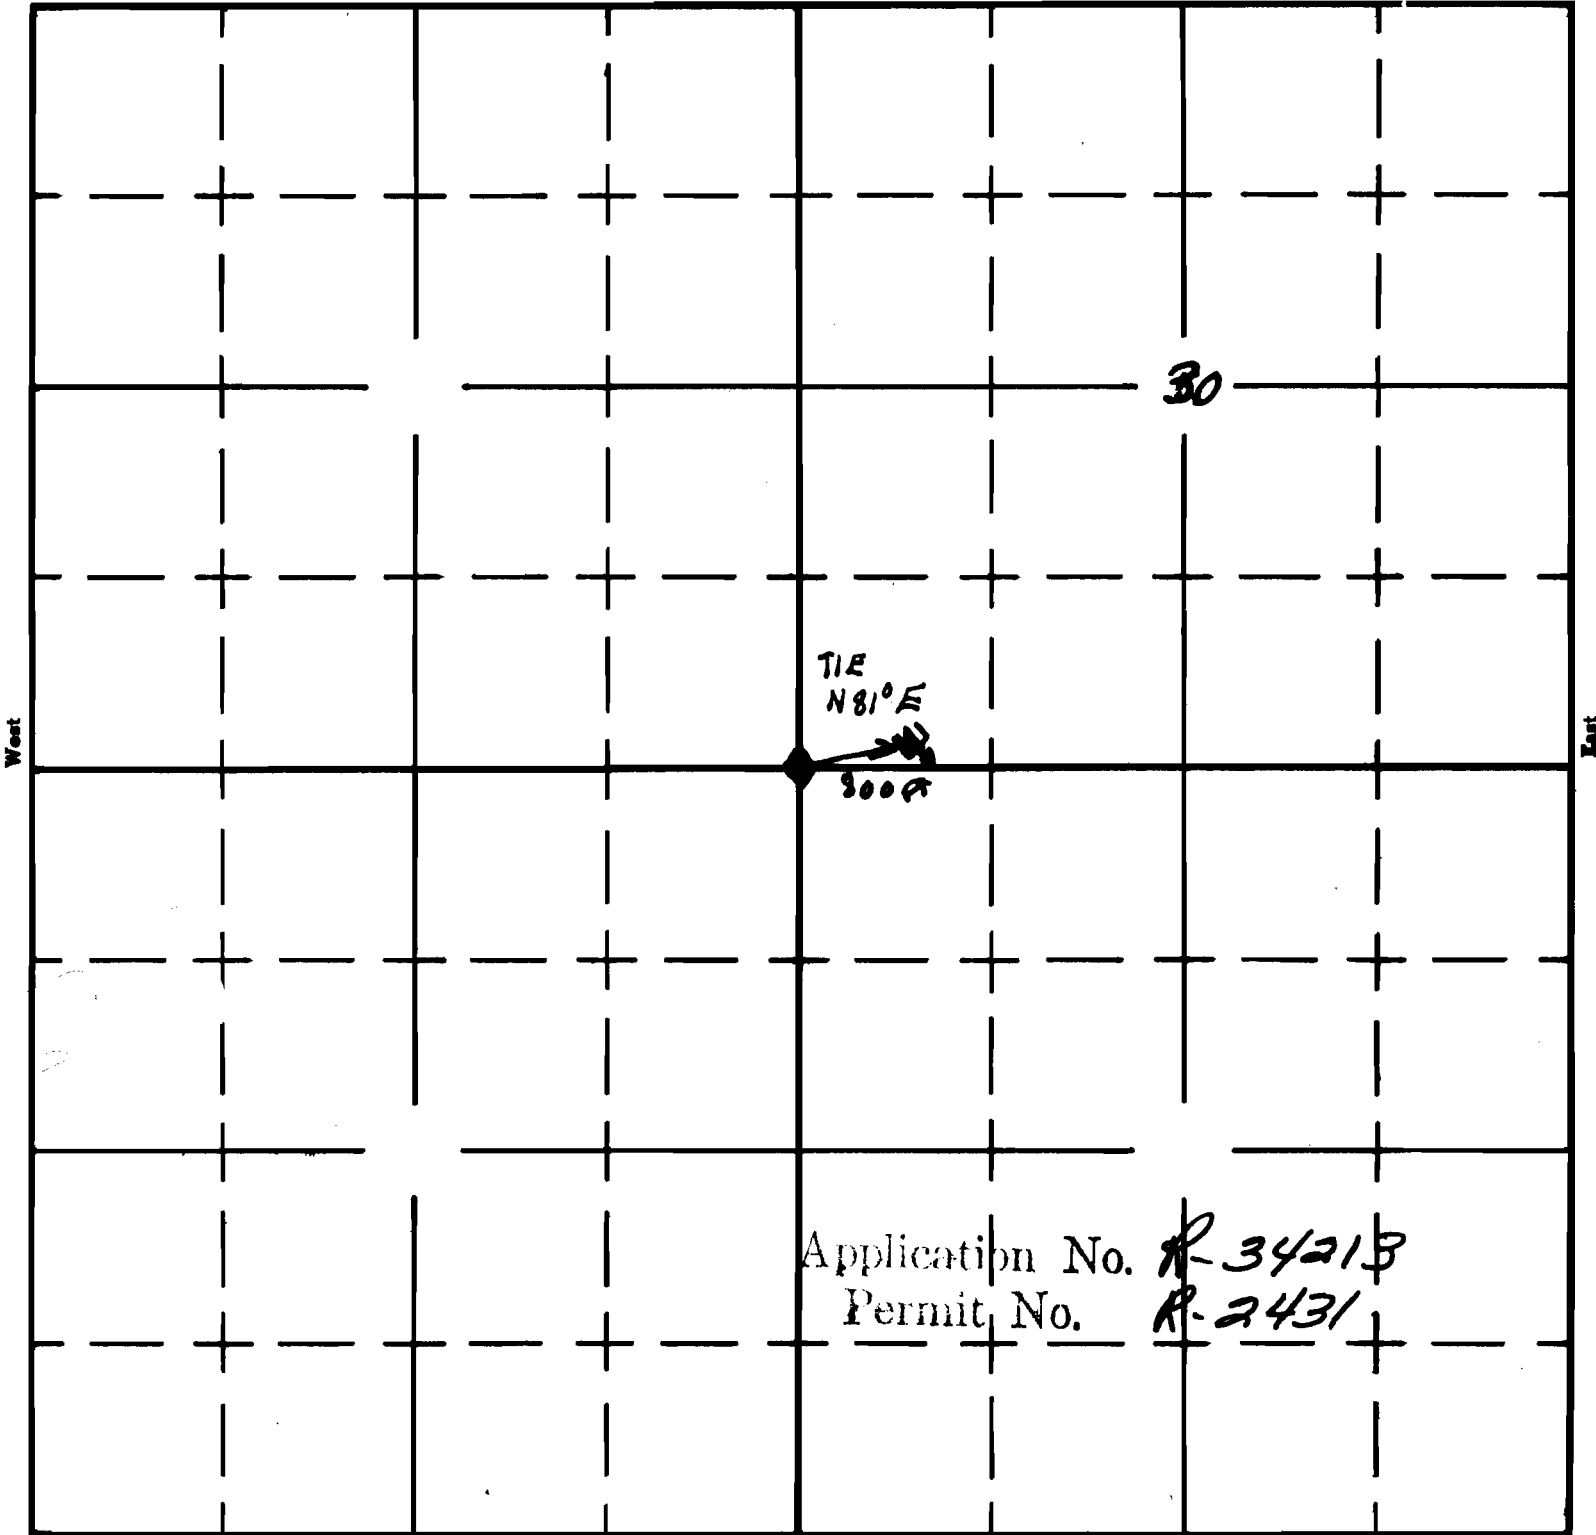

FOUND SURVEY CORNER



PROJECT

South

APPLICATION No.

PERMIT No.