

UNITED STATES
DEPARTMENT OF THE INTERIOR
BUREAU OF LAND MANAGEMENT


SECTION _____

Oregon State Water Filings

TOWNSHIP 28 S, RANGE 13 E, W. M.



North

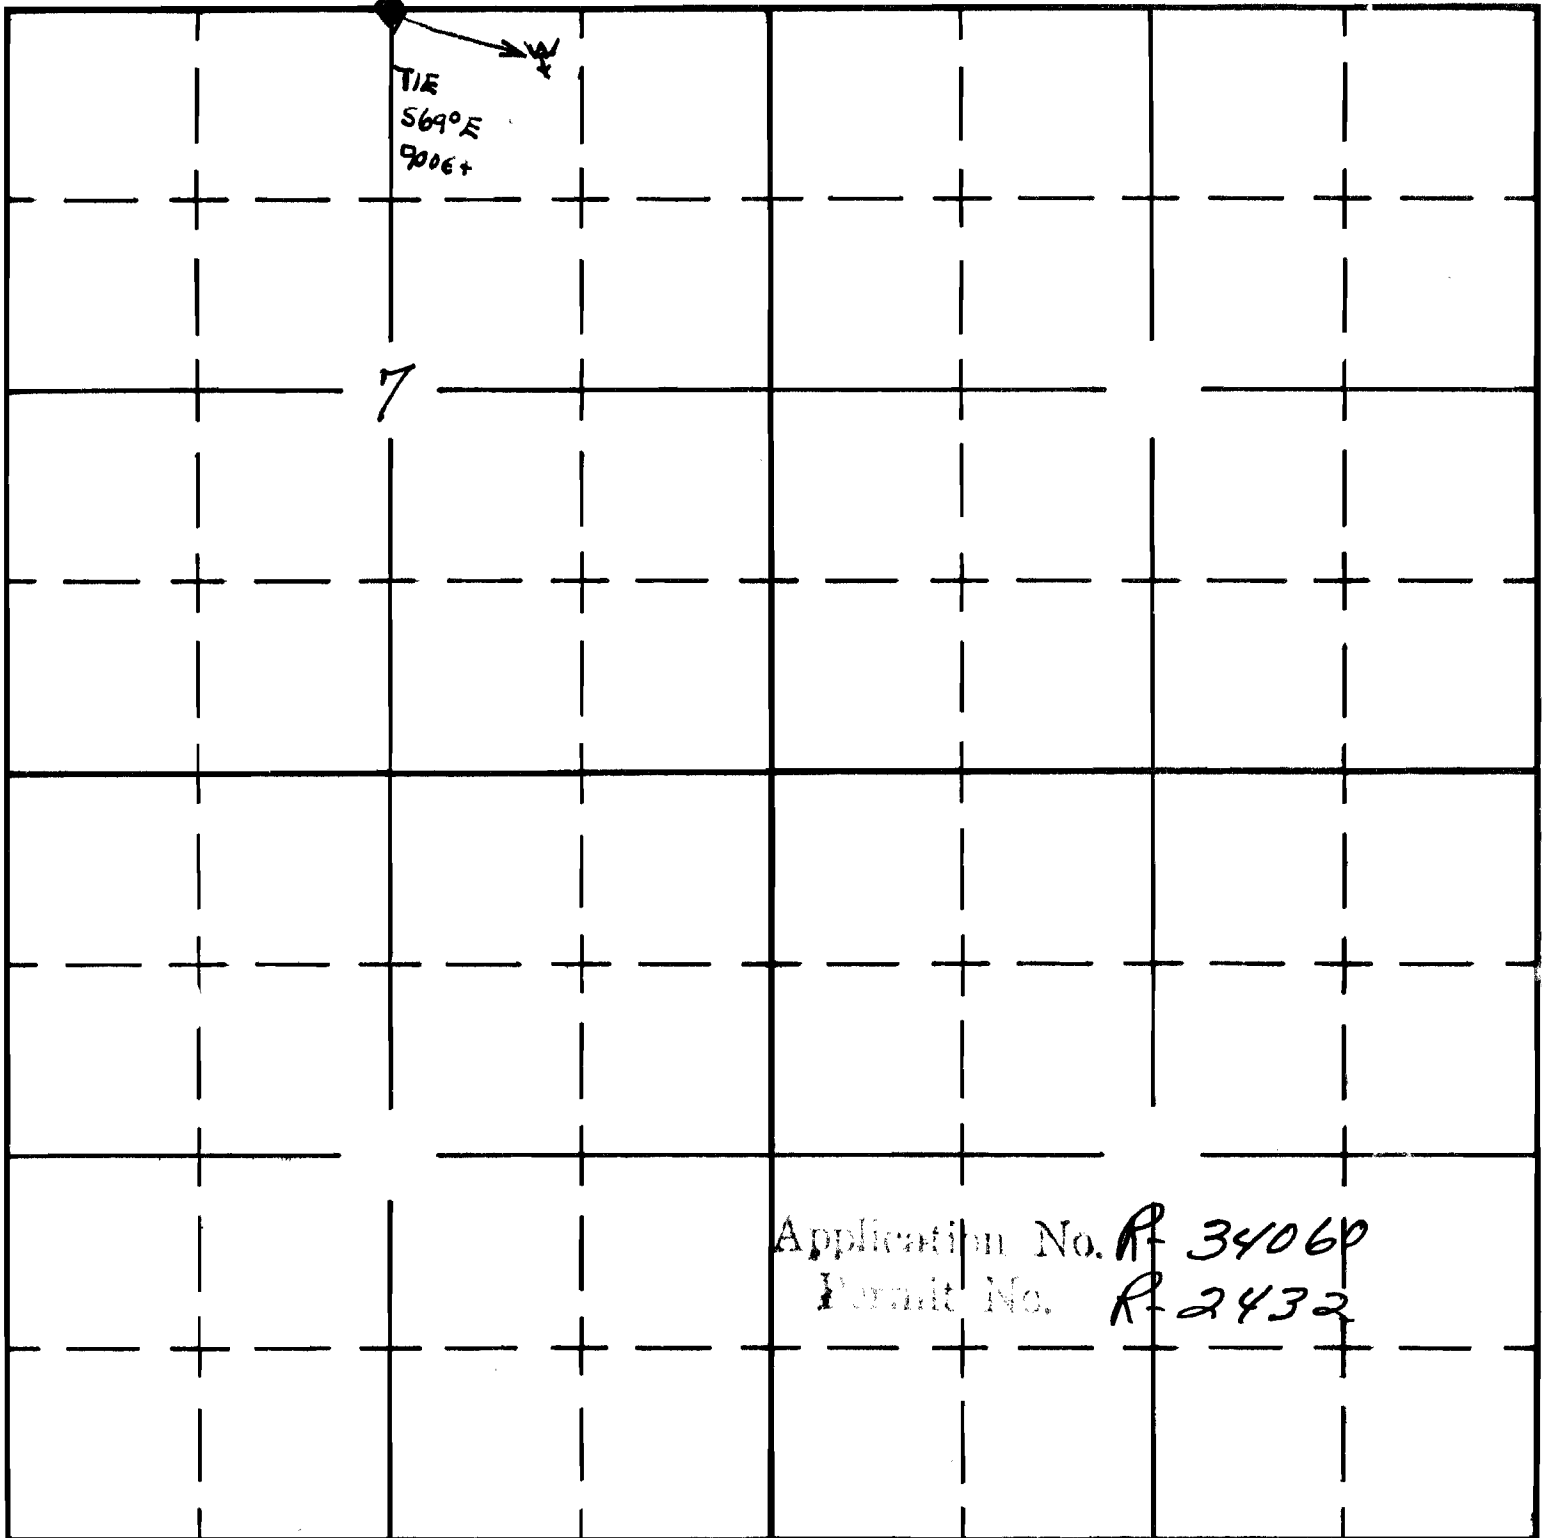

◆ FOUND SURVEY CORNER

South

W PROJECT

APPLICATION No.

PERMIT No.