


UNITED STATES
DEPARTMENT OF THE INTERIOR
BUREAU OF LAND MANAGEMENT

SECTION _____

Oregon State Water Filings

TOWNSHIP 28S, RANGE 13E, W. M.

North DRAINAGE RESERVOIR

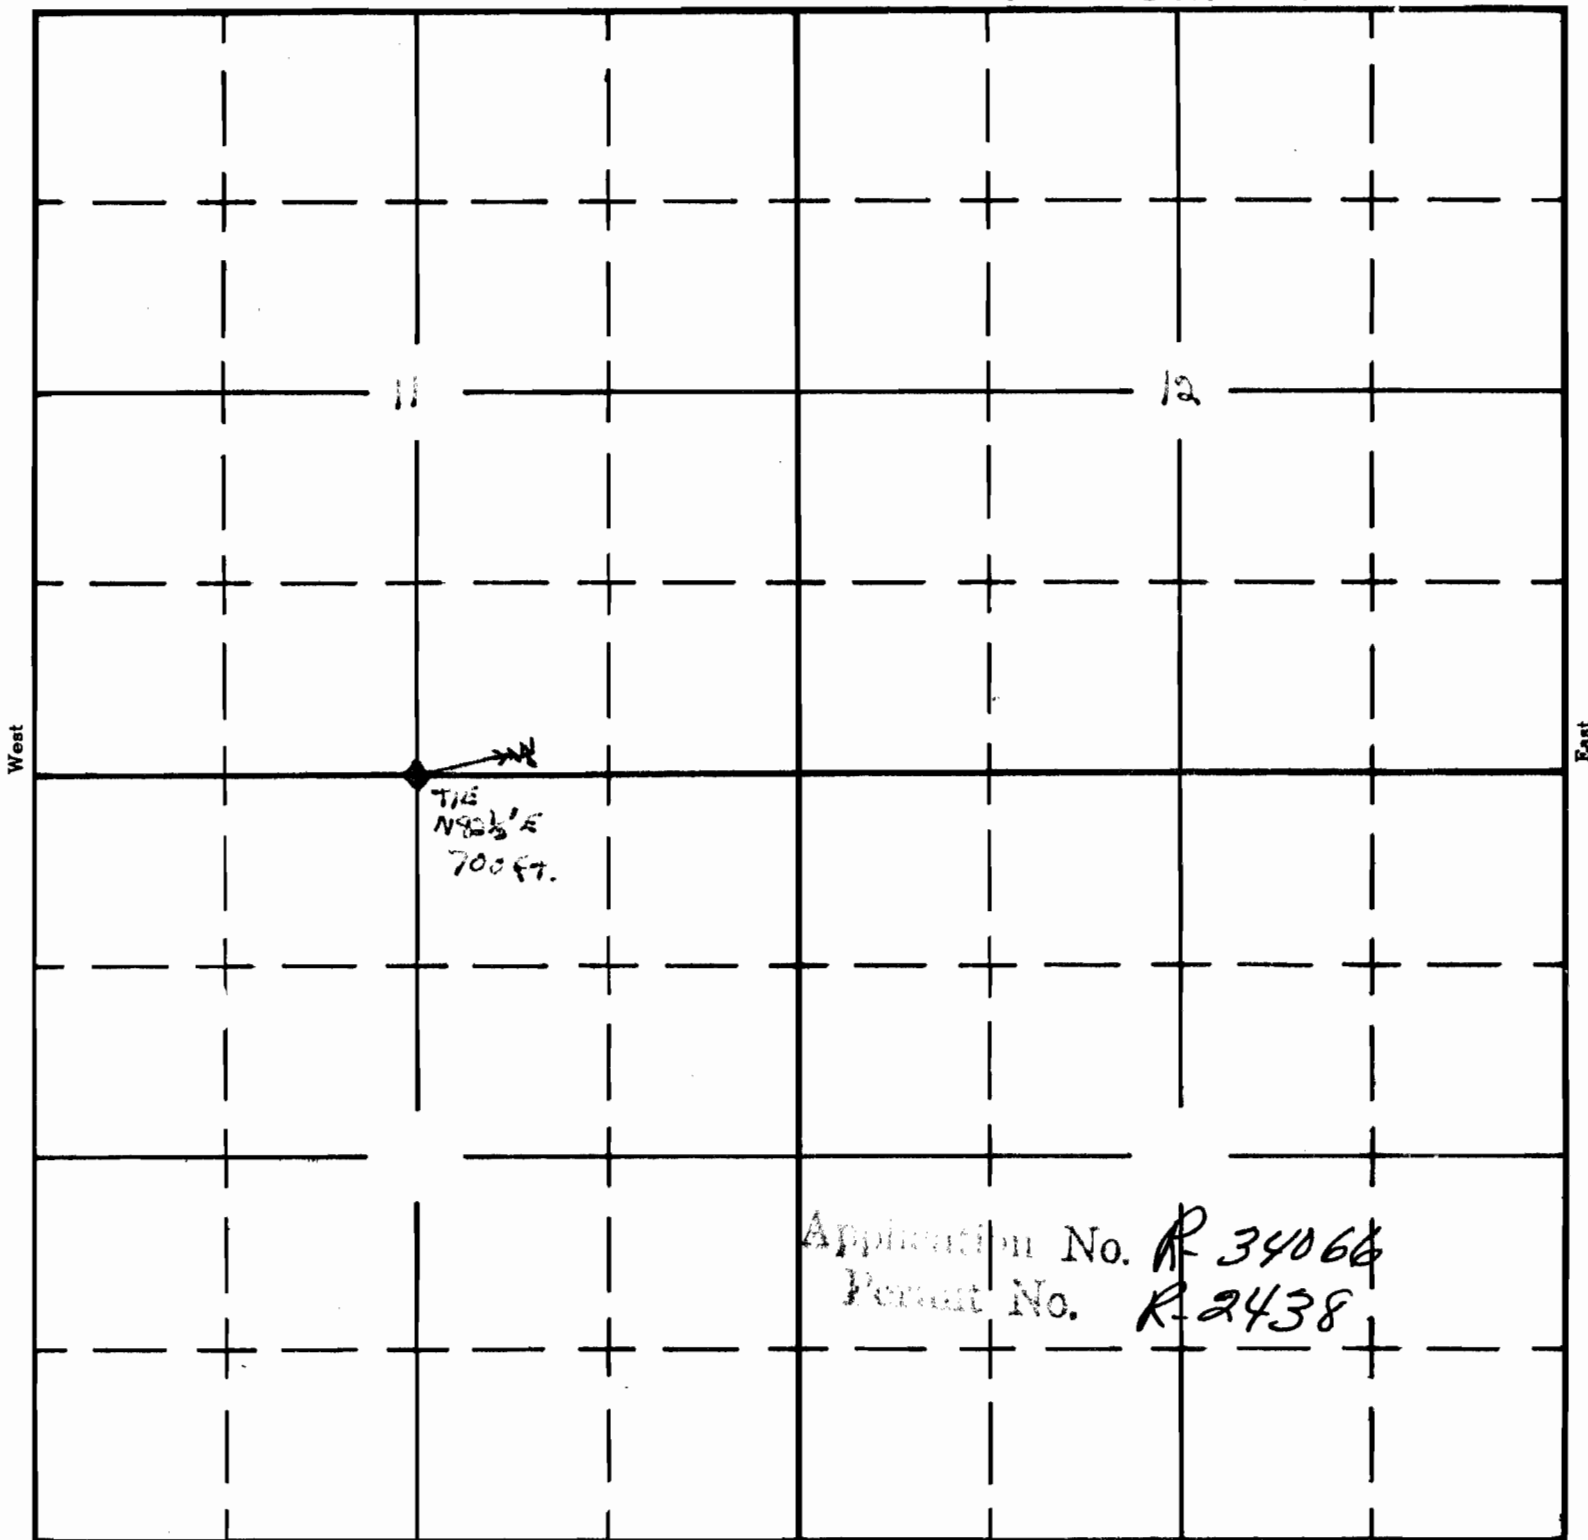

◆ FOUND SURVEY CORNER

W PROJECT

South

APPLICATION No.

PERMIT No.