

UNITED STATES
DEPARTMENT OF THE INTERIOR
BUREAU OF LAND MANAGEMENT


SECTION _____

Oregon State Water Filings

TOWNSHIP 28S, RANGE 13E, W. M.

North

TED RESERVOIR

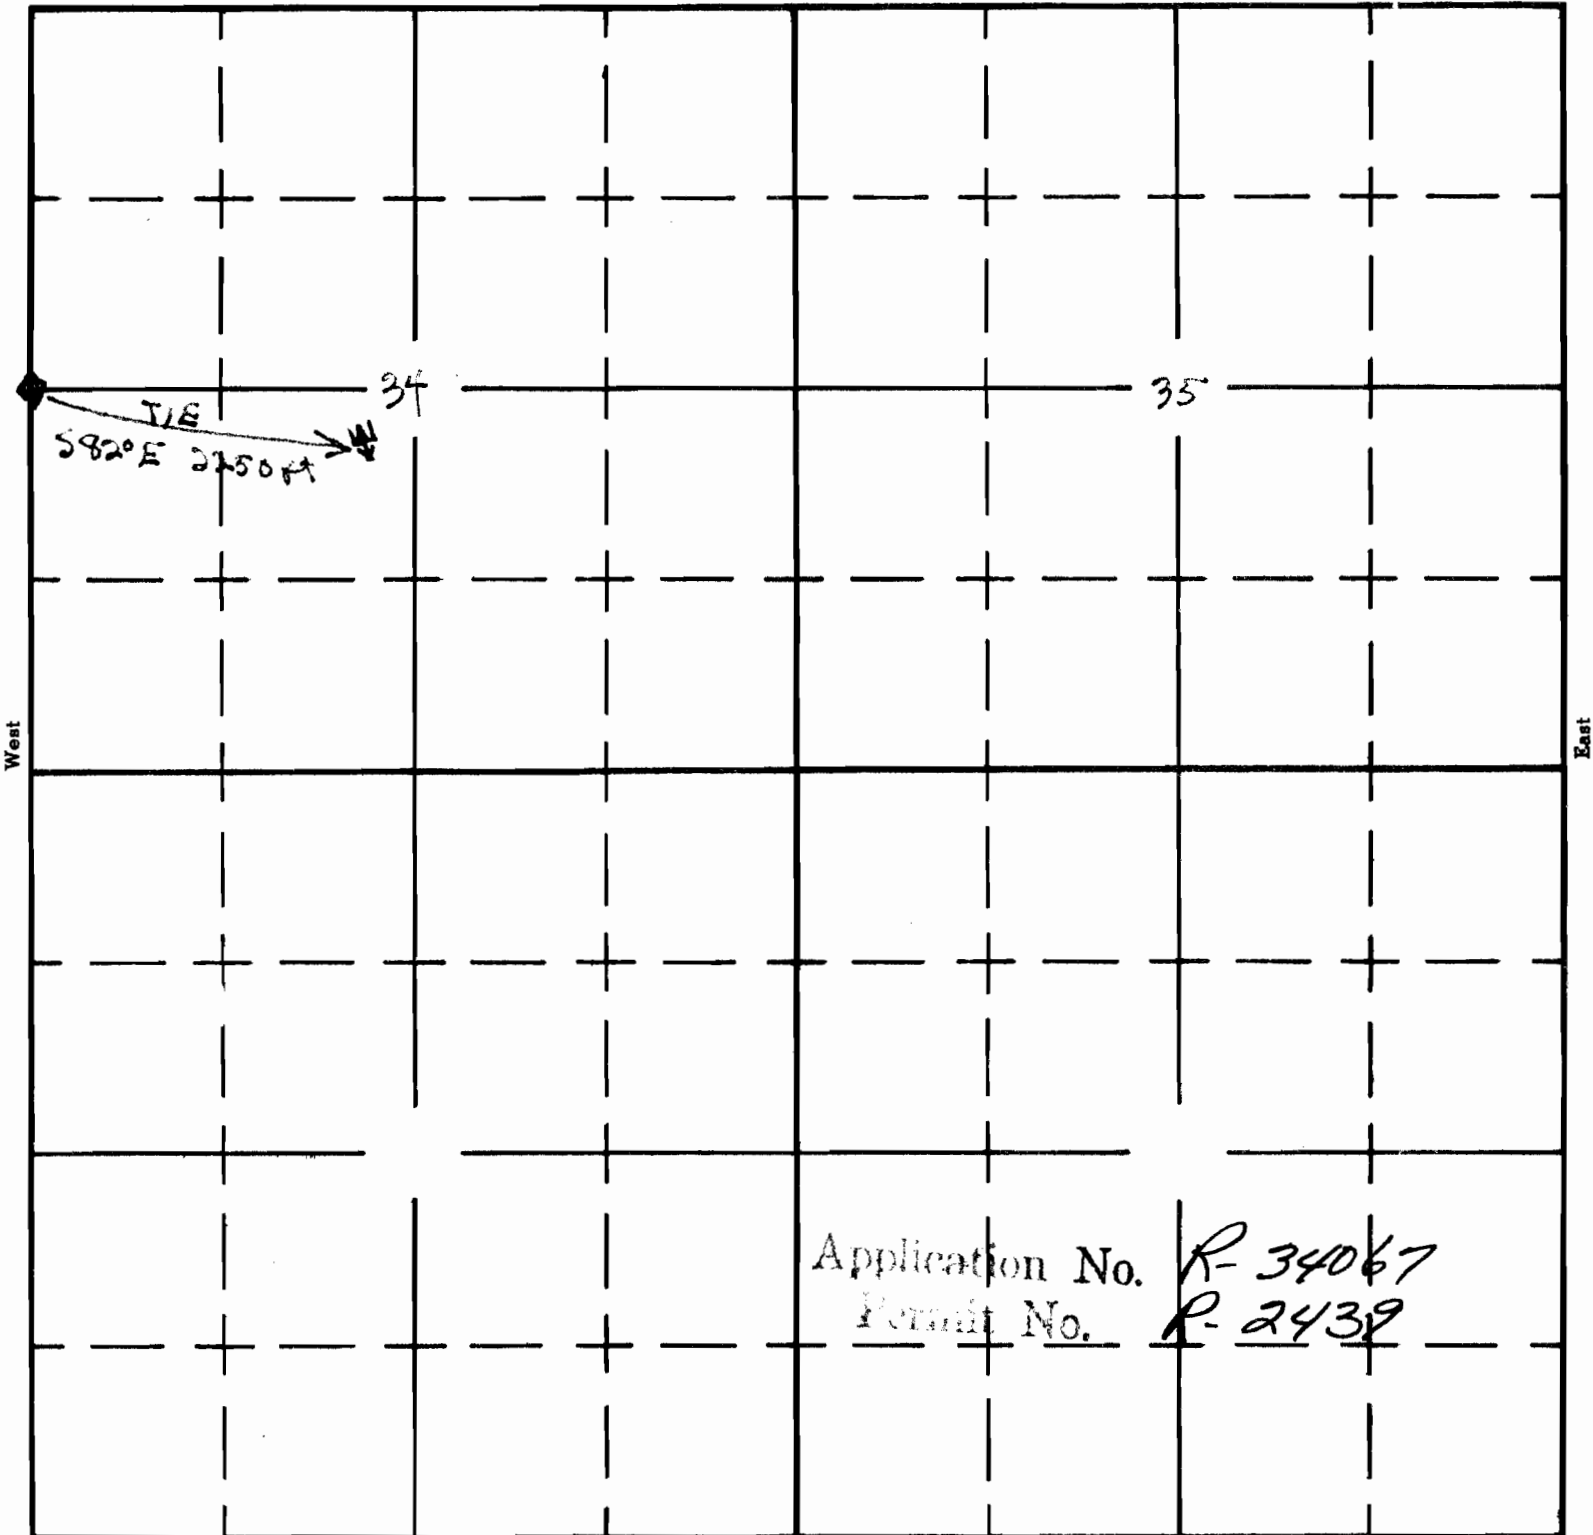

◆ FOUND SURVEY CORNER

South

W PROJECT

Application No.

R-34067

Permit No.

R-2439

APPLICATION No.

PERMIT No.