


UNITED STATES
DEPARTMENT OF THE INTERIOR
BUREAU OF LAND MANAGEMENT

SECTION _____

Oregon State Water Filings

TOWNSHIP 28 S, RANGE 13 E, W. M.

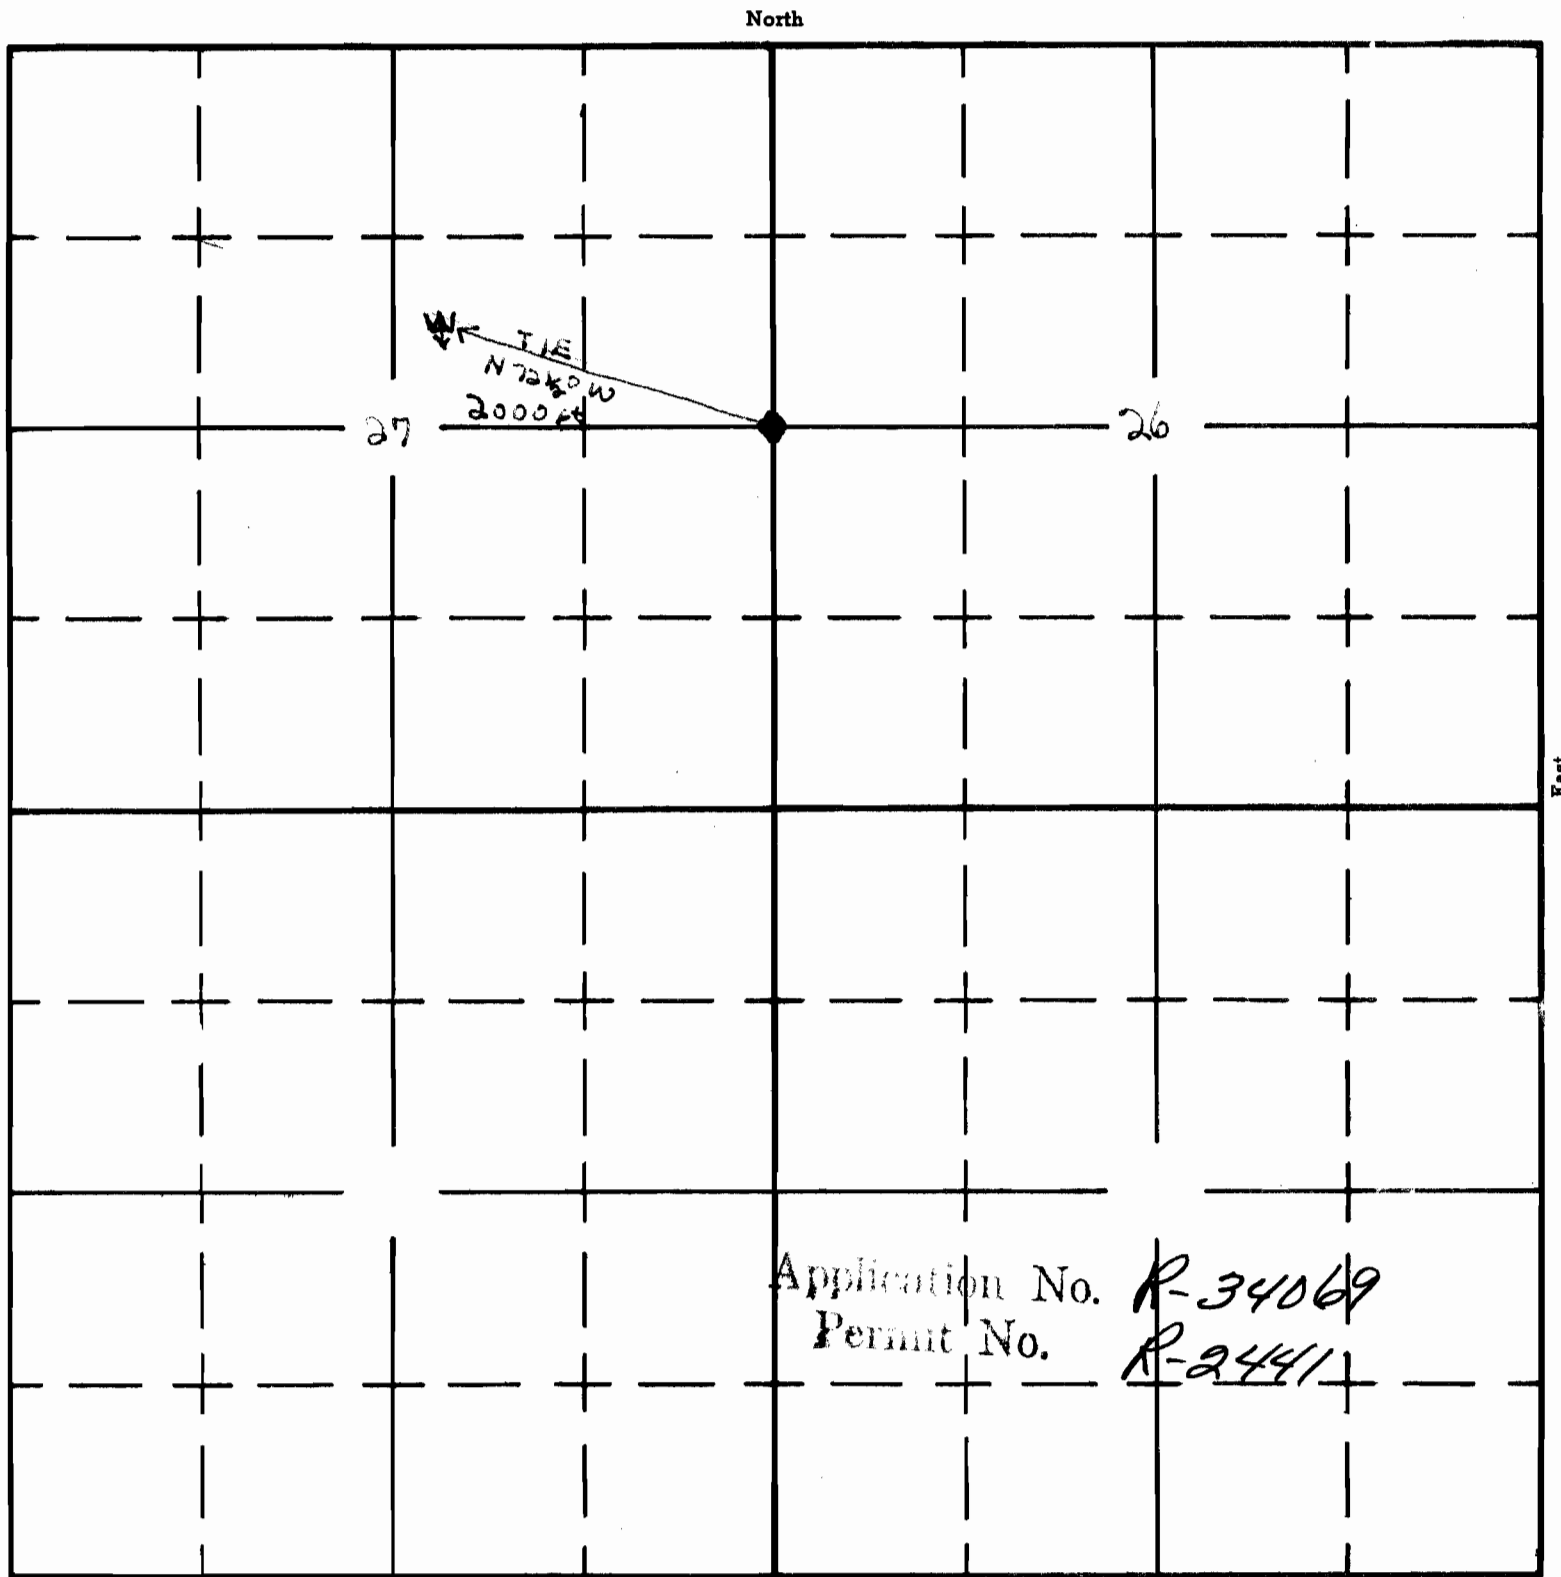

◆ FOUND SURVEY CORNERS
W PROJECT

South

APPLICATION No.
PERMIT No.