

UNITED STATES
DEPARTMENT OF THE INTERIOR
BUREAU OF LAND MANAGEMENT


RECEIVED
JUL 29 1960
STATE ENGINEER

SECTION _____

Oregon State Water Filings

TOWNSHIP 28S, RANGE 13, W. M.

North

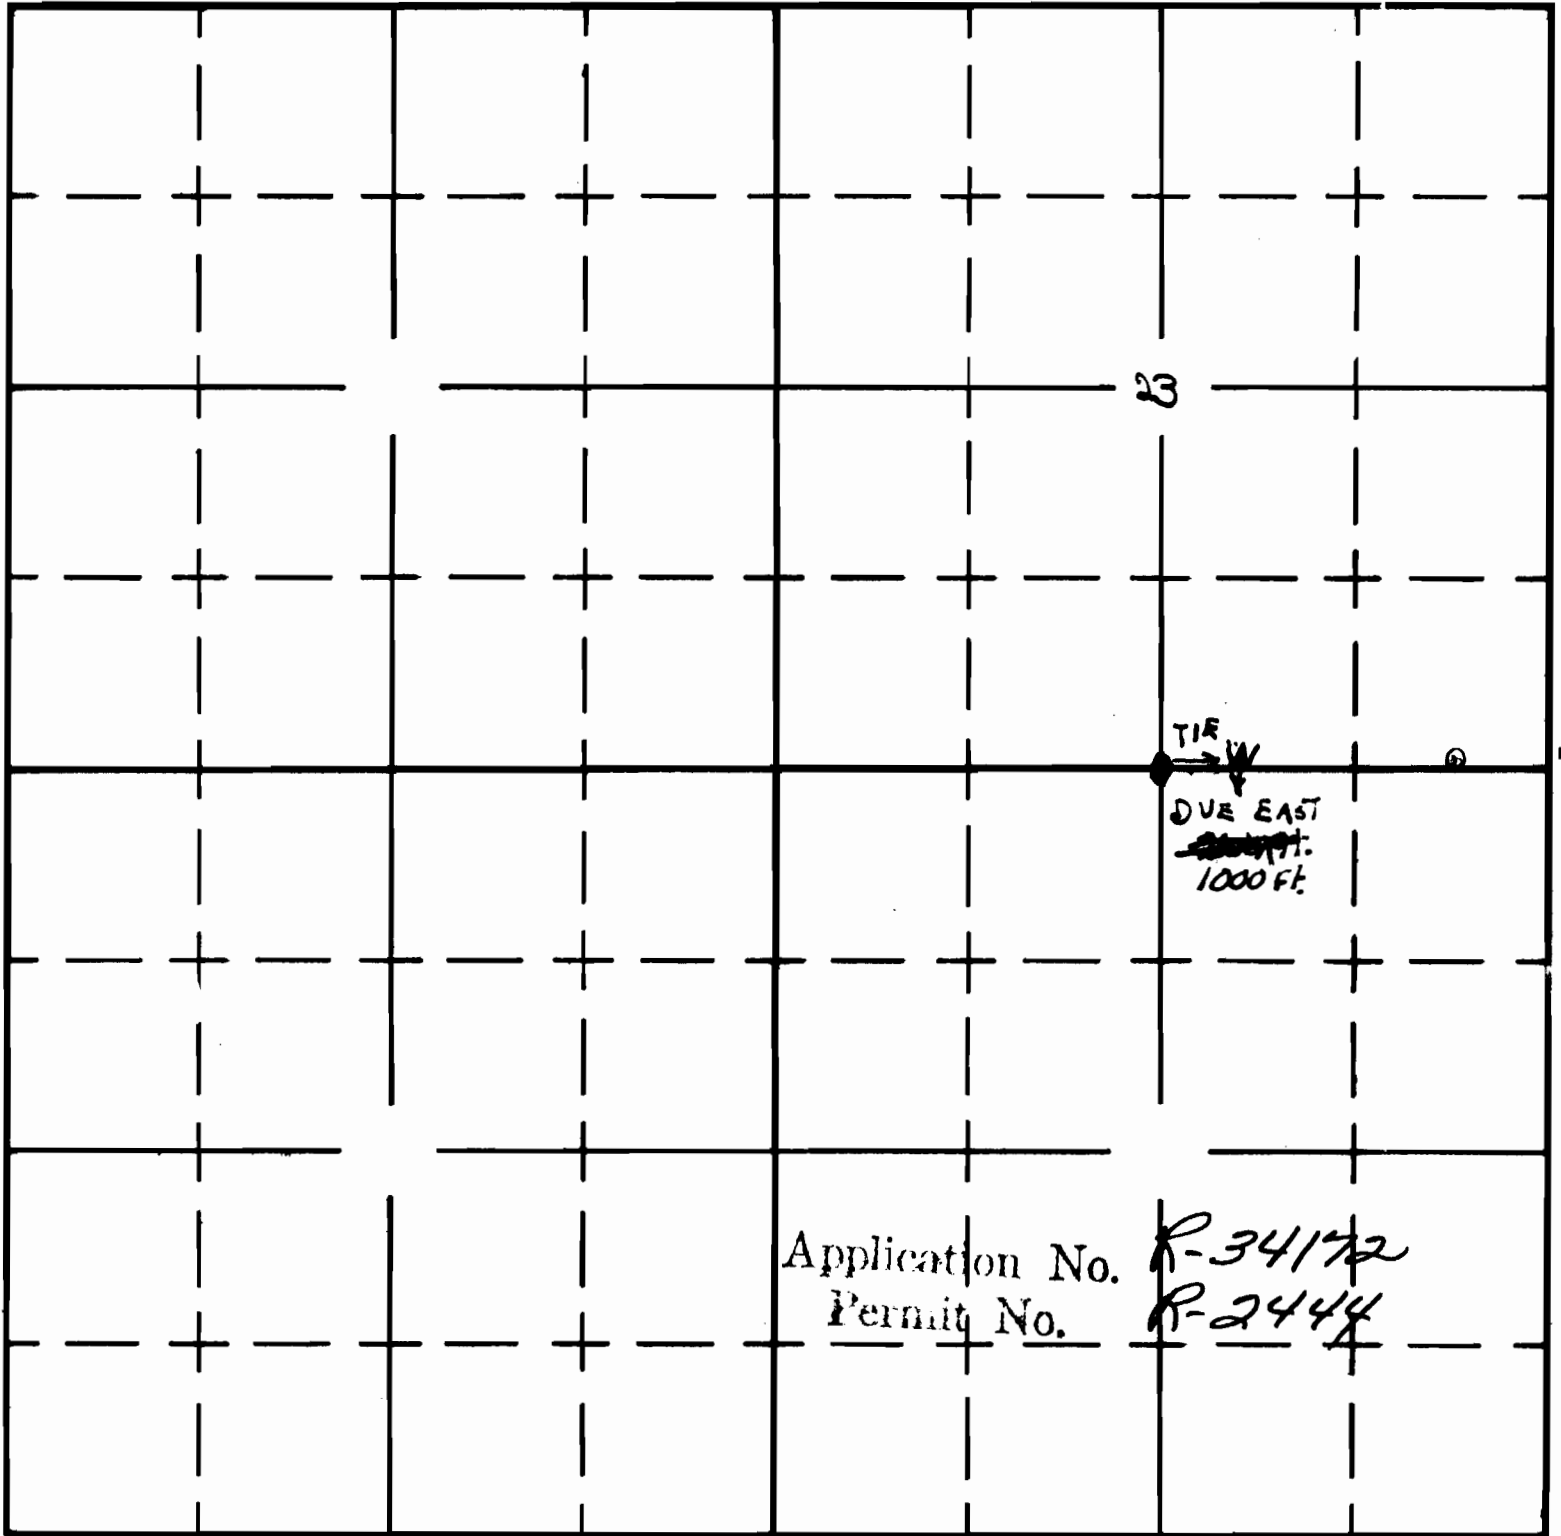

Application No. R-34172

Permit No. R-2444

◆ FOUND SURVEY CORNER

South

W PROJECT

APPLICATION No.

PERMIT No.