

UNITED STATES
DEPARTMENT OF THE INTERIOR
BUREAU OF LAND MANAGEMENT


SECTION

Oregon State Water Filings

TOWNSHIP 28S, RANGE 13E, W. M.

JUL 29 1960

North LONELY RESERVOIR

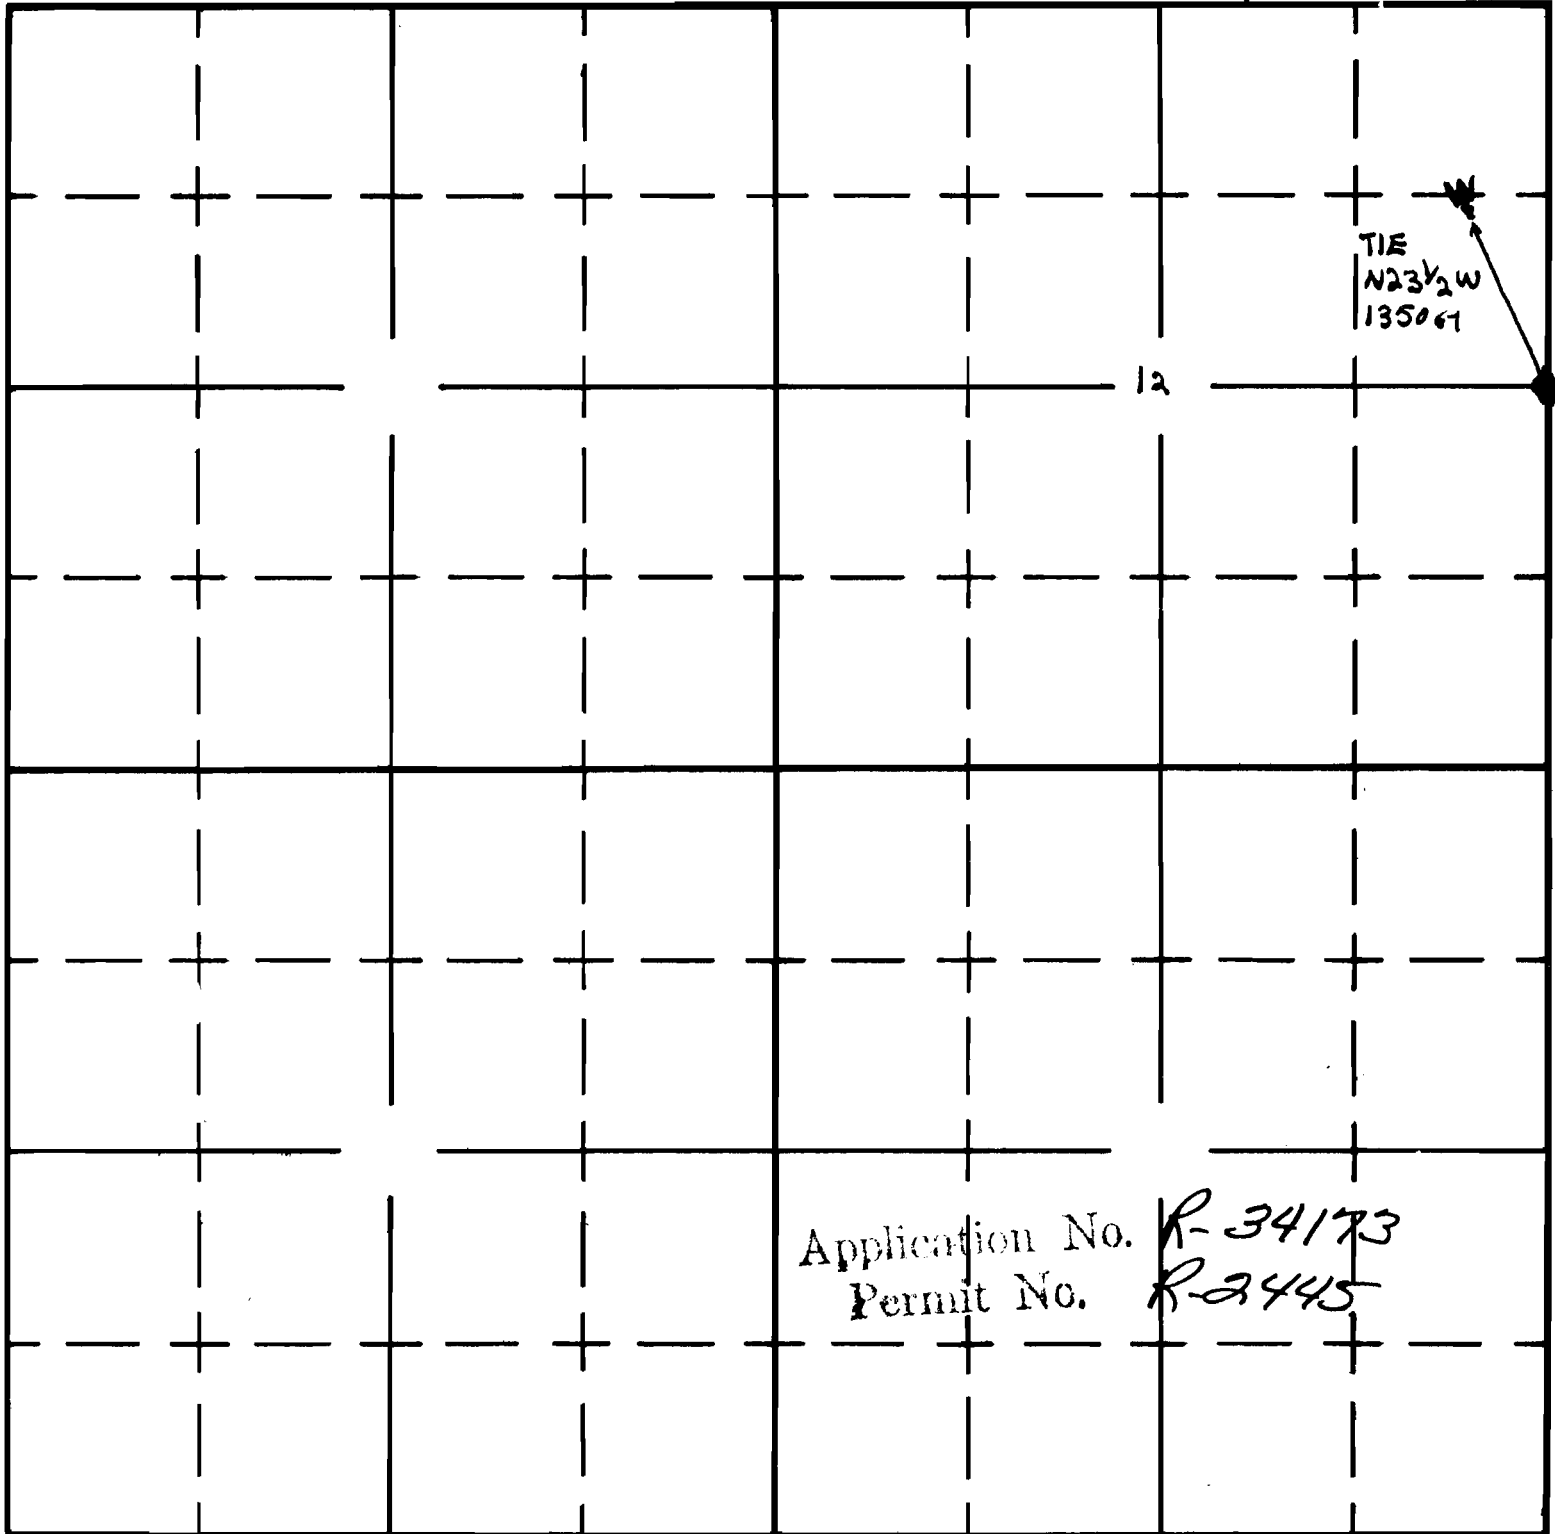

Application No. R-34173
Permit No. R-2445

◆ FOUND SURVEY CORNER

South

W PROJECT

APPLICATION No.
PERMIT No.