

UNITED STATES
DEPARTMENT OF THE INTERIOR
BUREAU OF LAND MANAGEMENT


SECTION

Oregon State Water Filings

TOWNSHIP 29S, RANGE 13E, W. M.

JUL 29 1960

North

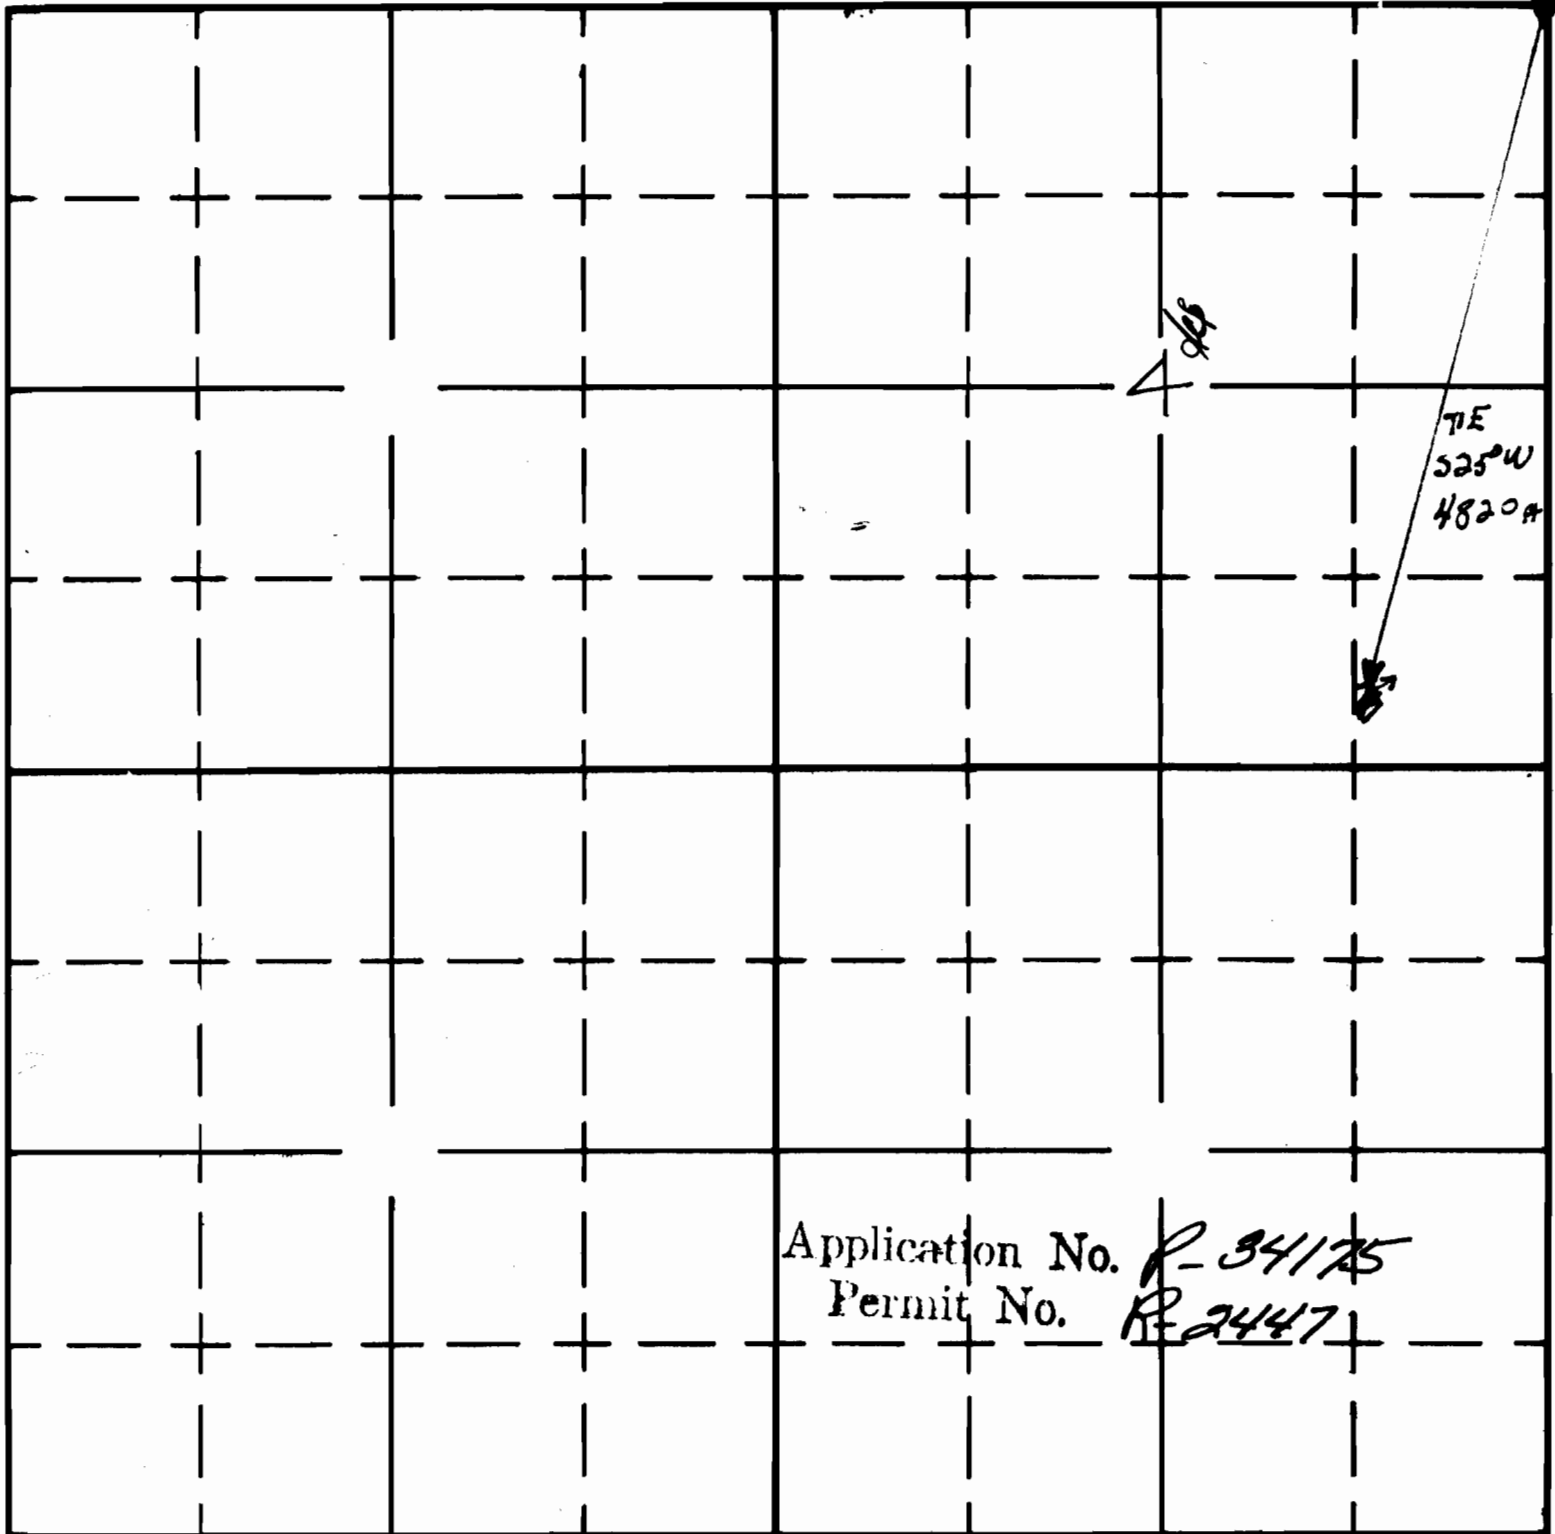

◆ FOUND SURVEY CORNER

South

W PROJECT

APPLICATION No.

PERMIT No.