


UNITED STATES
DEPARTMENT OF THE INTERIOR
BUREAU OF LAND MANAGEMENT

SECTION _____

Oregon State Water Filings

TOWNSHIP 28 S, RANGE 14 E, W. M.

North AIRSTRIP RESERVOIR

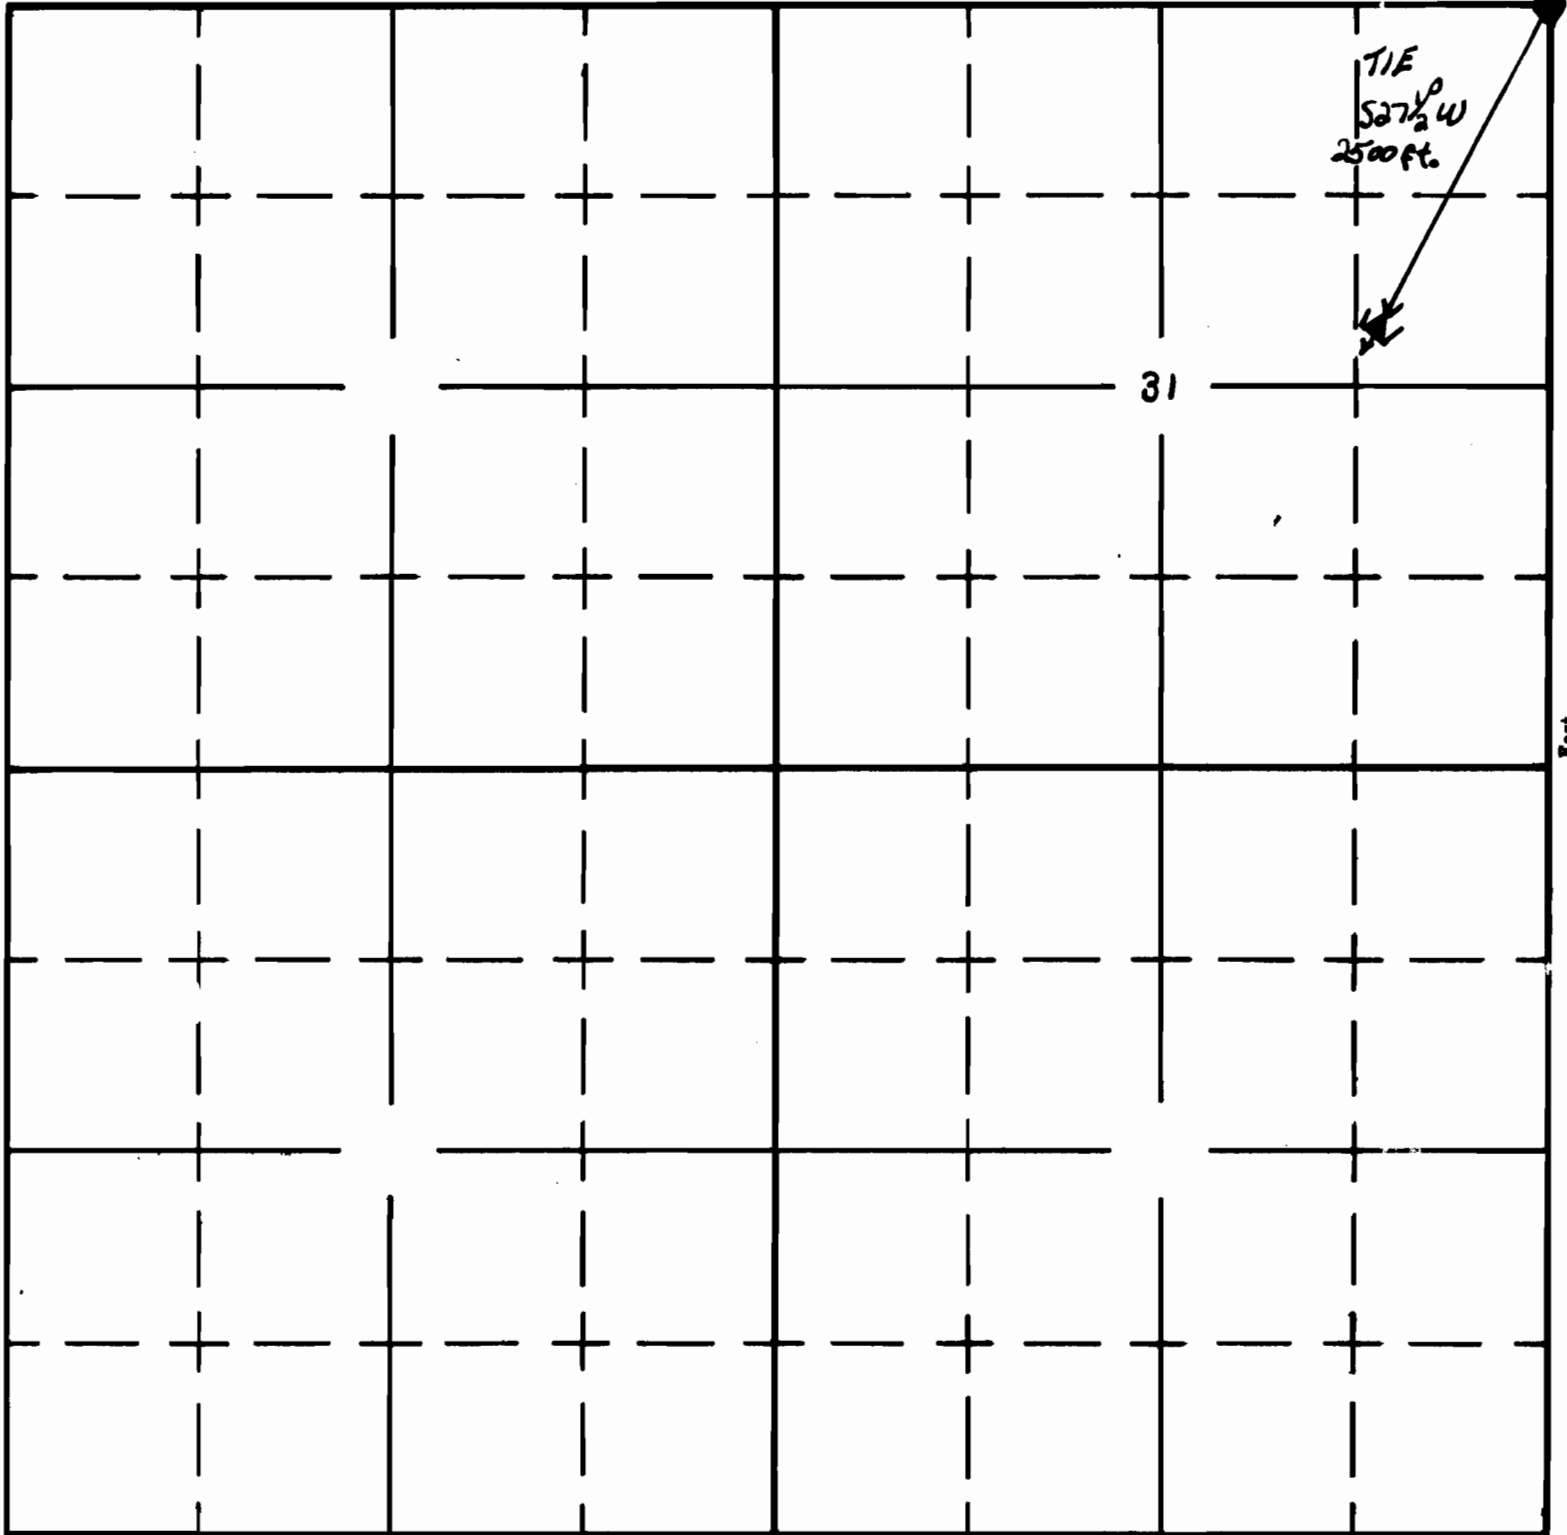

◆ FOUND SECTION CORNER Application No. R-34231
PROJECT Permit No. R-2483

APPLICATION No.
PERMIT No.