


UNITED STATES
DEPARTMENT OF THE INTERIOR
BUREAU OF LAND MANAGEMENT

SECTION _____

Oregon State Water Filings

TOWNSHIP 29S, RANGE 13E, W. M.

North BASALT RESERVOIR

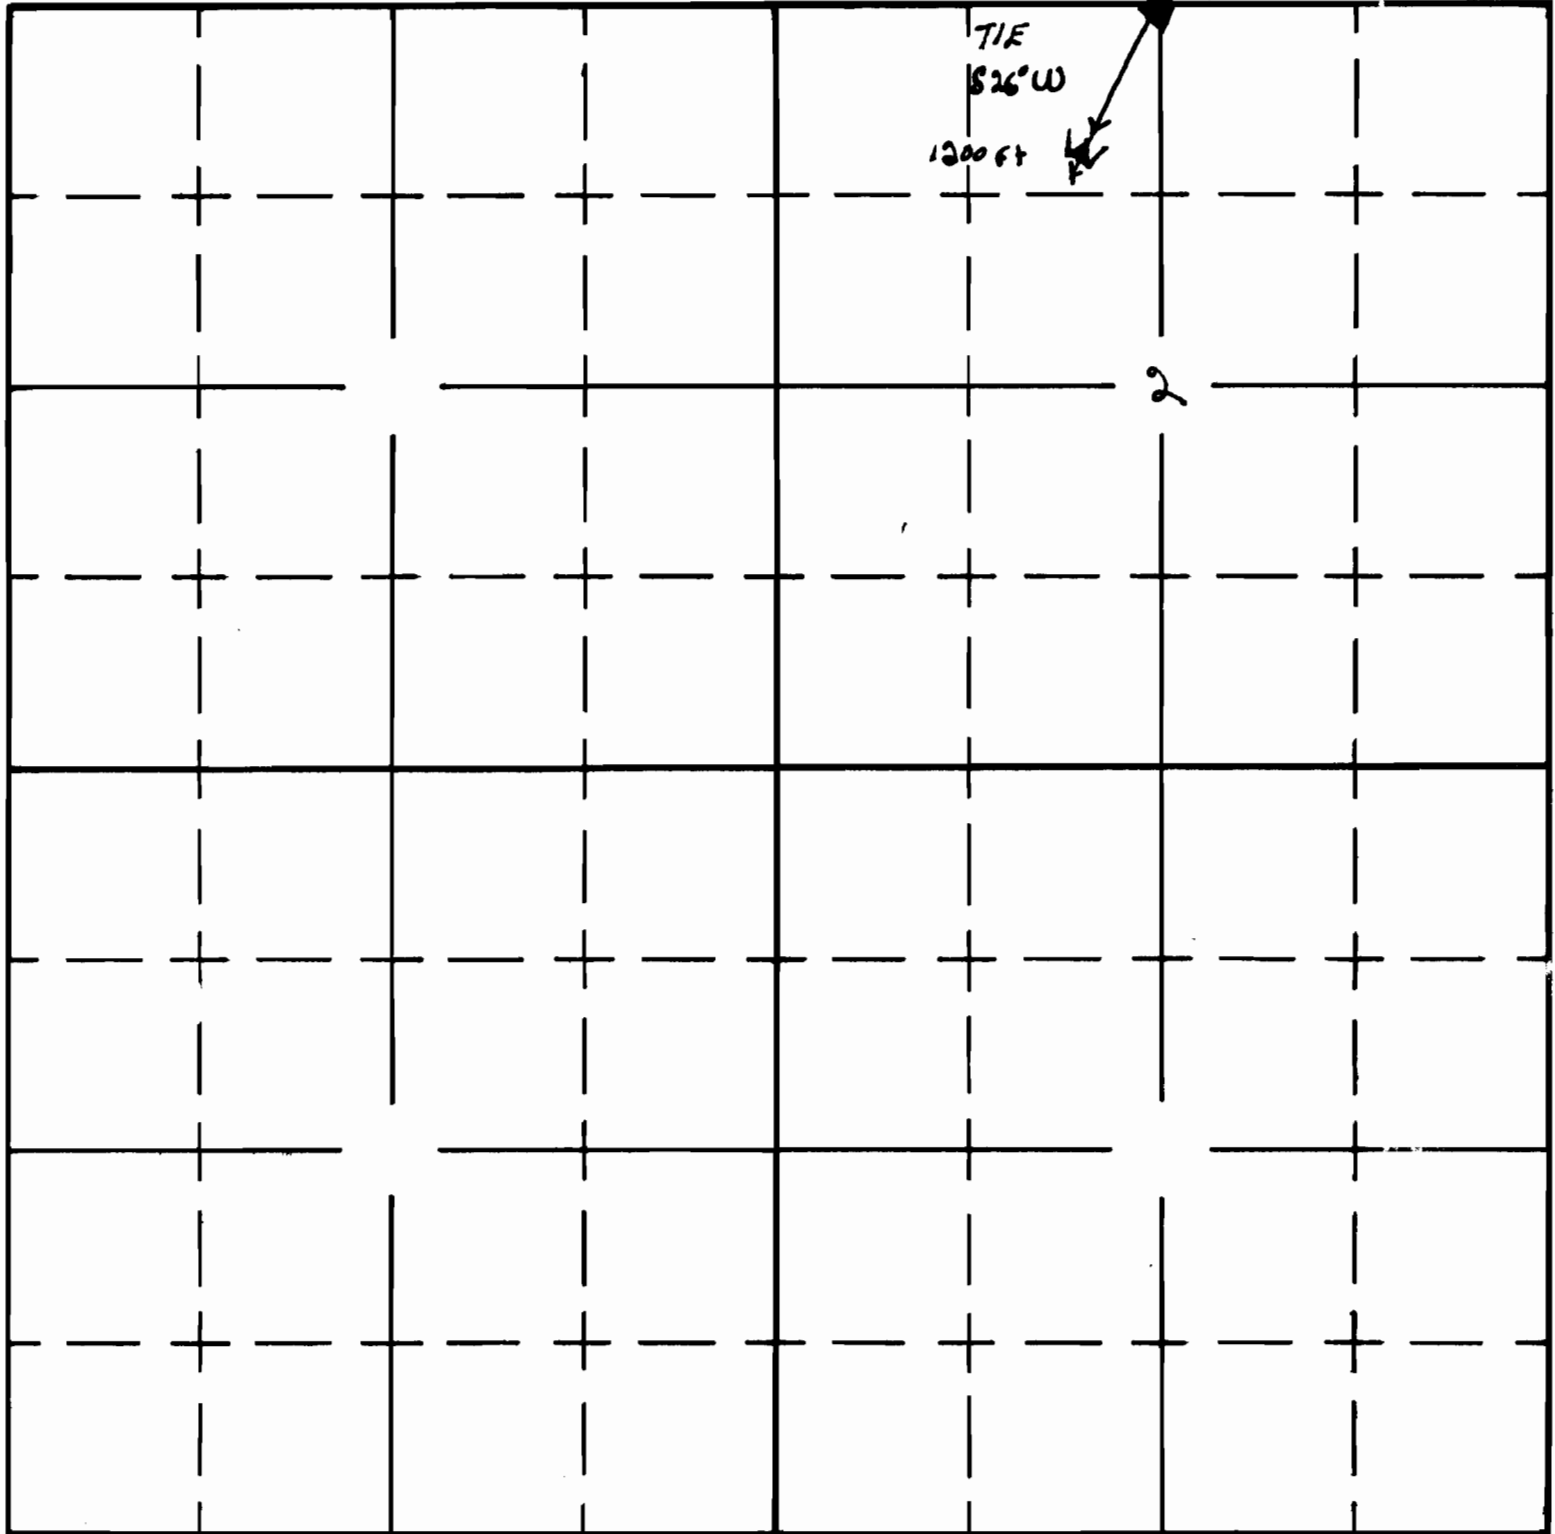

◆ FOUND SURVEY CORNER Application No. R-34232 APPLICATION No.
PROJECT Permit No. R-2484 PERMIT No.