


UNITED STATES
DEPARTMENT OF THE INTERIOR
BUREAU OF LAND MANAGEMENT

SECTION _____

Oregon State Water Filings

TOWNSHIP 29S, RANGE 13E, W. M.

North Rocky Waterhole

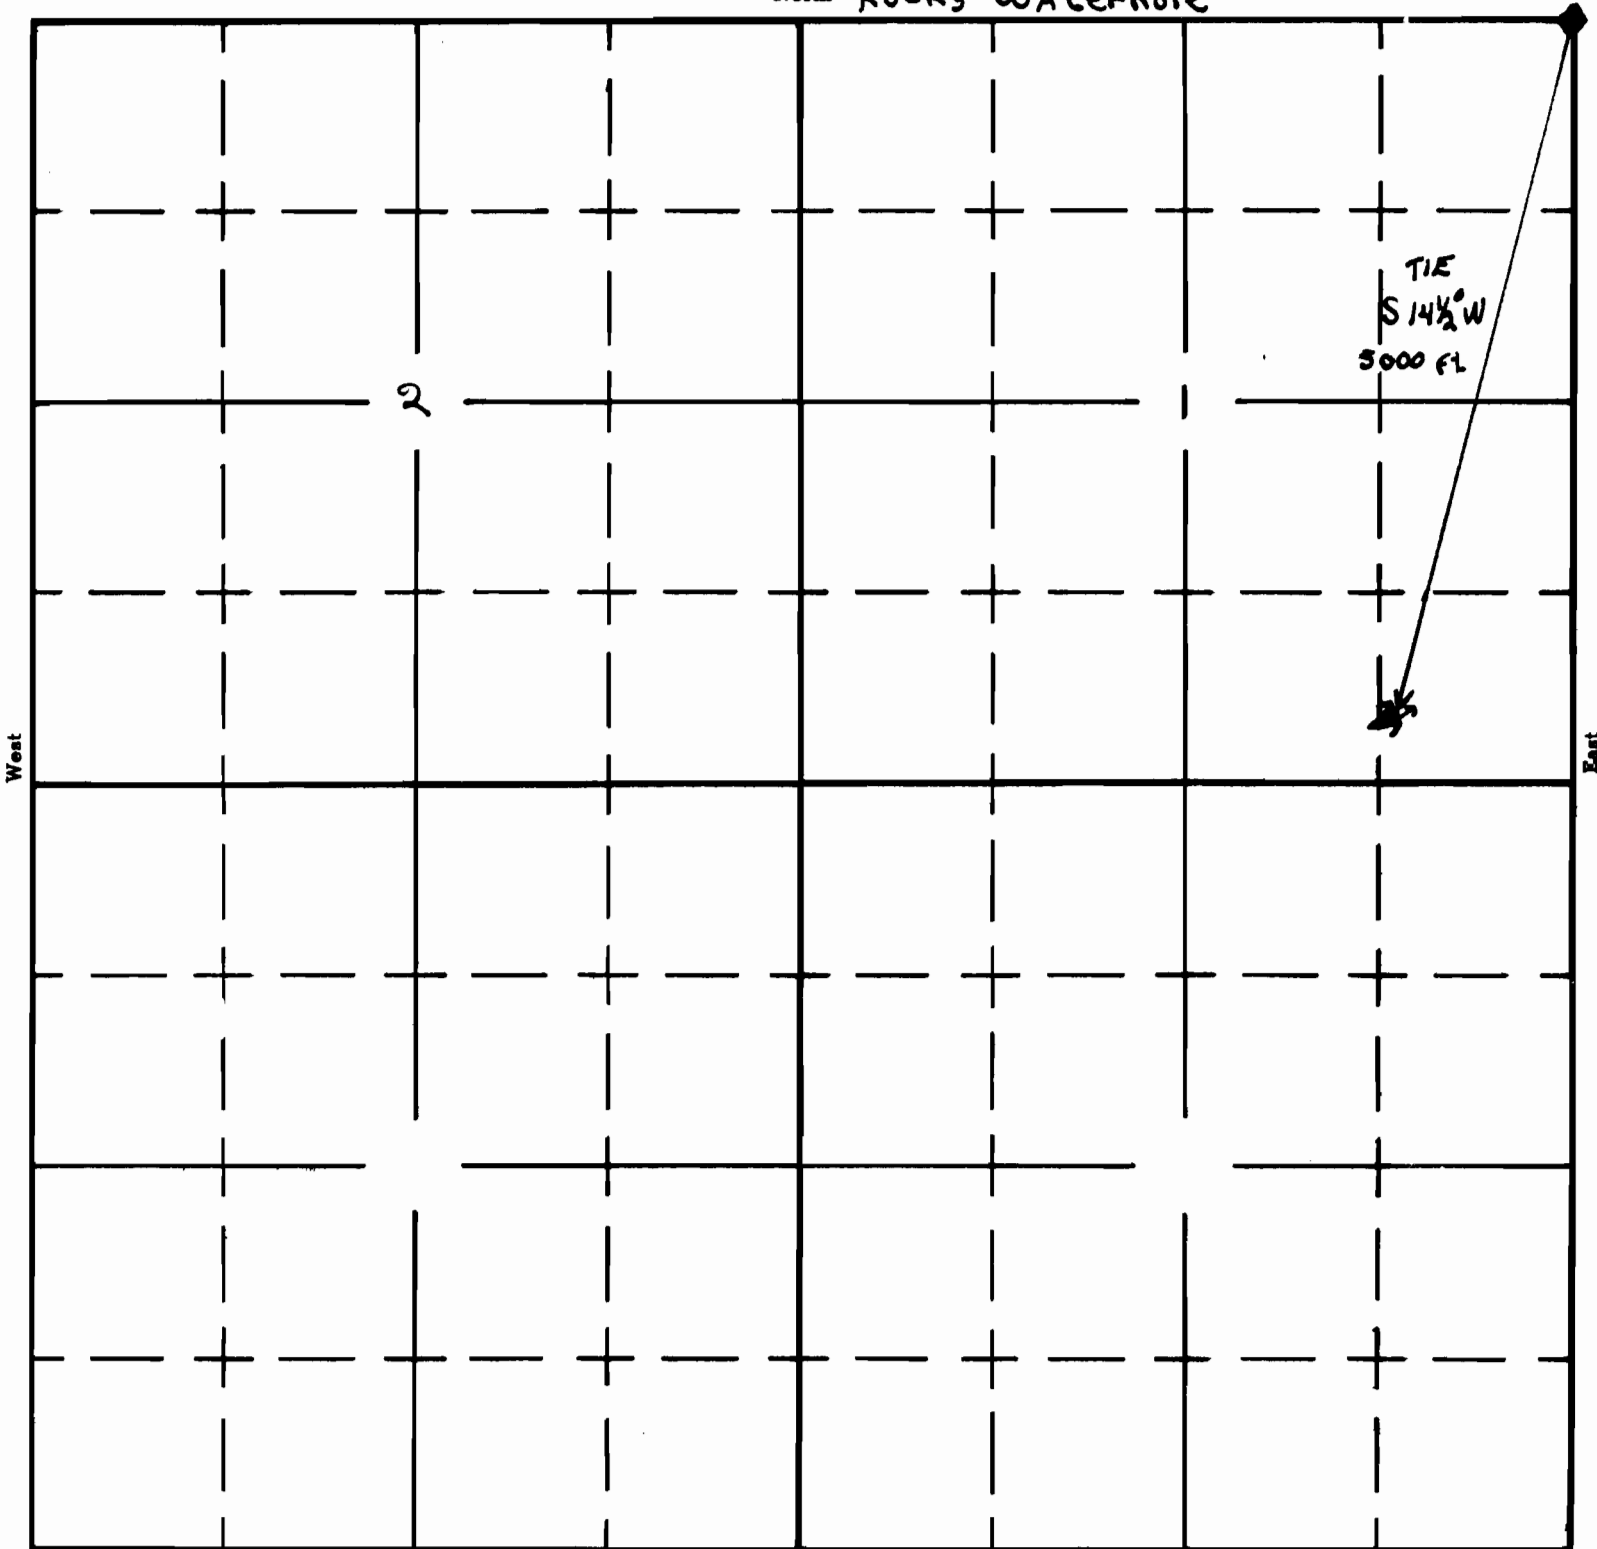

◆ FOUND SURVEY CORNER Application No. R-34235

▼ PROJECT

Permit No. R-2487

APPLICATION No.

PERMIT No.