


UNITED STATES
DEPARTMENT OF THE INTERIOR
BUREAU OF LAND MANAGEMENT

SECTION

Oregon State Water Filings

TOWNSHIP 29S, RANGE 14E, W. M.

North HAGADORN WATERHOLE RECONSTRUCTION

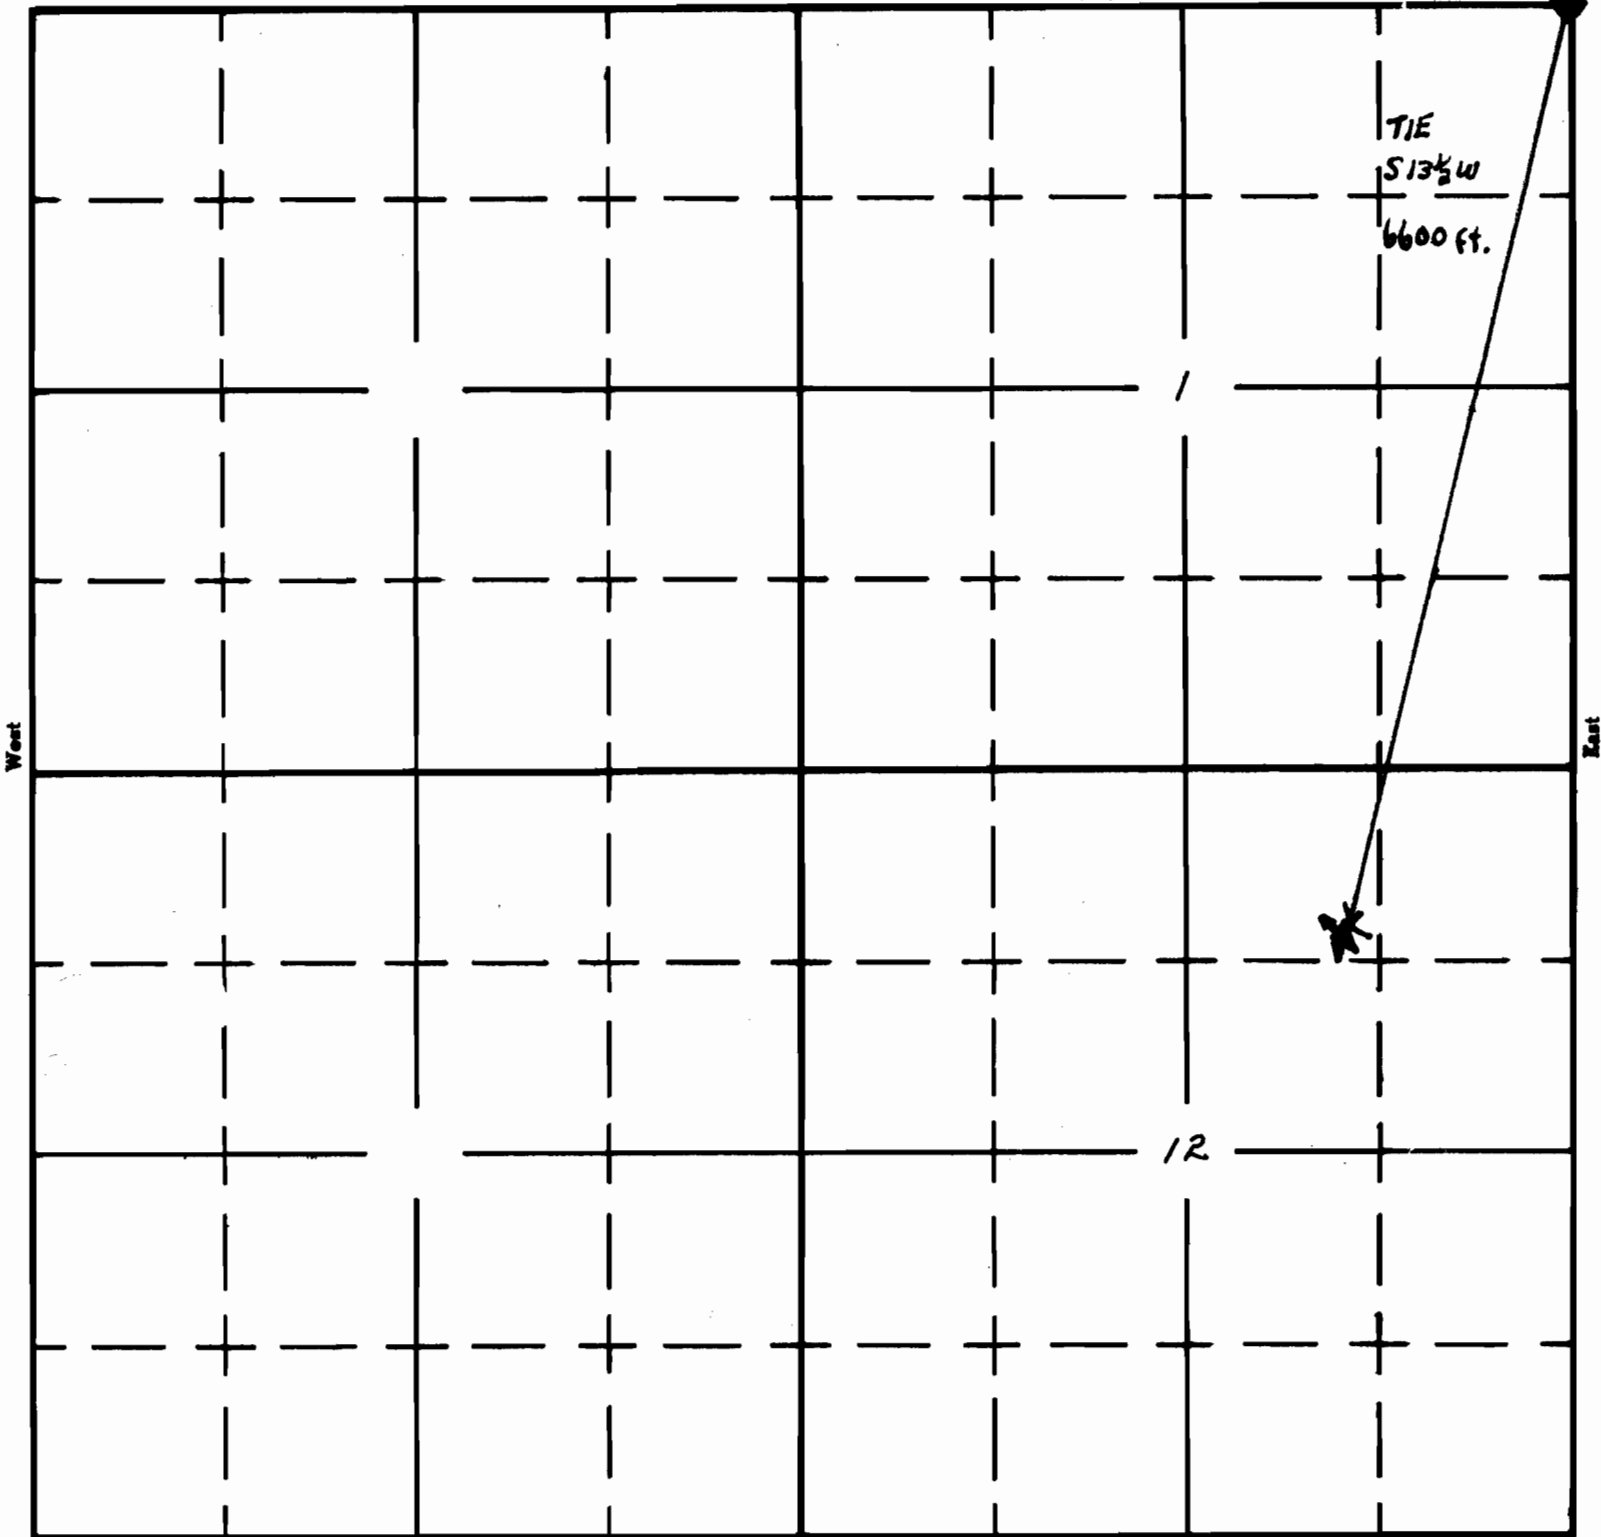

◆ FOUND SURVEY CORNER Application No. R-34236 APPLICATION No.
PROJECT Permit No. R-2488 PERMIT No.