

UNITED STATES  
DEPARTMENT OF THE INTERIOR  
BUREAU OF LAND MANAGEMENT


RECEIVED  
SEP 2 1966  
STATE ENGINEER  
SALMON DIVISION

SECTION


TOWNSHIP 29S, RANGE 14E, W. M.

North BUNCHGRASS WATERHOLE

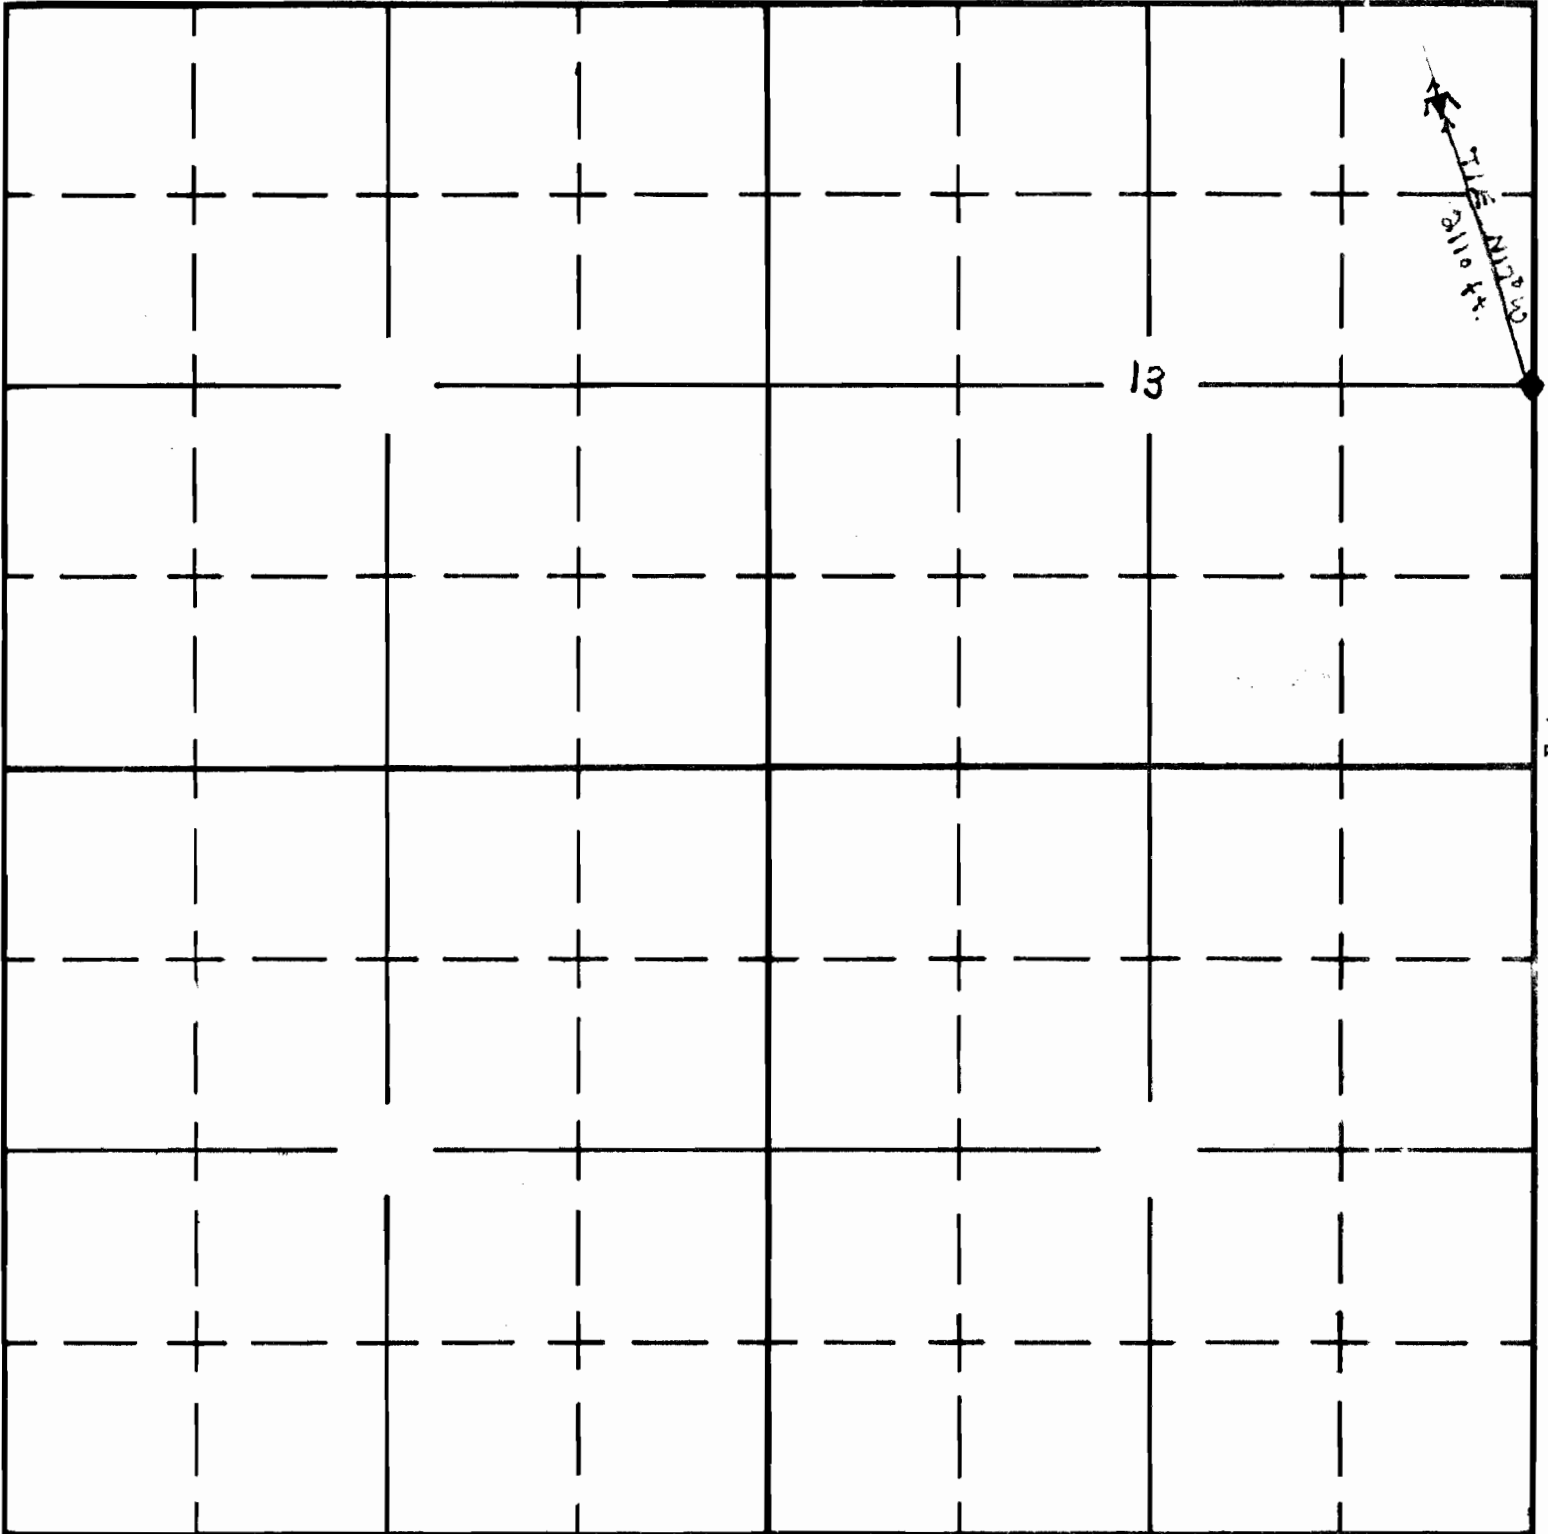

FOUND SURVEY CORNER

South

PROJECT

APPLICATION No. R-34366

PERMIT No. R-2540