

UNITED STATES
DEPARTMENT OF THE INTERIOR
BUREAU OF LAND MANAGEMENT


RECEIVED
STATE ENGINEER
JAN 10 1960

SECTION _____

Oregon State Water Filings

TOWNSHIP 29S, RANGE 14E, W. M.

North HERDER SPRING WATERHOLE

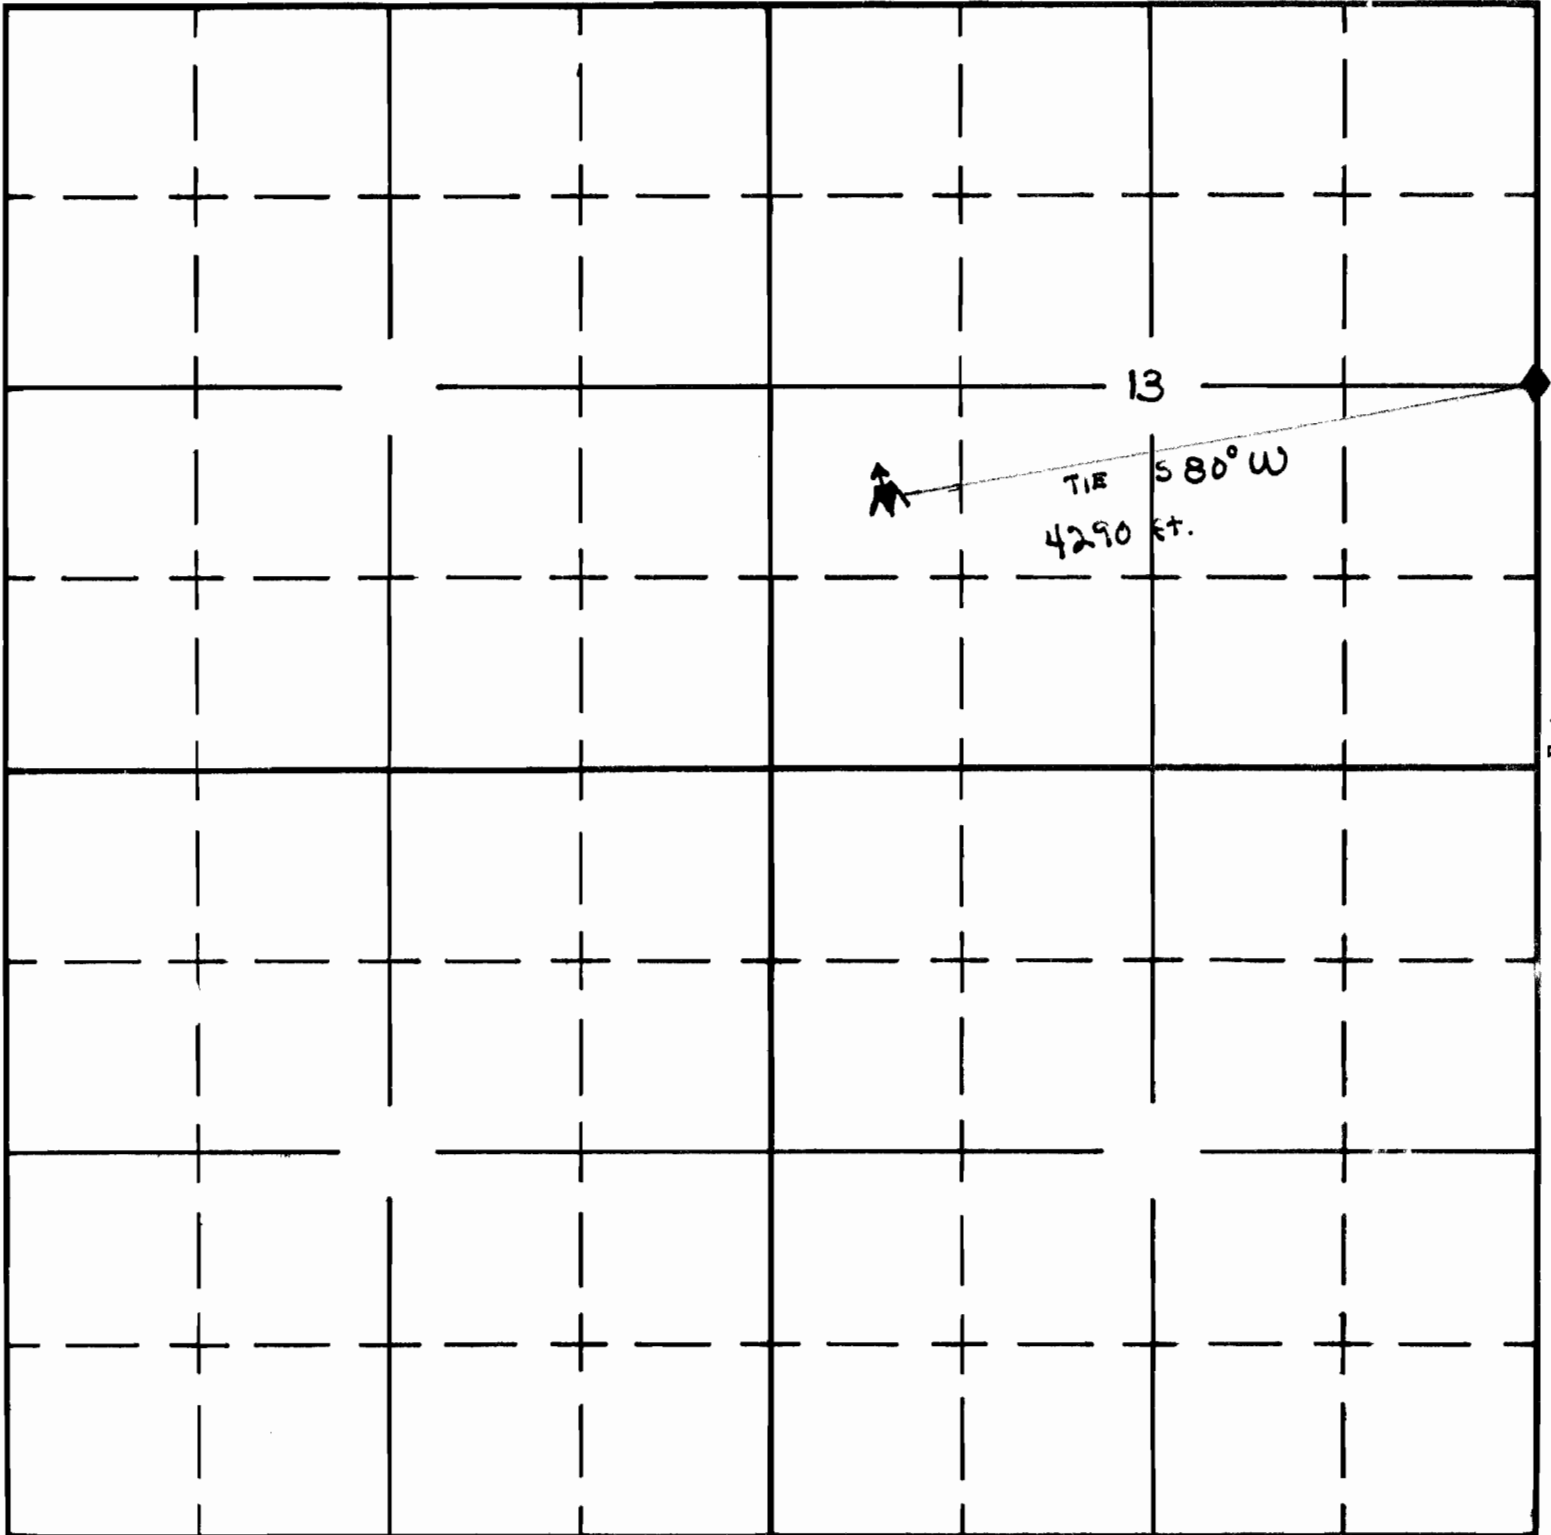

◆ FOUND SURVEY CORNER

South

▼ PROJECT

APPLICATION No. R-34367
PERMIT No. R-2541