


UNITED STATES
DEPARTMENT OF THE INTERIOR
BUREAU OF LAND MANAGEMENT

SECTION

Oregon State Water Filings

TOWNSHIP 29S, RANGE 15E, W. M.

North SKEEFE WATERHOLE RECONSTRUCTION

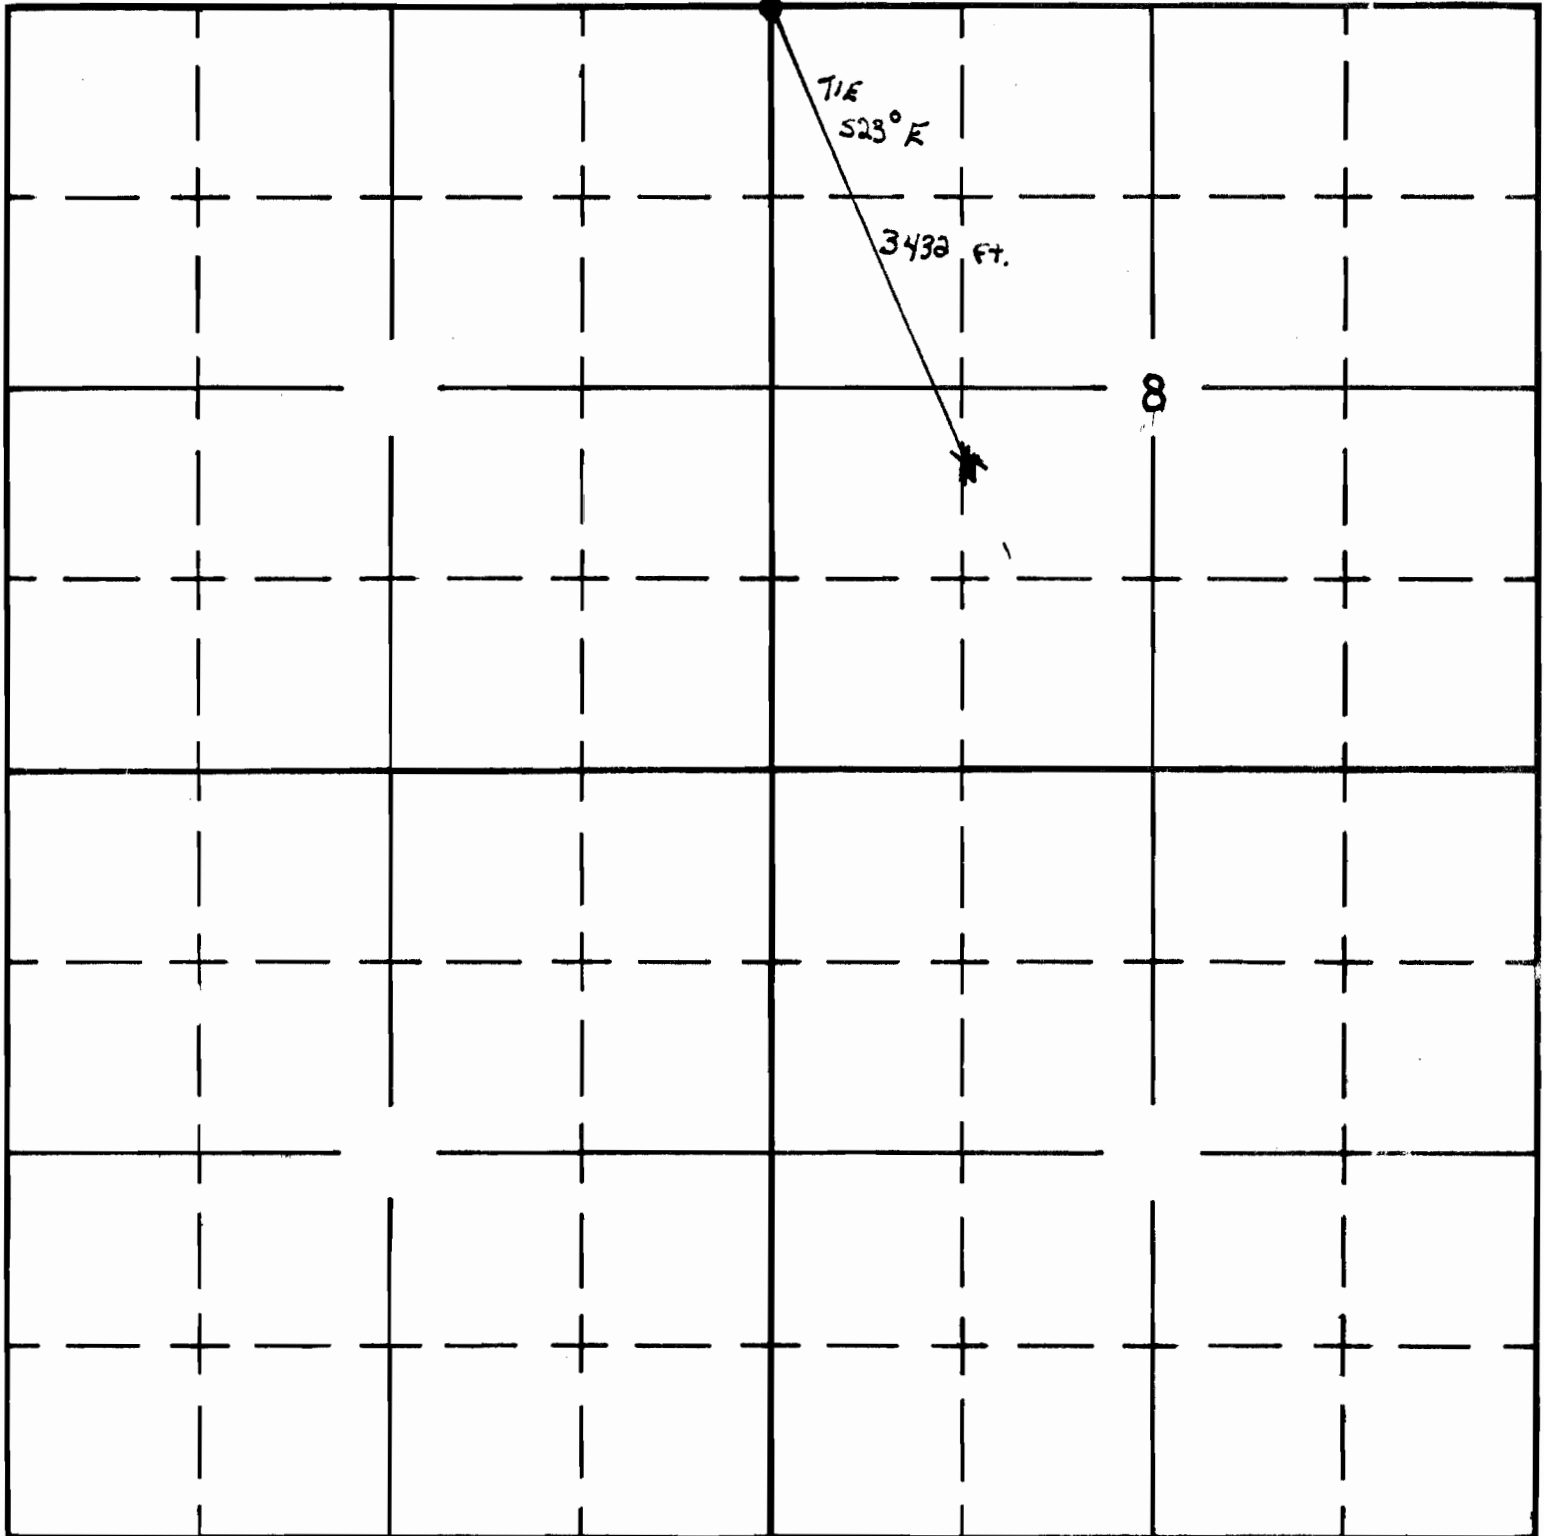

◆ FOUND SURVEY CORNER

South

W PROJECT

APPLICATION No. R-34371
PERMIT No. R-2545